


9-00-085-113-008

9-00-085-B

SCAN # 46597

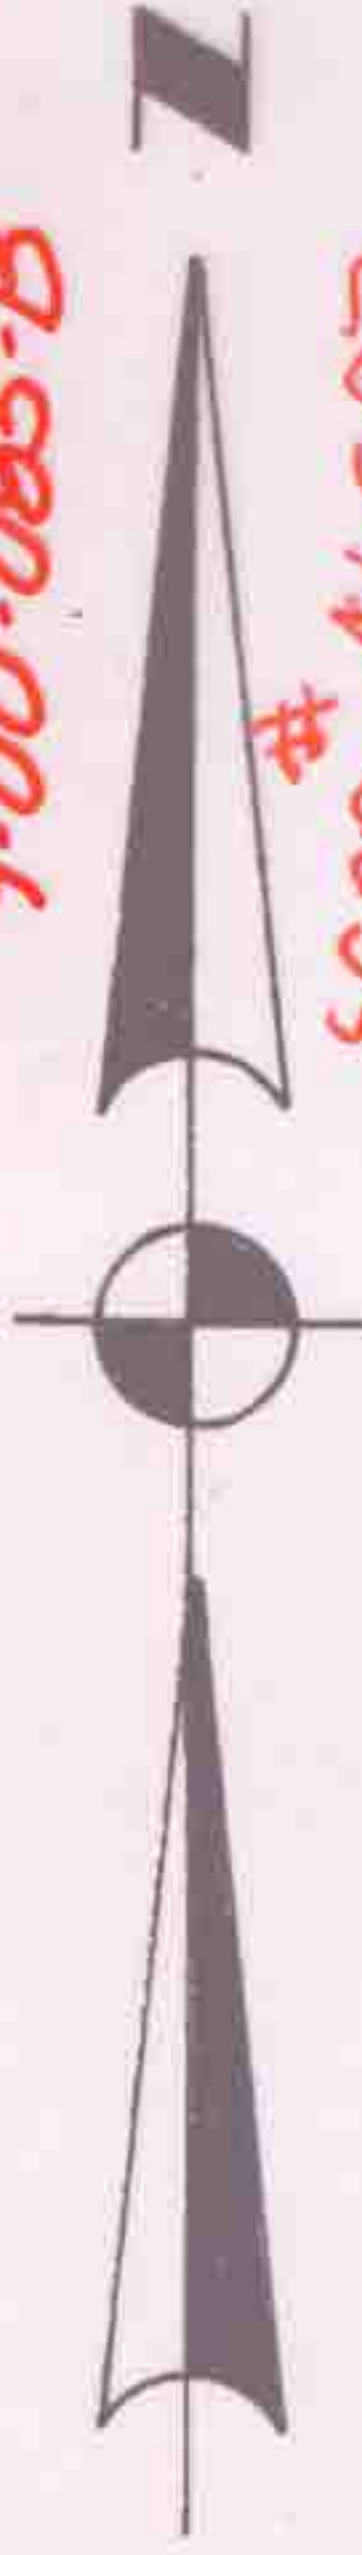

PROFESSOR ST. 60'

WEST VINE ST. 49.50'

I.P.Fd.

I.P.Fd.

I.P.Fd.

I.P.Fd. 3.75' E.

85' Rec. 84.75 m.

I.P.Fd. 0.25' N.

43' Rec. 43.85' m.

I.P.Fd. in roof 0.40' S. of R

125.15' m.

I.P.Fd. used

50.10' m. 50' Rec.

86°-09' obs.

125.81' m.

50' Rec. & m.

I.P.Fd. used

I.P.Fd. 2.02' E.

164.75'

180°-0' I.P.Fd.

FOREST ST.

SOUTH

I.P.Fd. 2.20' E.

Survey for

ROBERT M. THOMPSON

PART OF 5/L 2 of SWIFT ADDN. P.V. 3 PG. 8
CITY OF OBERLIN - LORAIN COUNTY - OHIO

SCALE 1"=40'

SEPT. 1976

LAUNDON • SIMON • CAHL & ASSOC.

ENGINEERS

SURVEYORS

FOREST ST.