



Scan # 46599

9-00-086-102-061
9-00-086-102-084
9-00-086-A

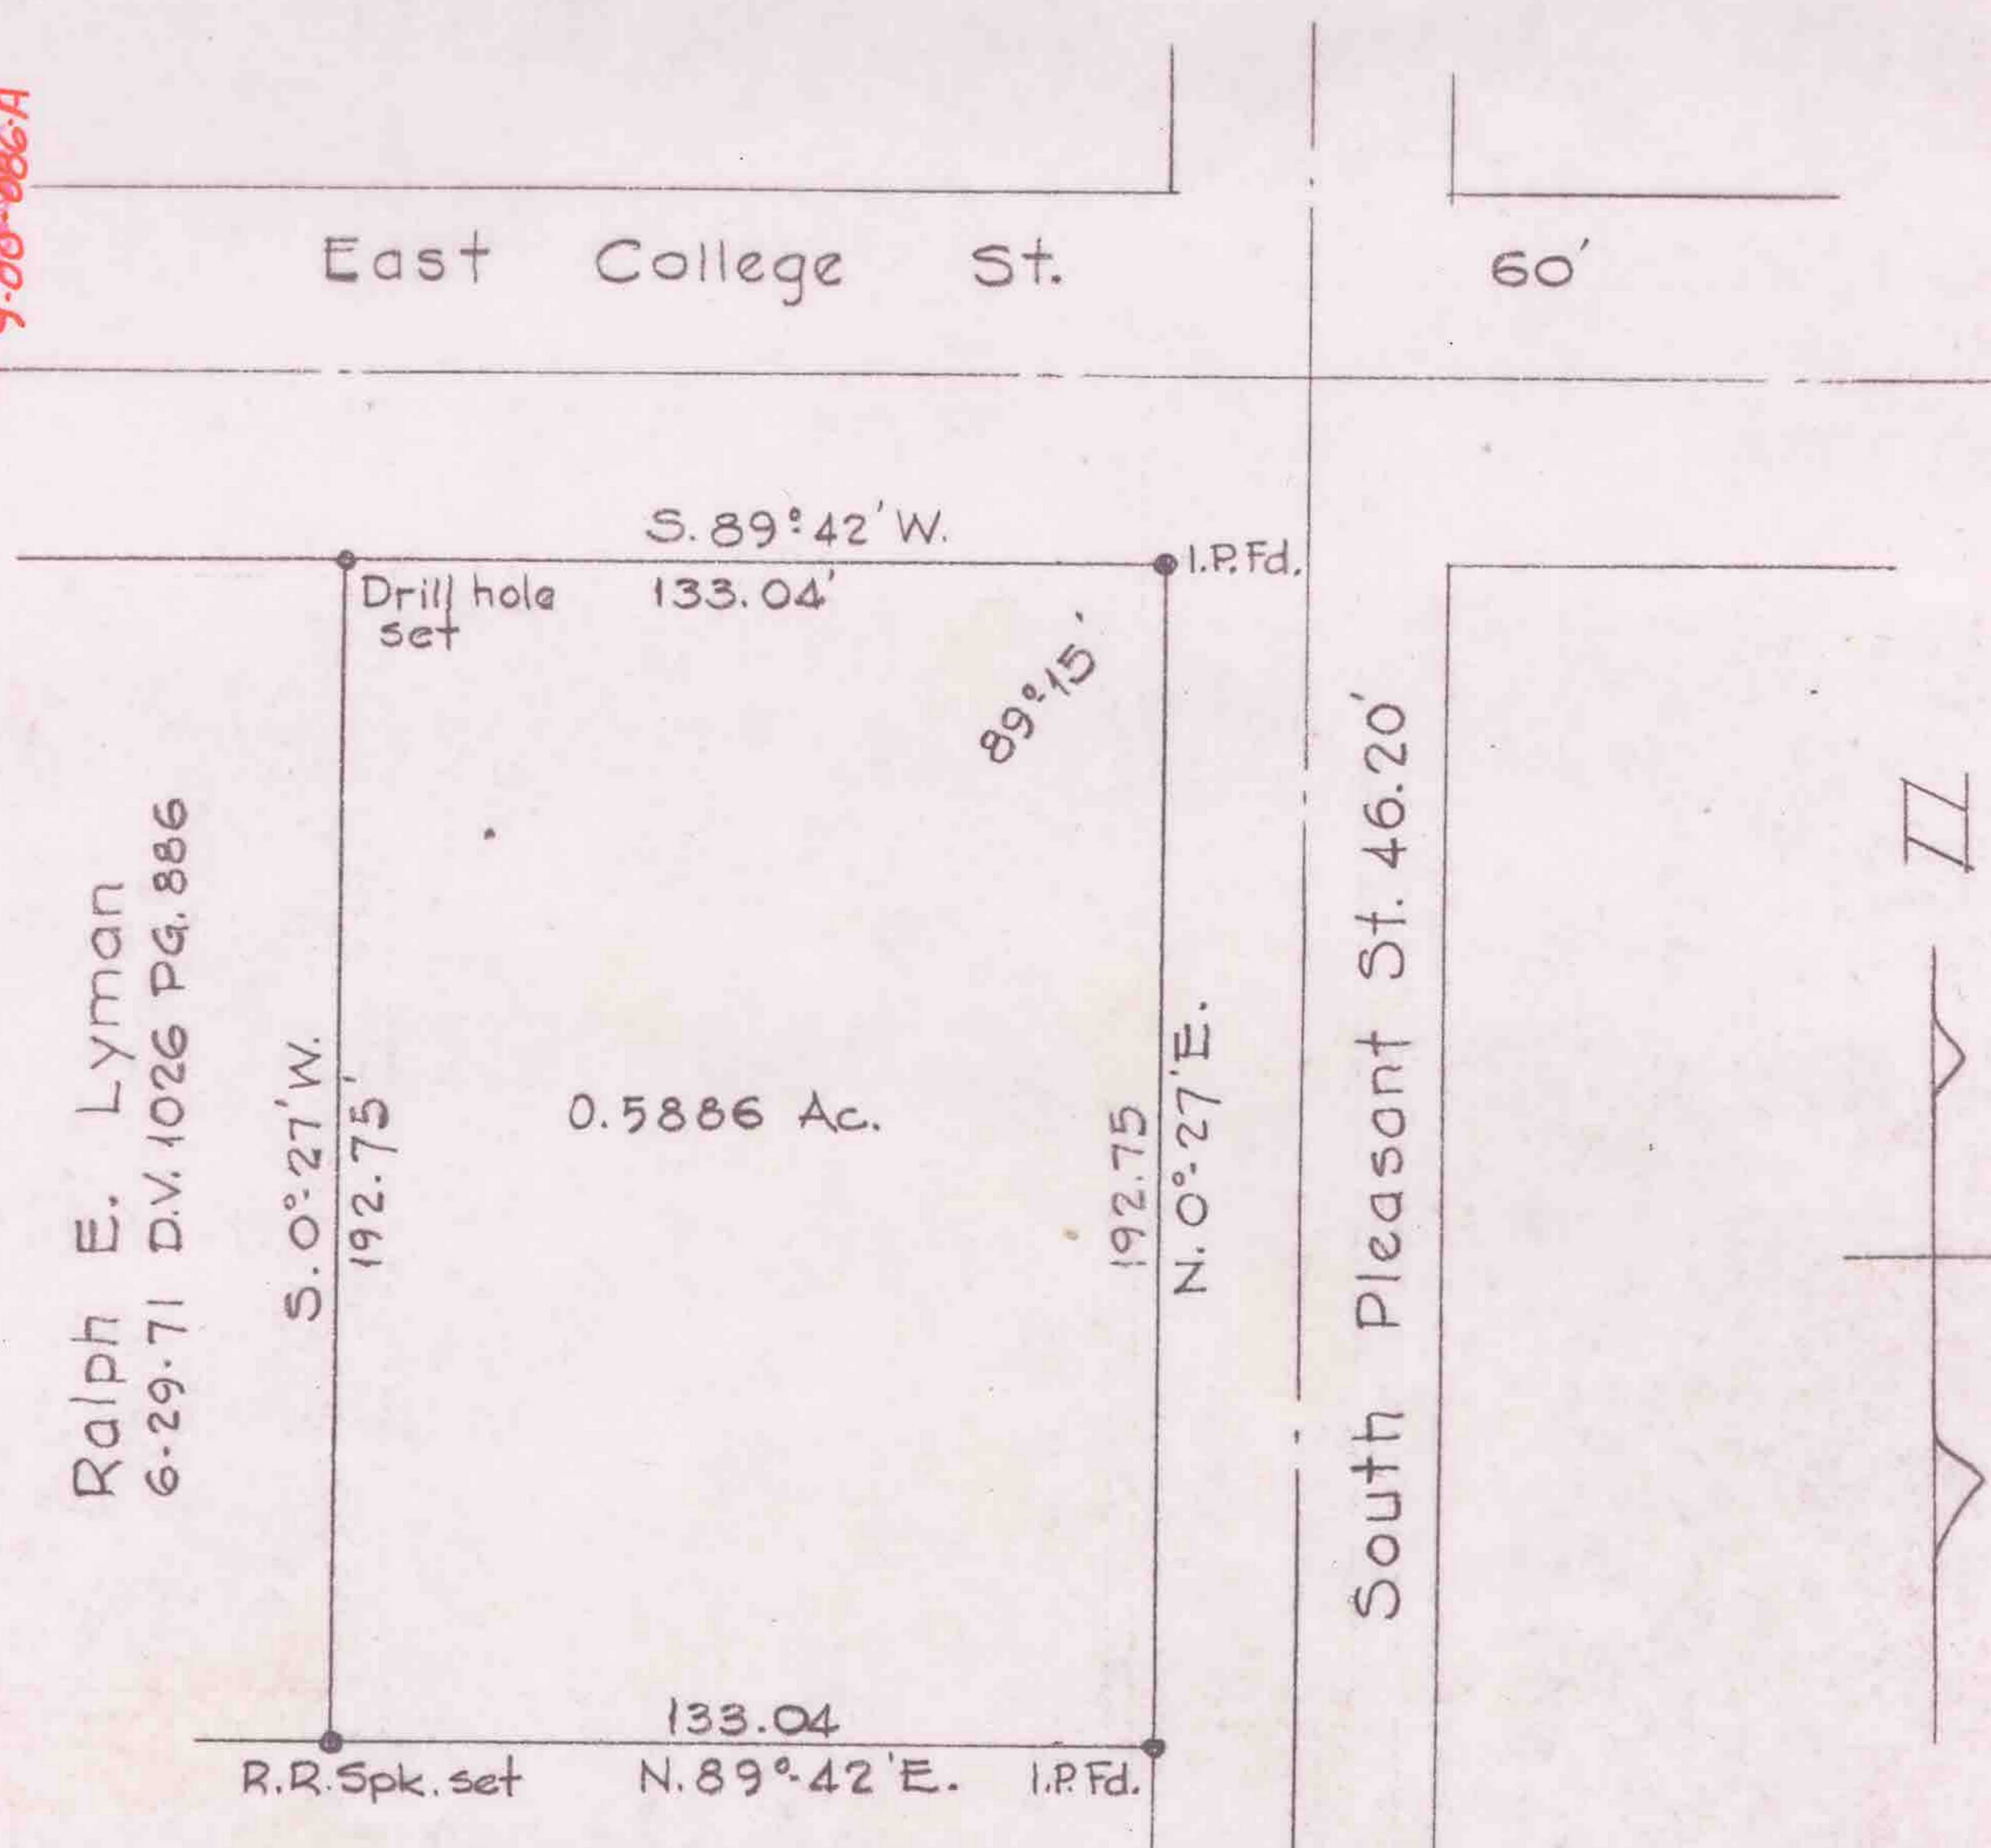

Ralph E. Lyman
6-29-71 D.V. 1026 PG. 886

W. D. & S. S. Hobbs
10-26-14 DV. 133-PG. 477

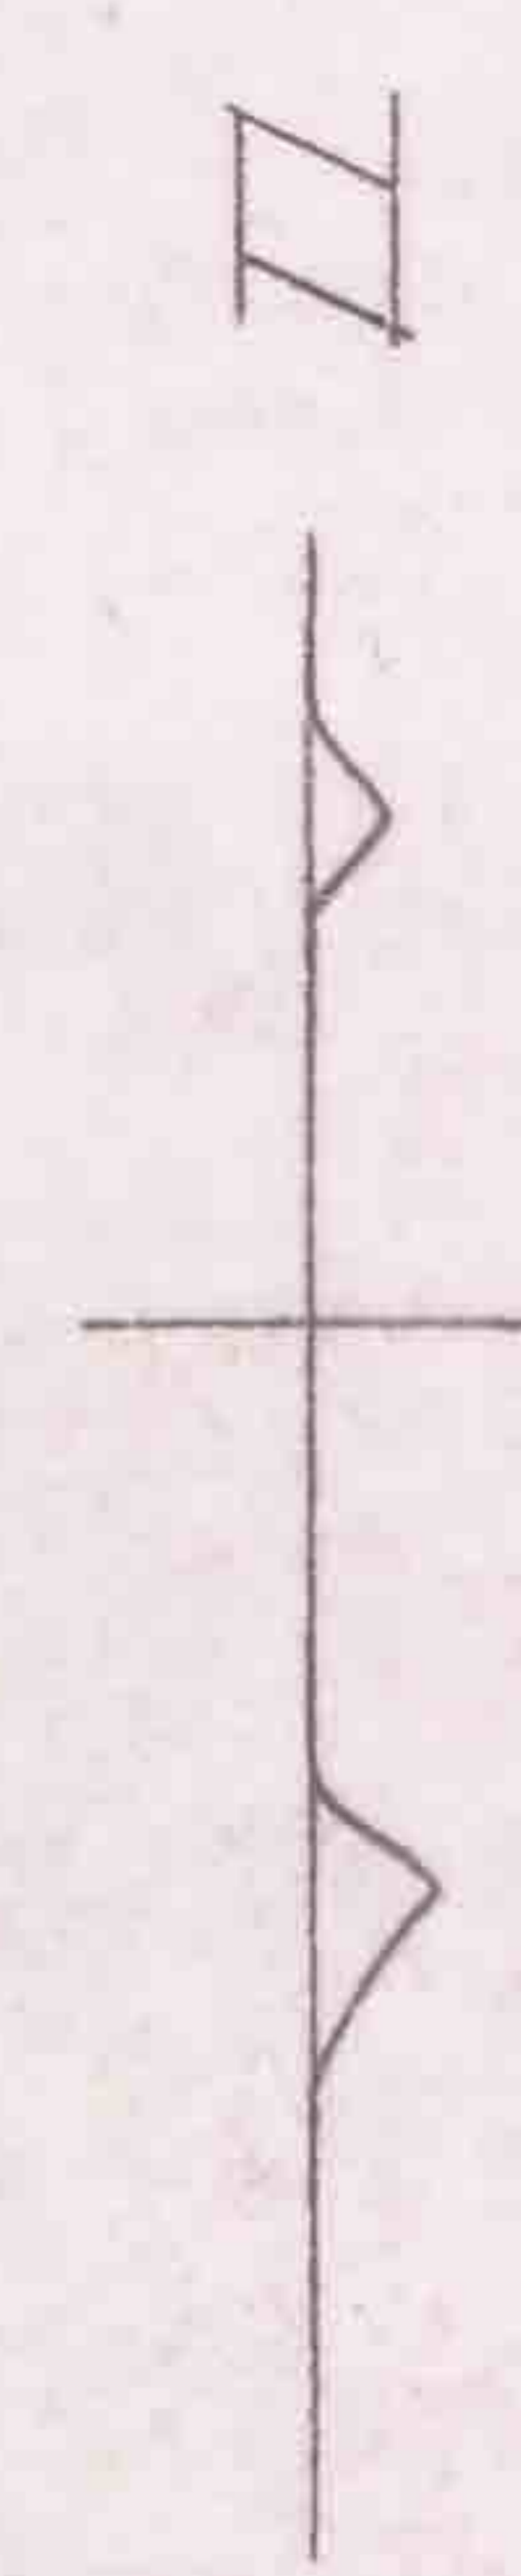

Survey for Food Plex Inc.

O.L. 86 Russia Twp. - Orig. Vill. Plat Vol. 5 Pg. 30
 County of Lorain State of Ohio
 Scale 1" = 50' June 4, 1973
 Laundon • Simon • Cahl & Assoc. Inc.
 Engineers & Surveyors