


9-00-086-104-008
 9-00-086-104-009
 9-00-086-A
 Sheet # 44 of 60

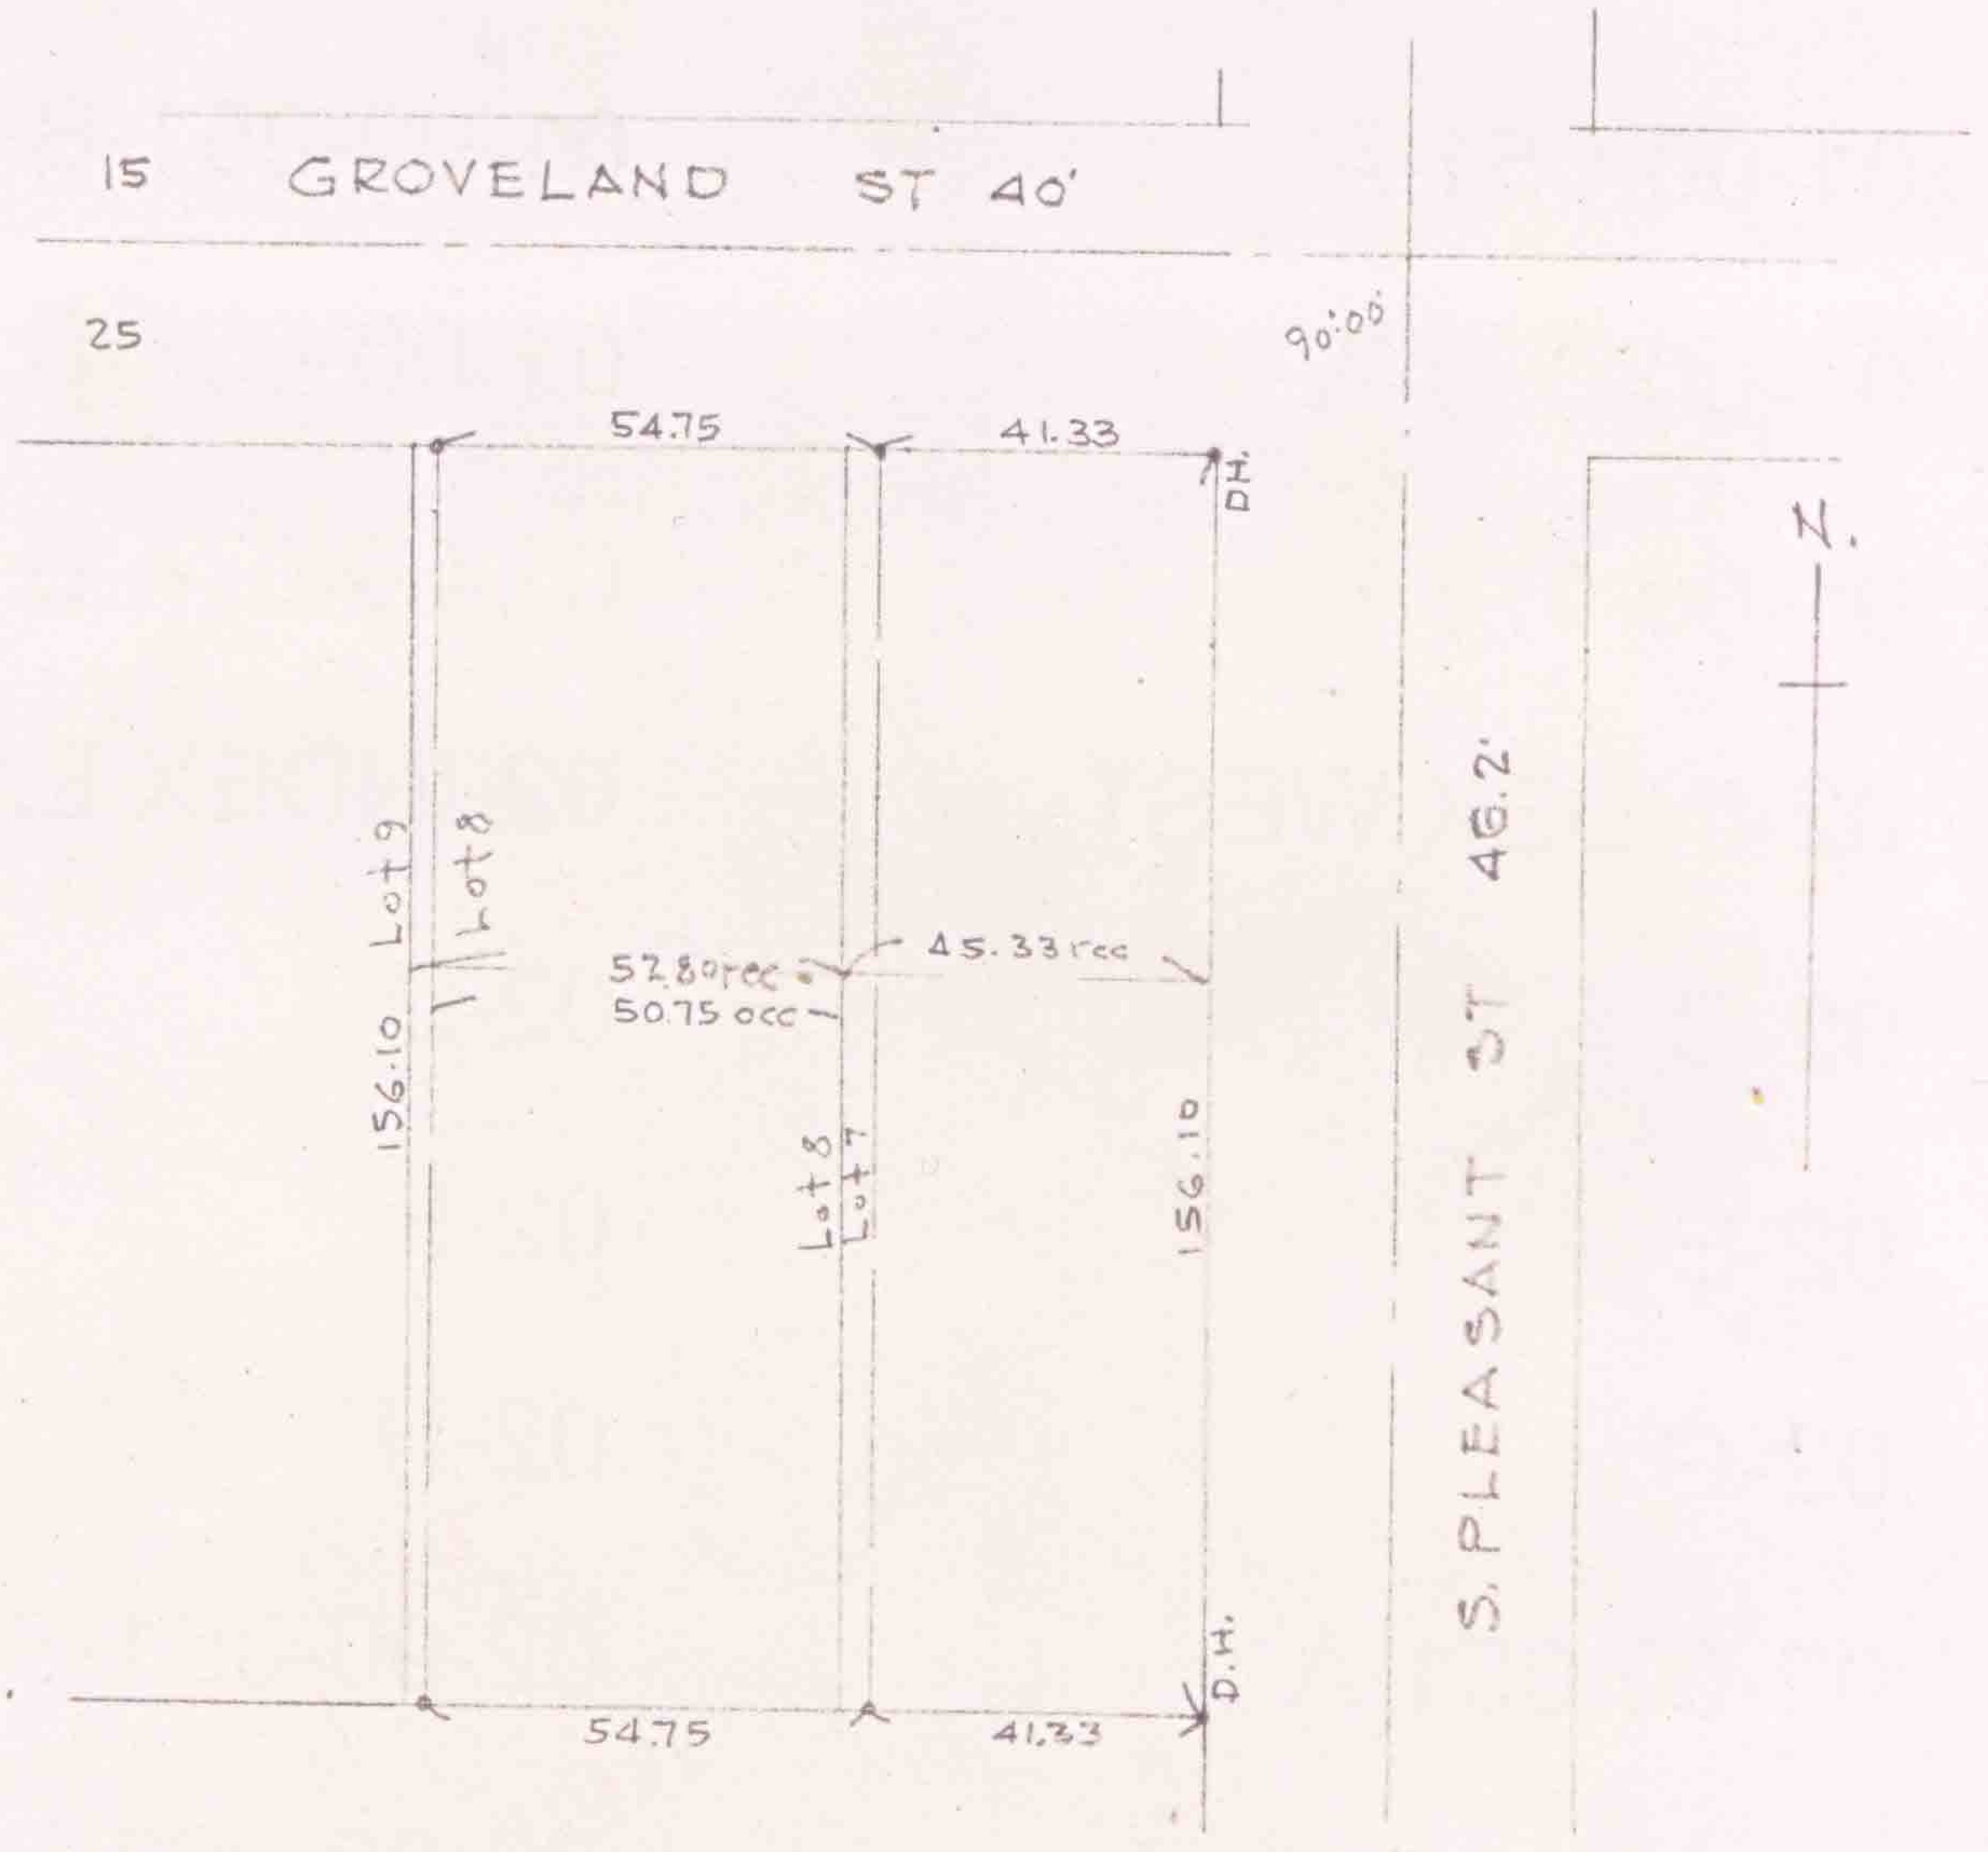

SURVEY FOR HARRY VAN AUSDALE
 LOTS 7 & 8 MERRILL & LYMAN ADDN
 P.V. 1-29 OBERLIN-LORAIN CO. OHIO
 SCALE 1"=40' JUNE 1962
 LAUNDON & HUFFMAN, SURVEYORS.

D.H. - Drill hole in walk.