


9-00-086-105-001  
9-00-086-A  
SCAN # 46602  
SCAN

E. LORAIN ST. 66'

N. PLEASANT ST. 49.50'

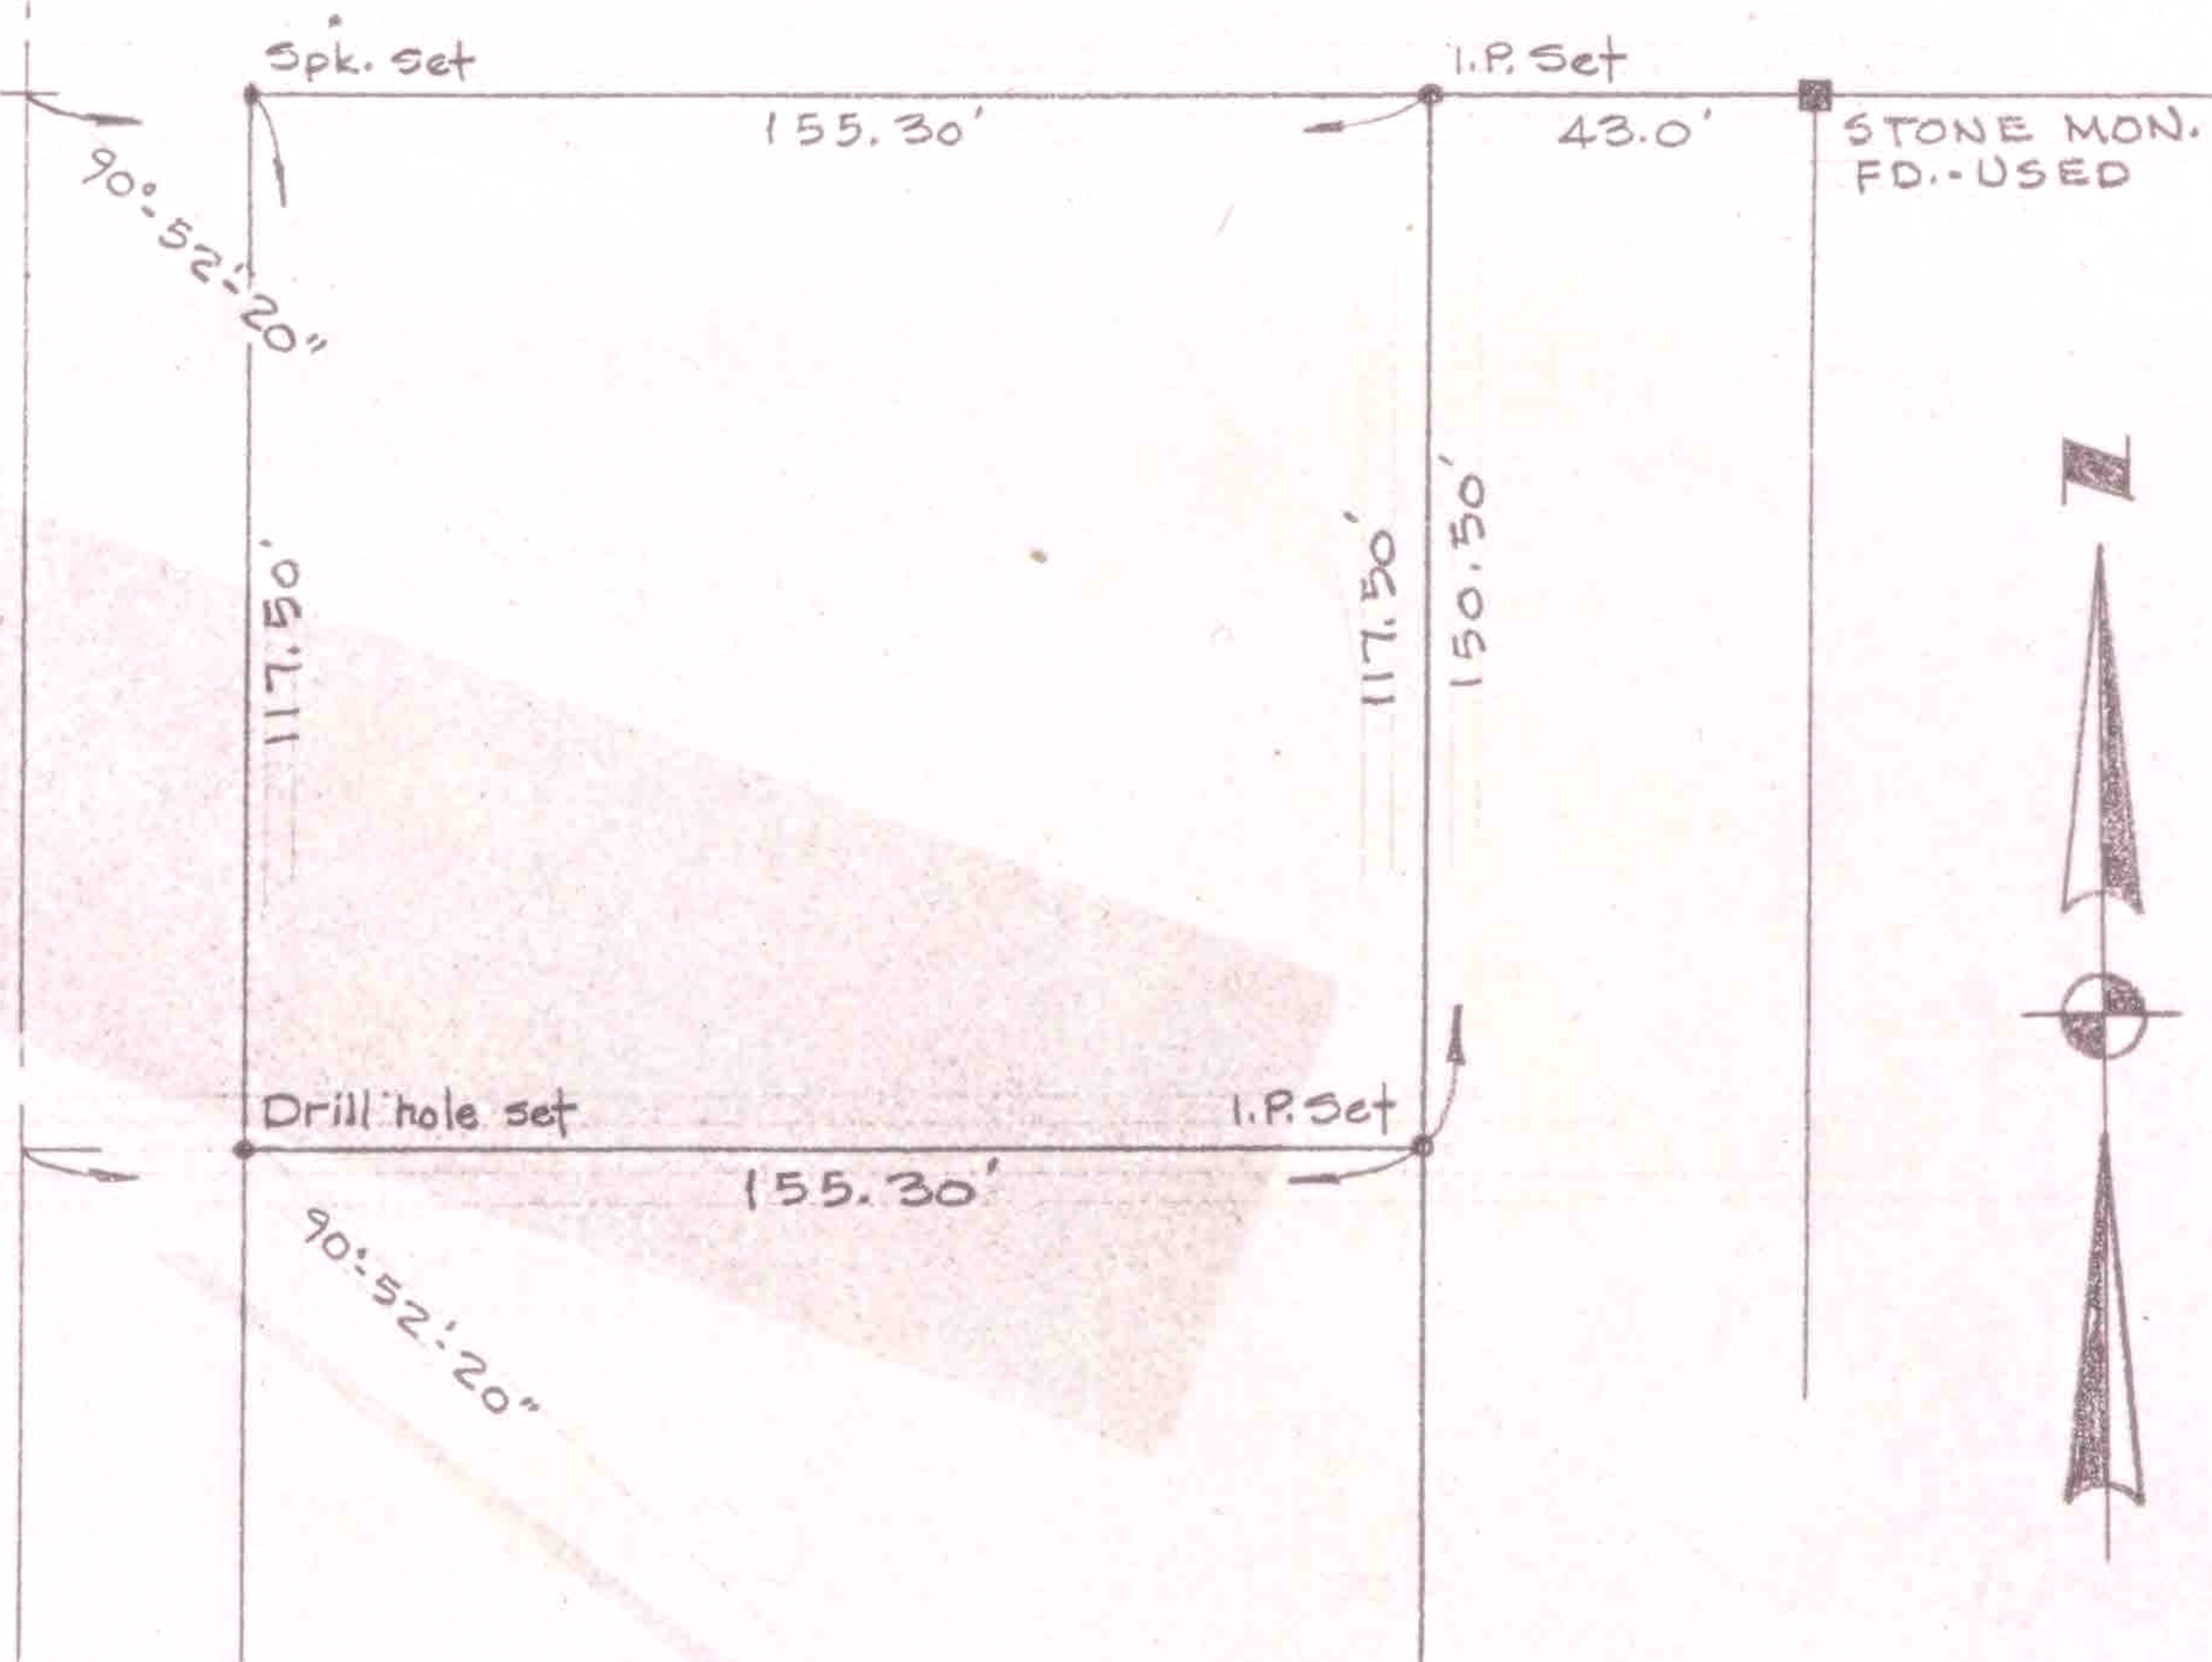

SURVEY FOR

THE FIRST CHURCH OF CHRIST, SCIENTIST INC.

O.V.P. LOT 14 P.V. 5 PG. 30 CITY OF OBERLIN

O.L. 86 RUSSIA TOWNSHIP - LORAIN COUNTY - OHIO

SCALE 1"=40'

NOV. 1974

LAUNDON • SIMON • CAHL & ASSOC.

ENGINEERS

SURVEYORS

FB 193/10

74-365