


9-00-086-106-007
9-00-086-A
SCAN # 46604

EAST COLLEGE ST. 60'

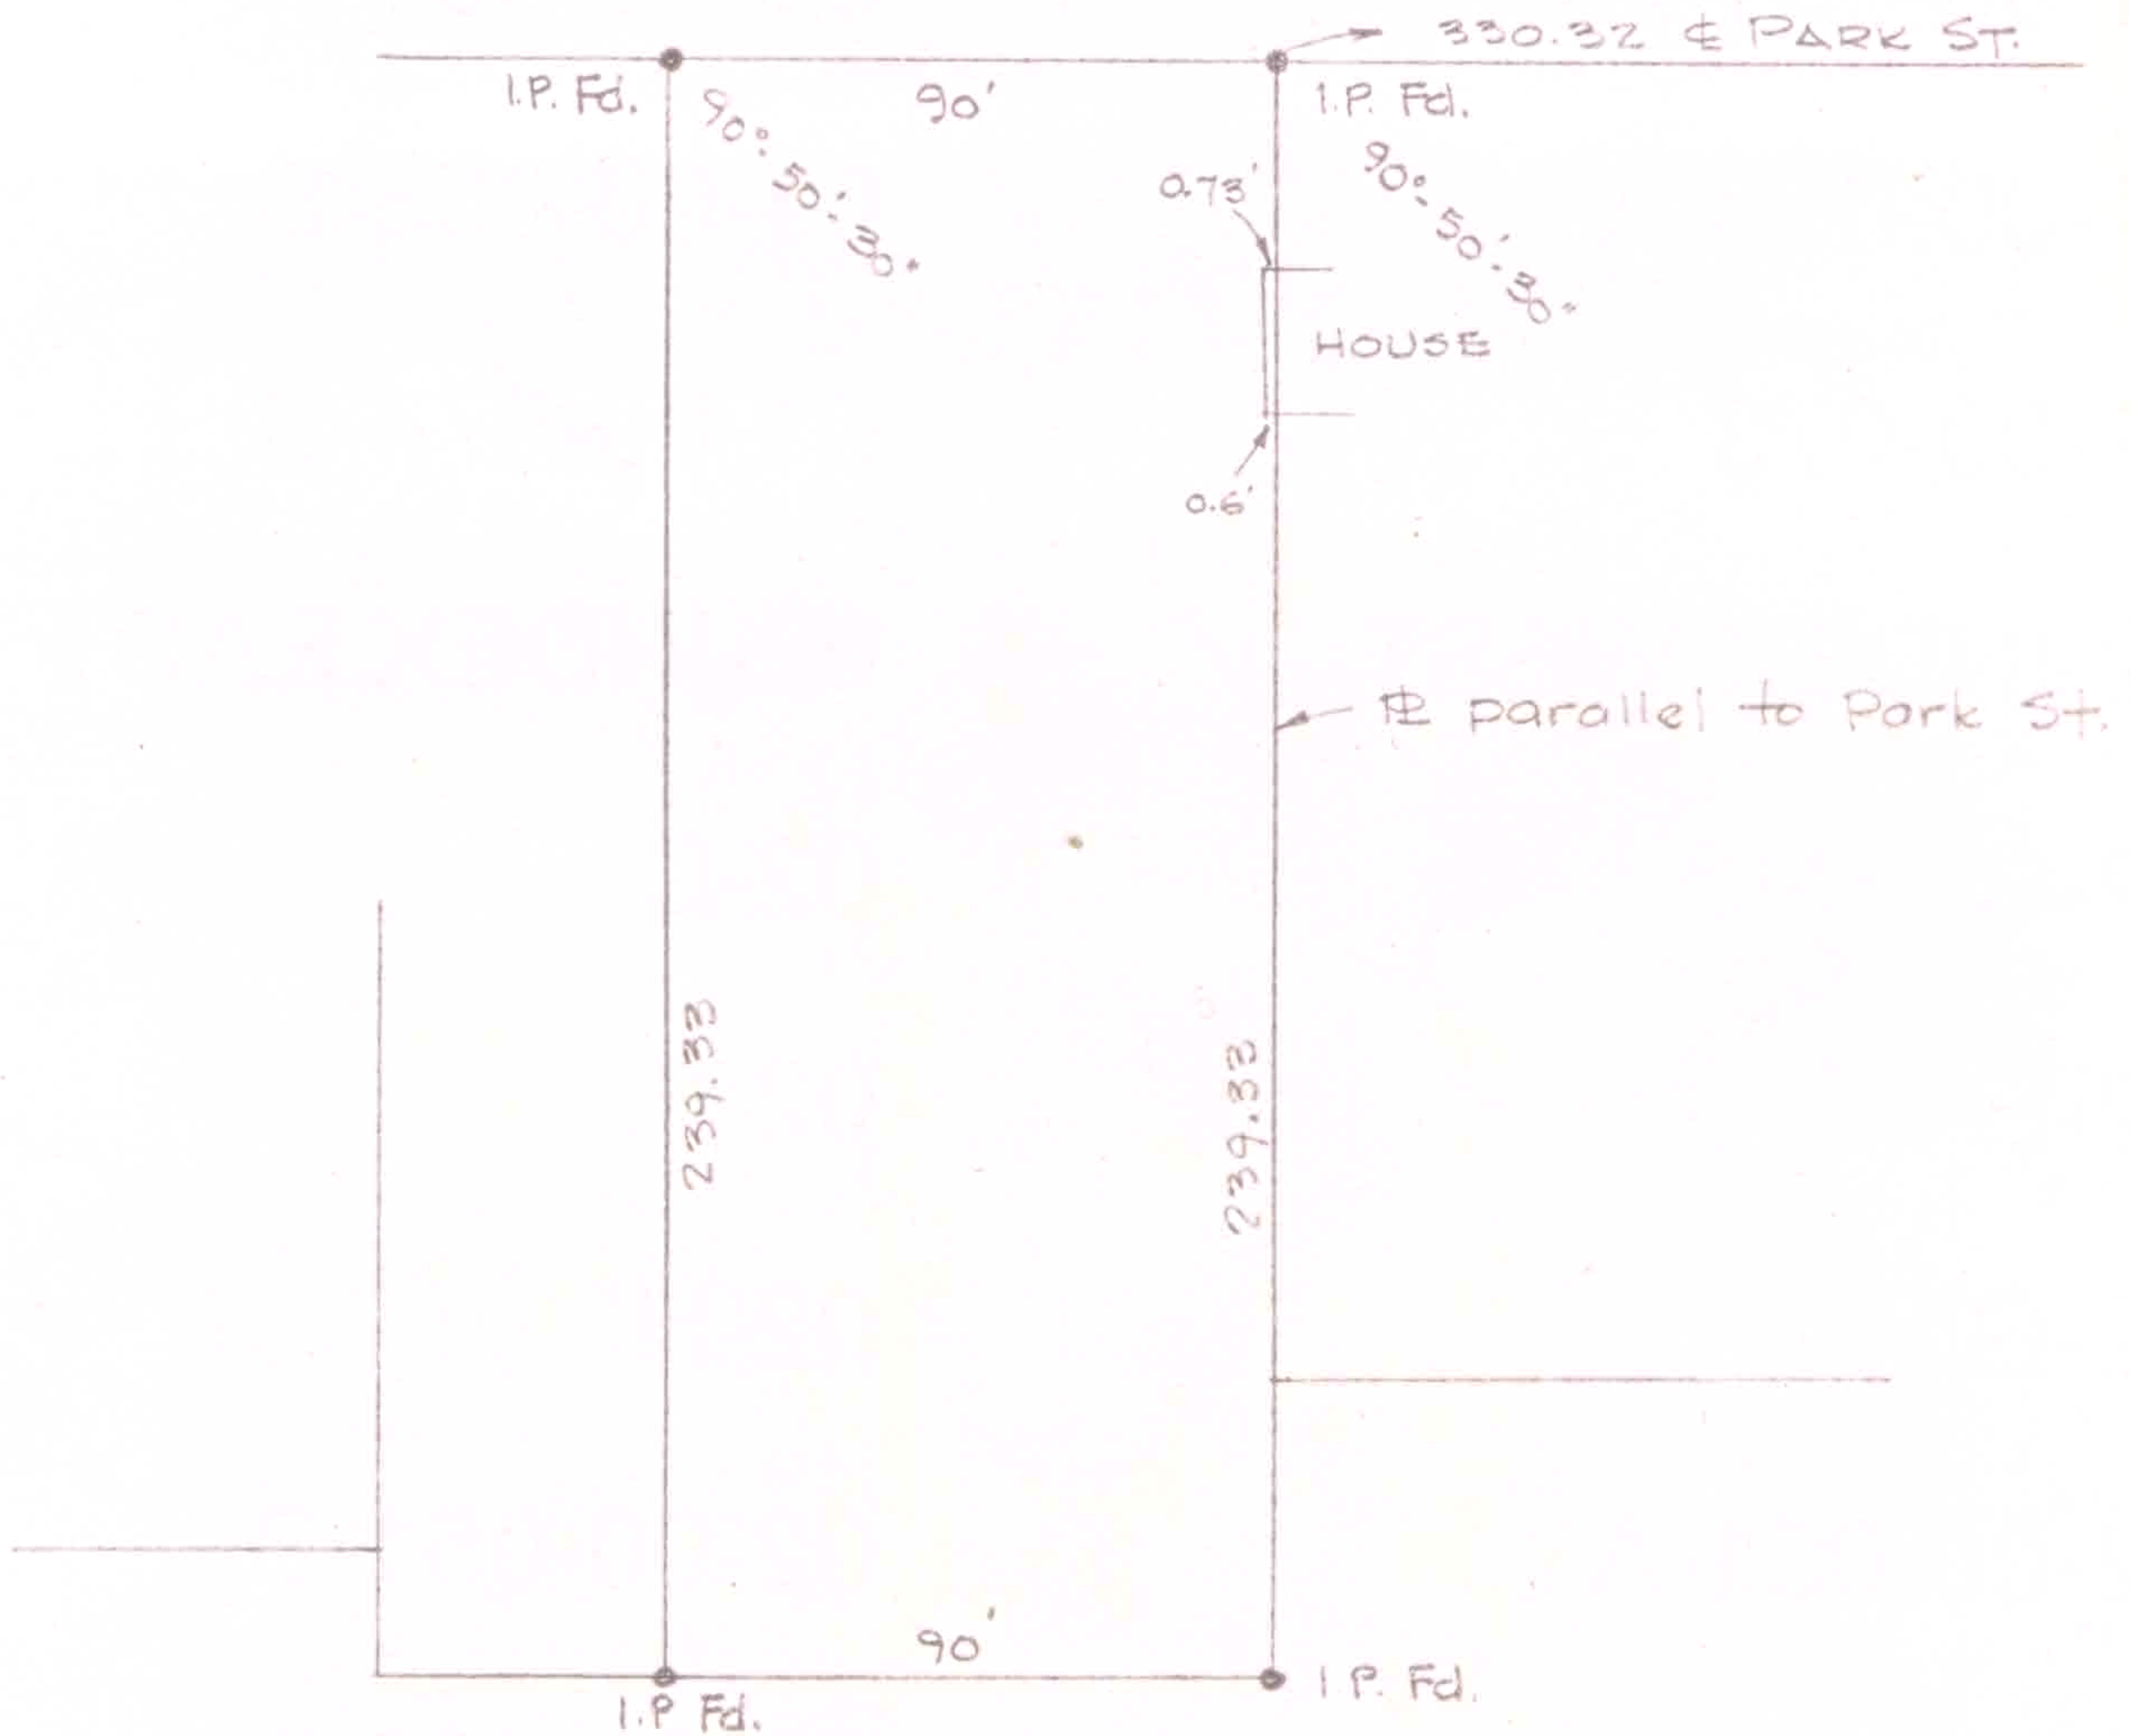

SURVEY FOR AGNES W. FELKNER

OUTLOT 33 OVP O.L. 86 RUSSIA TWP.
CITY OF OBERLIN - LORAIN COUNTY - OHIO
SCALE 1" = 50' AUG. 1974
LAUNDON • SIMON • CAHL & ASSOC.
ENGINEERS SURVEYORS