


Scan # 46607

9-00-086-106-013
9-00-086-A

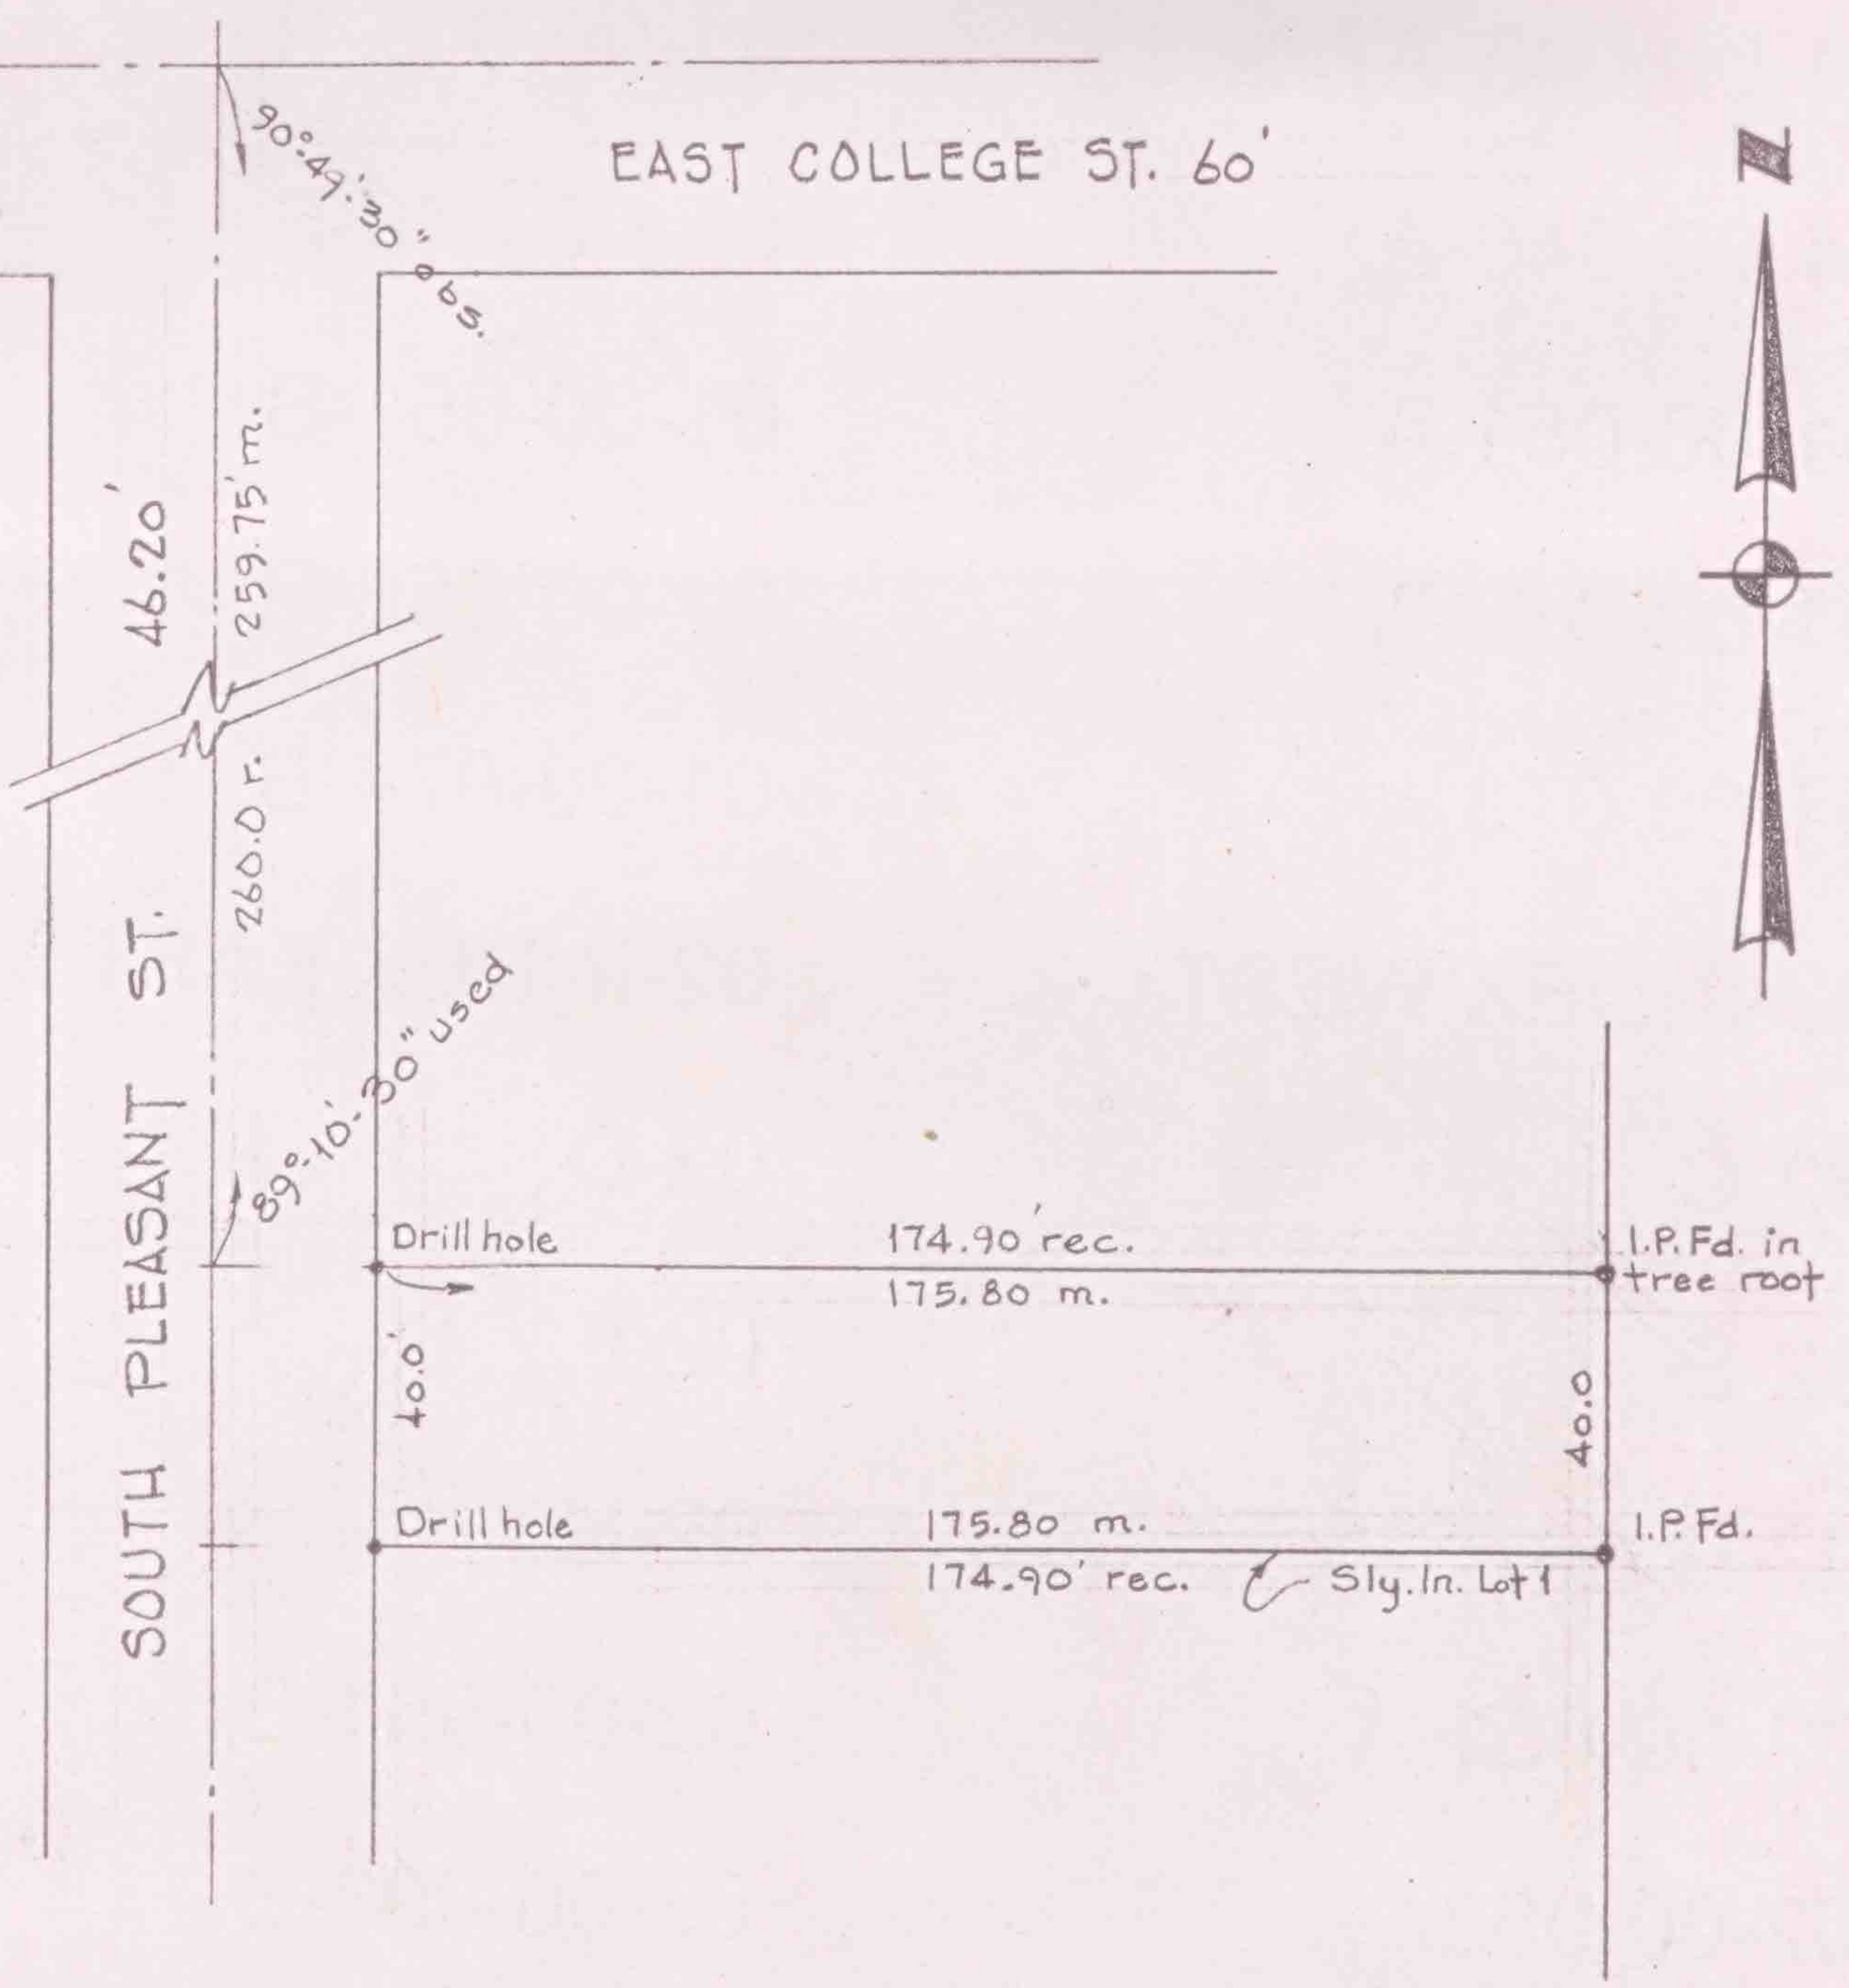

SURVEY FOR

MARY W. SMITH

PART OF S/L 1 HAZEN & ELLS SUB'N. P.V. 1 PG. 41
 O.L. 86 RUSSIA TWP. CITY OF OBERLIN
 LORAIN COUNTY, OHIO SCALE 1"=40' MARCH, 1977
 LAUNDON • SIMON • CAHL & ASSOC.
 ENGINEERS SURVEYORS

Job No 77-582
FB. 65/33