
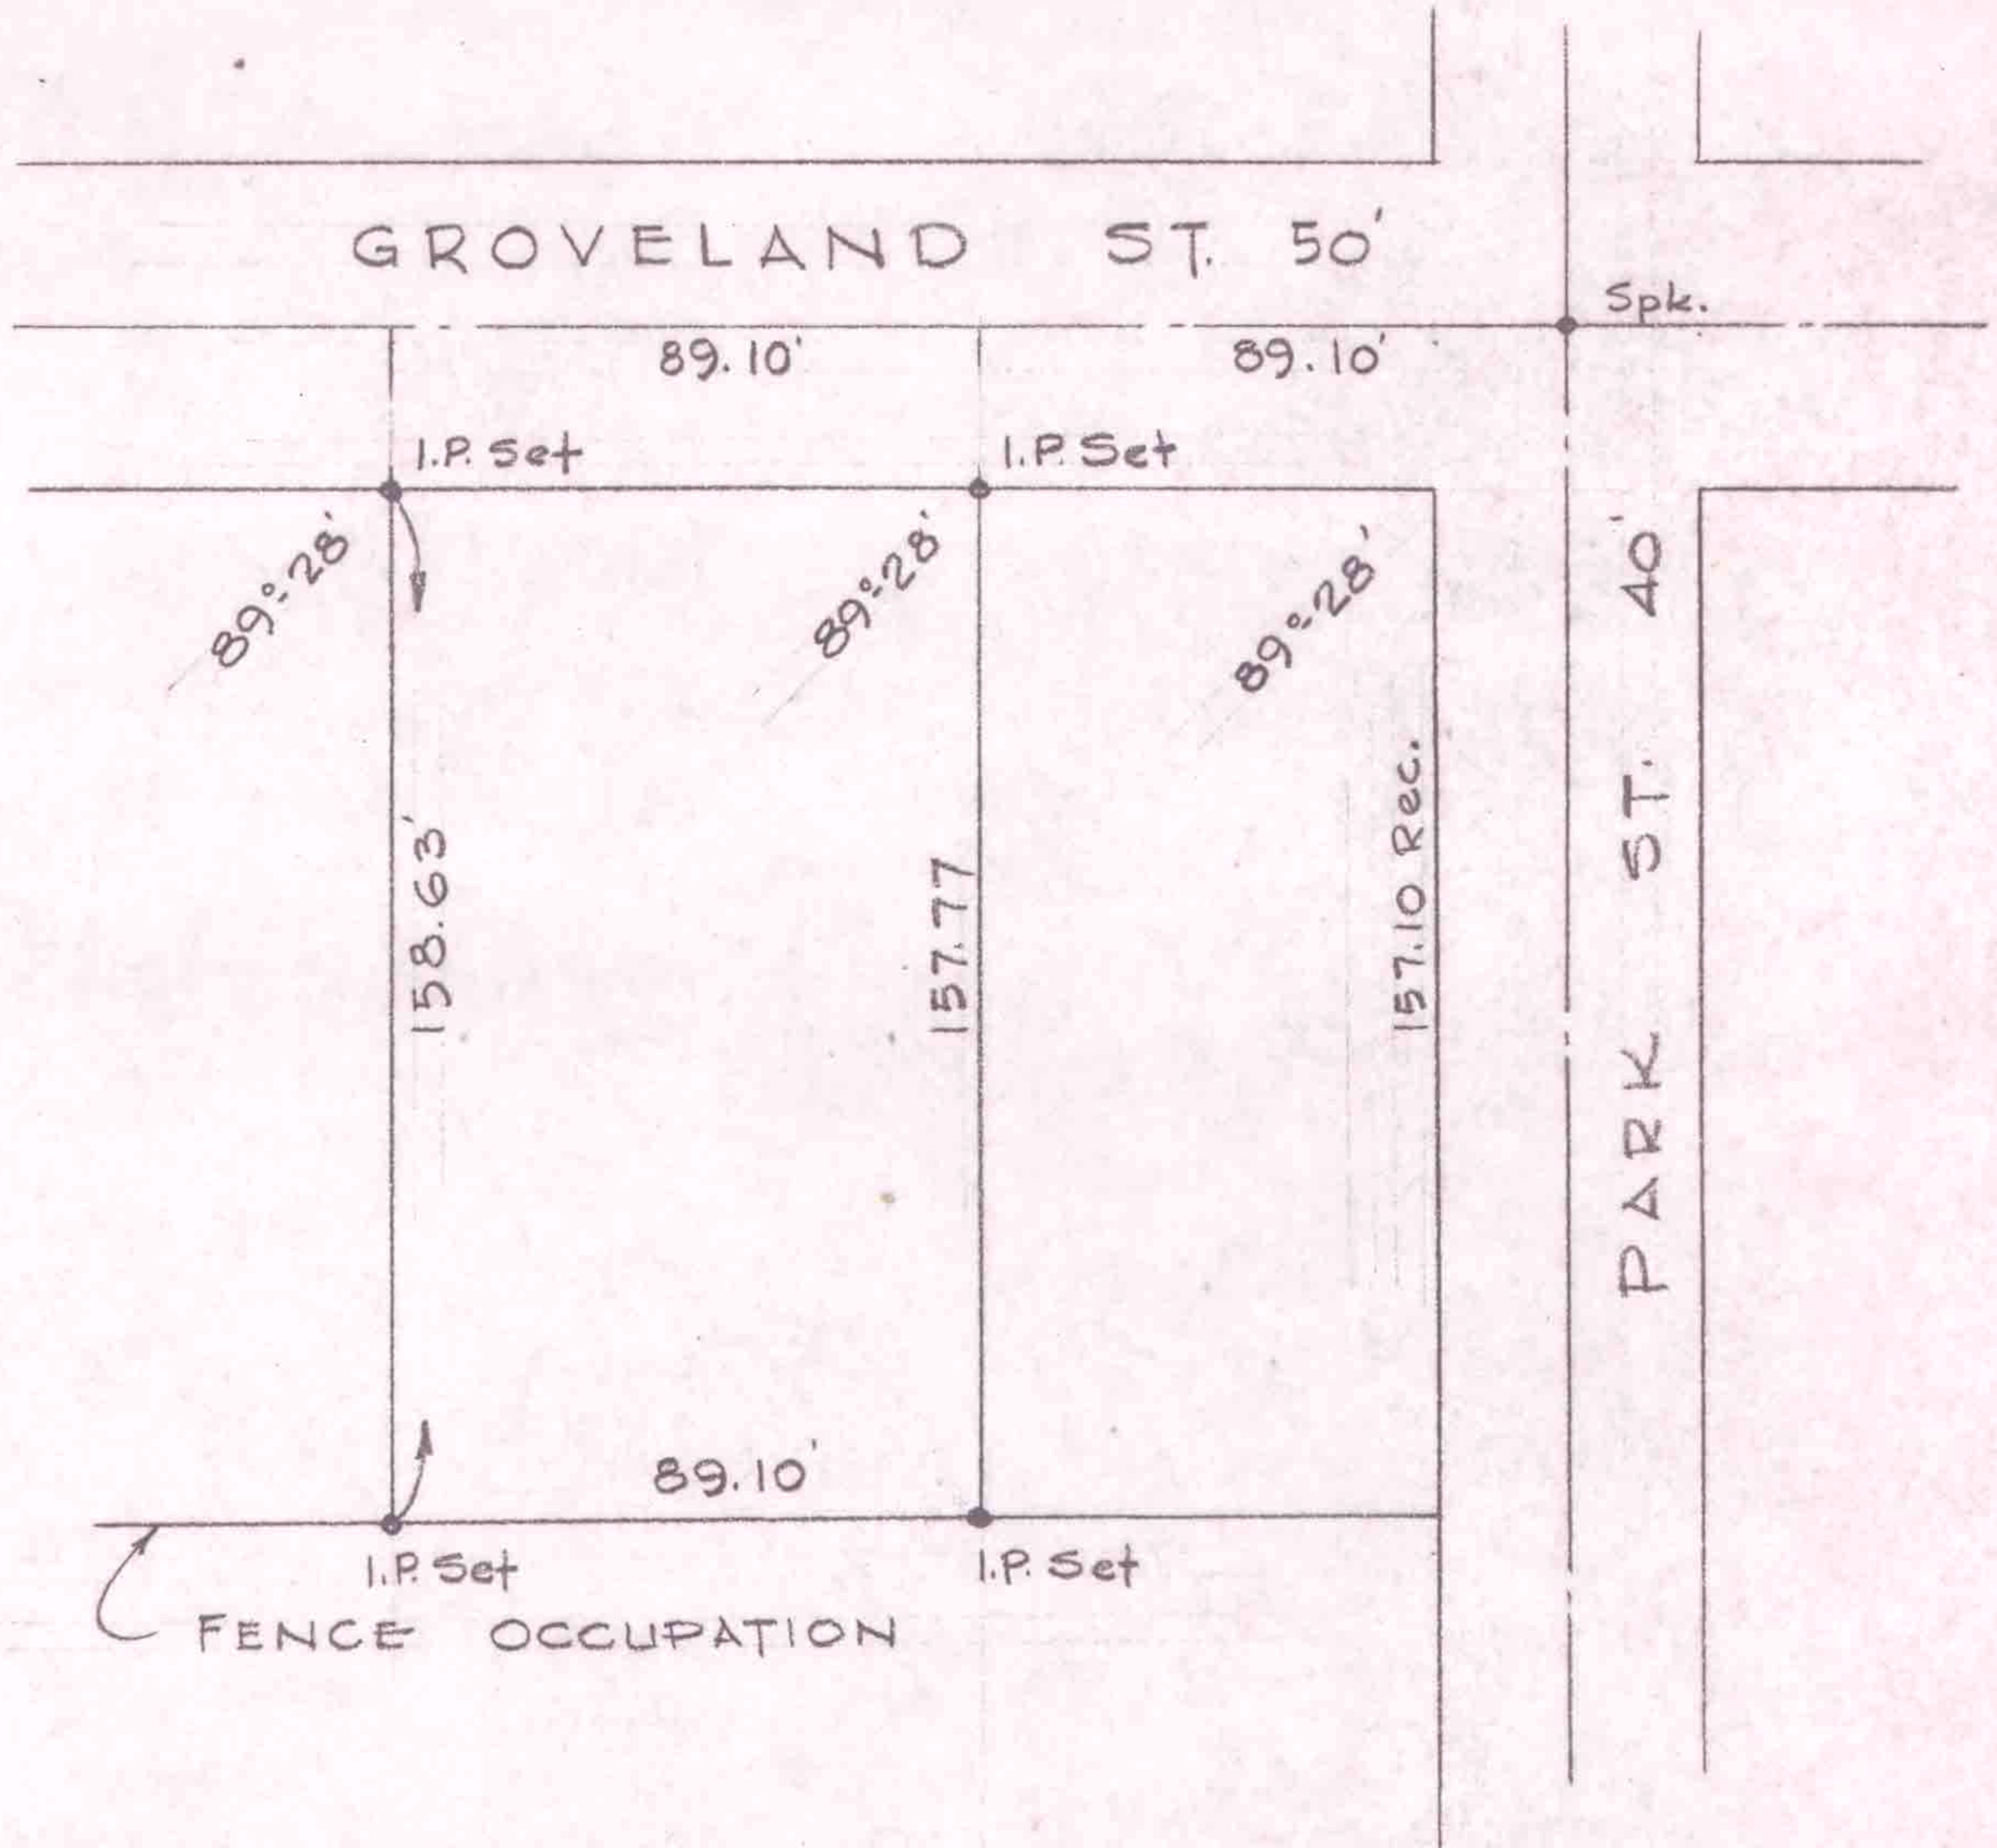


9-00-086-108
9-00-086-A
SCAN #46609

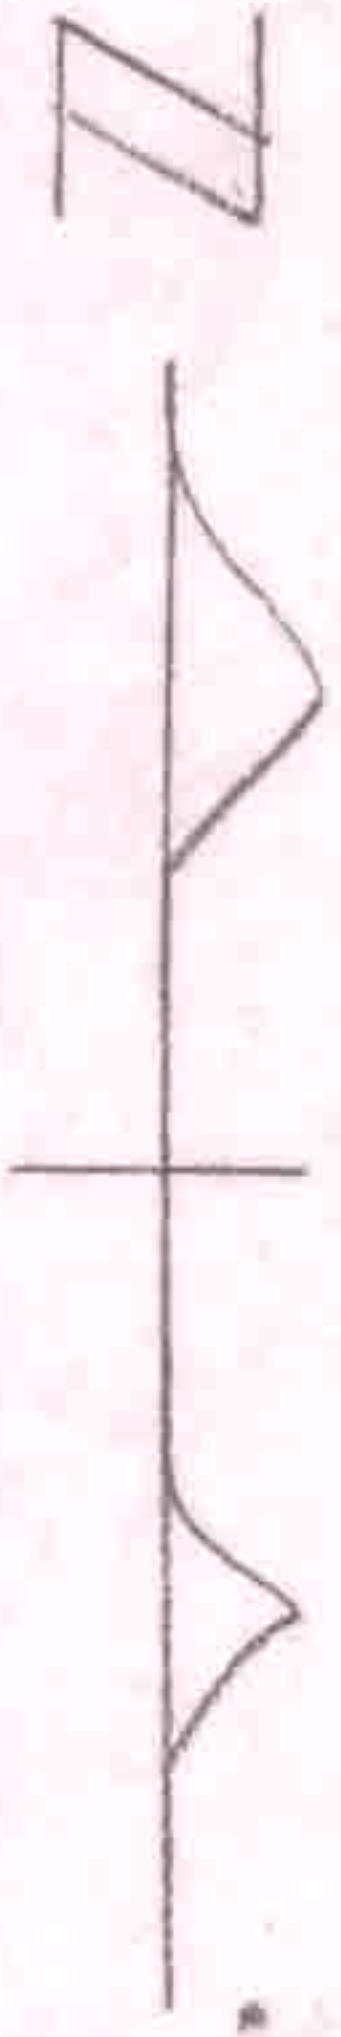

SURVEY FOR JESS SMITH

PART OF O.L. 86 RUSSIA TOWNSHIP
OVP LOT 91 CITY OF OBERLIN
LORAIN COUNTY OHIO

SCALE 1" = 50'

JUNE, 1973

LAUNDON • SIMON • CAHL & ASSOC.

ENGINEERS • SURVEYORS

JOB 73-125
FB. 181-29