


9-00-086-112-001
9-00-086-B
SCAN # 46414

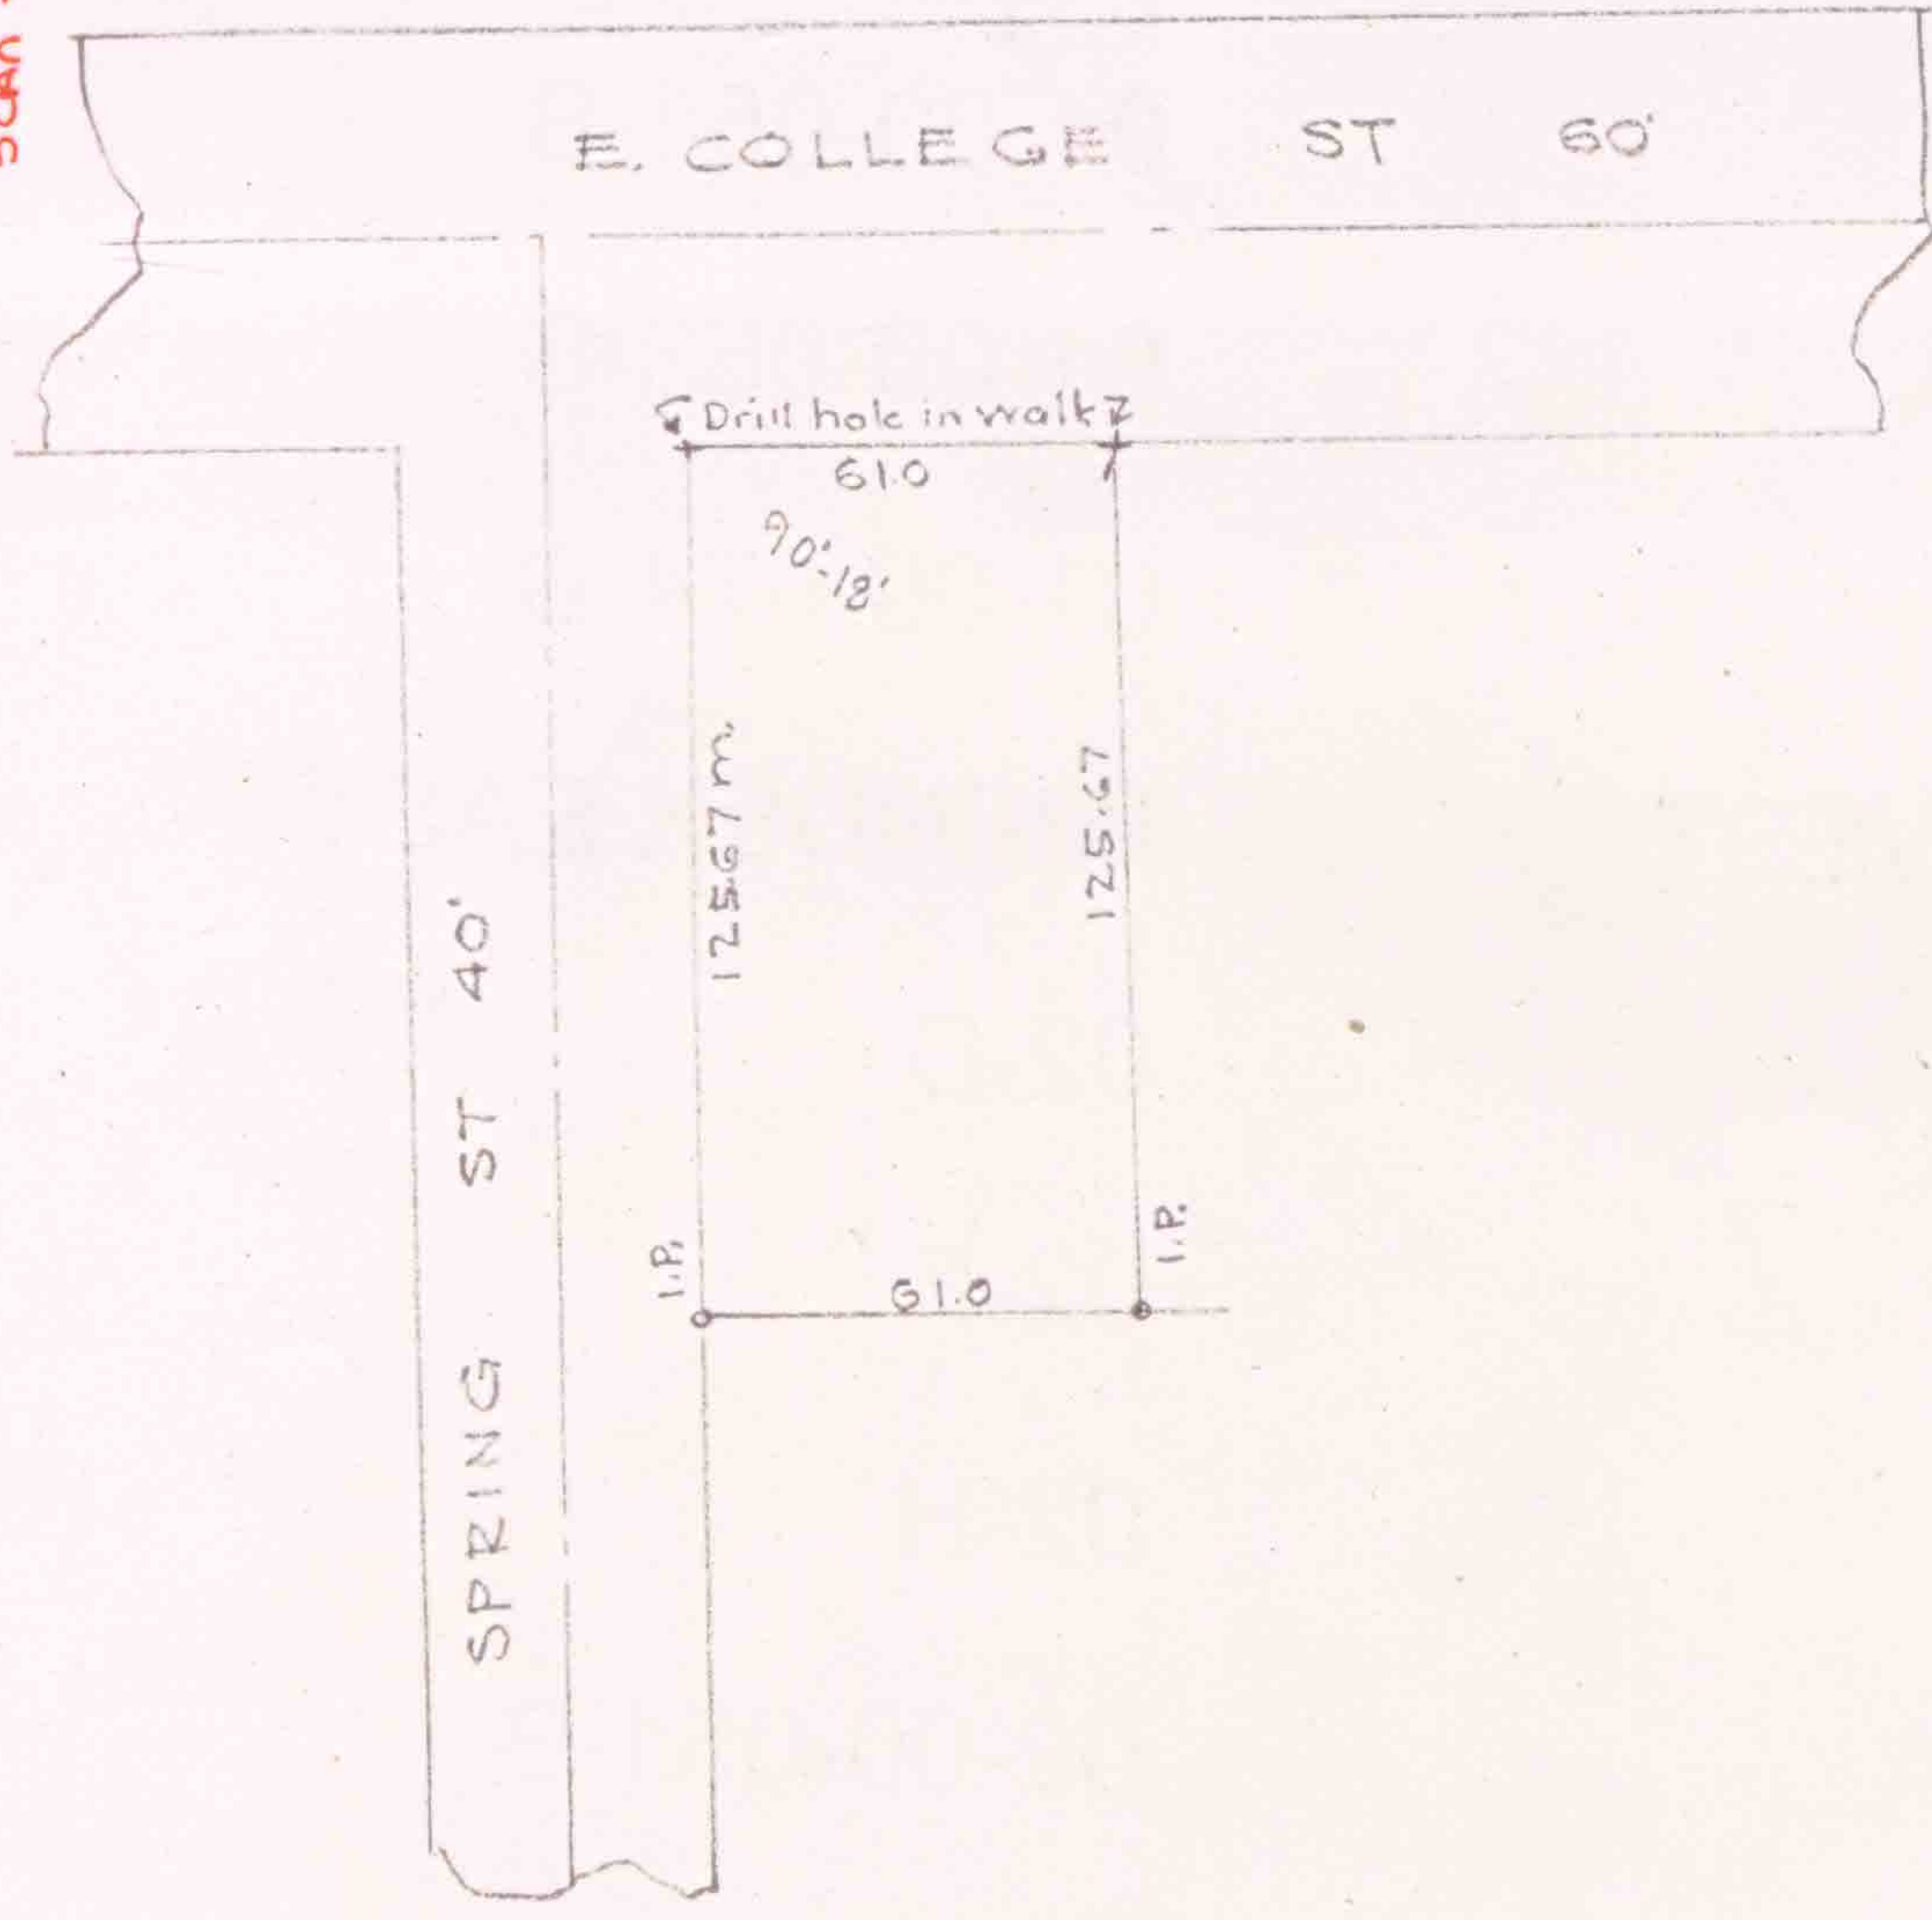

SURVEY FOR OBERLIN SAVINGS BANK
PART OF SUB-LOT 31 H. VIETS ADDN
CITY OF OBERLIN LORAIN CO OHIO
SCALE 1"=50' JUNE 15 1964
LAUNDON & HUFFMAN - SURVEYORS