

9-00-087-104-023  
9-00-087-A  
Scan # 46621


E EAST COLLEGE ST. 60'  
226.50 E ORCHARD



EBBA O. SKJERNE 8/31/39  
D.V. 299-437

CLARENCE WARD 11/30/17  
D.V. 146-111

ANNA J. GARSKA 9/29/49  
D.V. 297-536

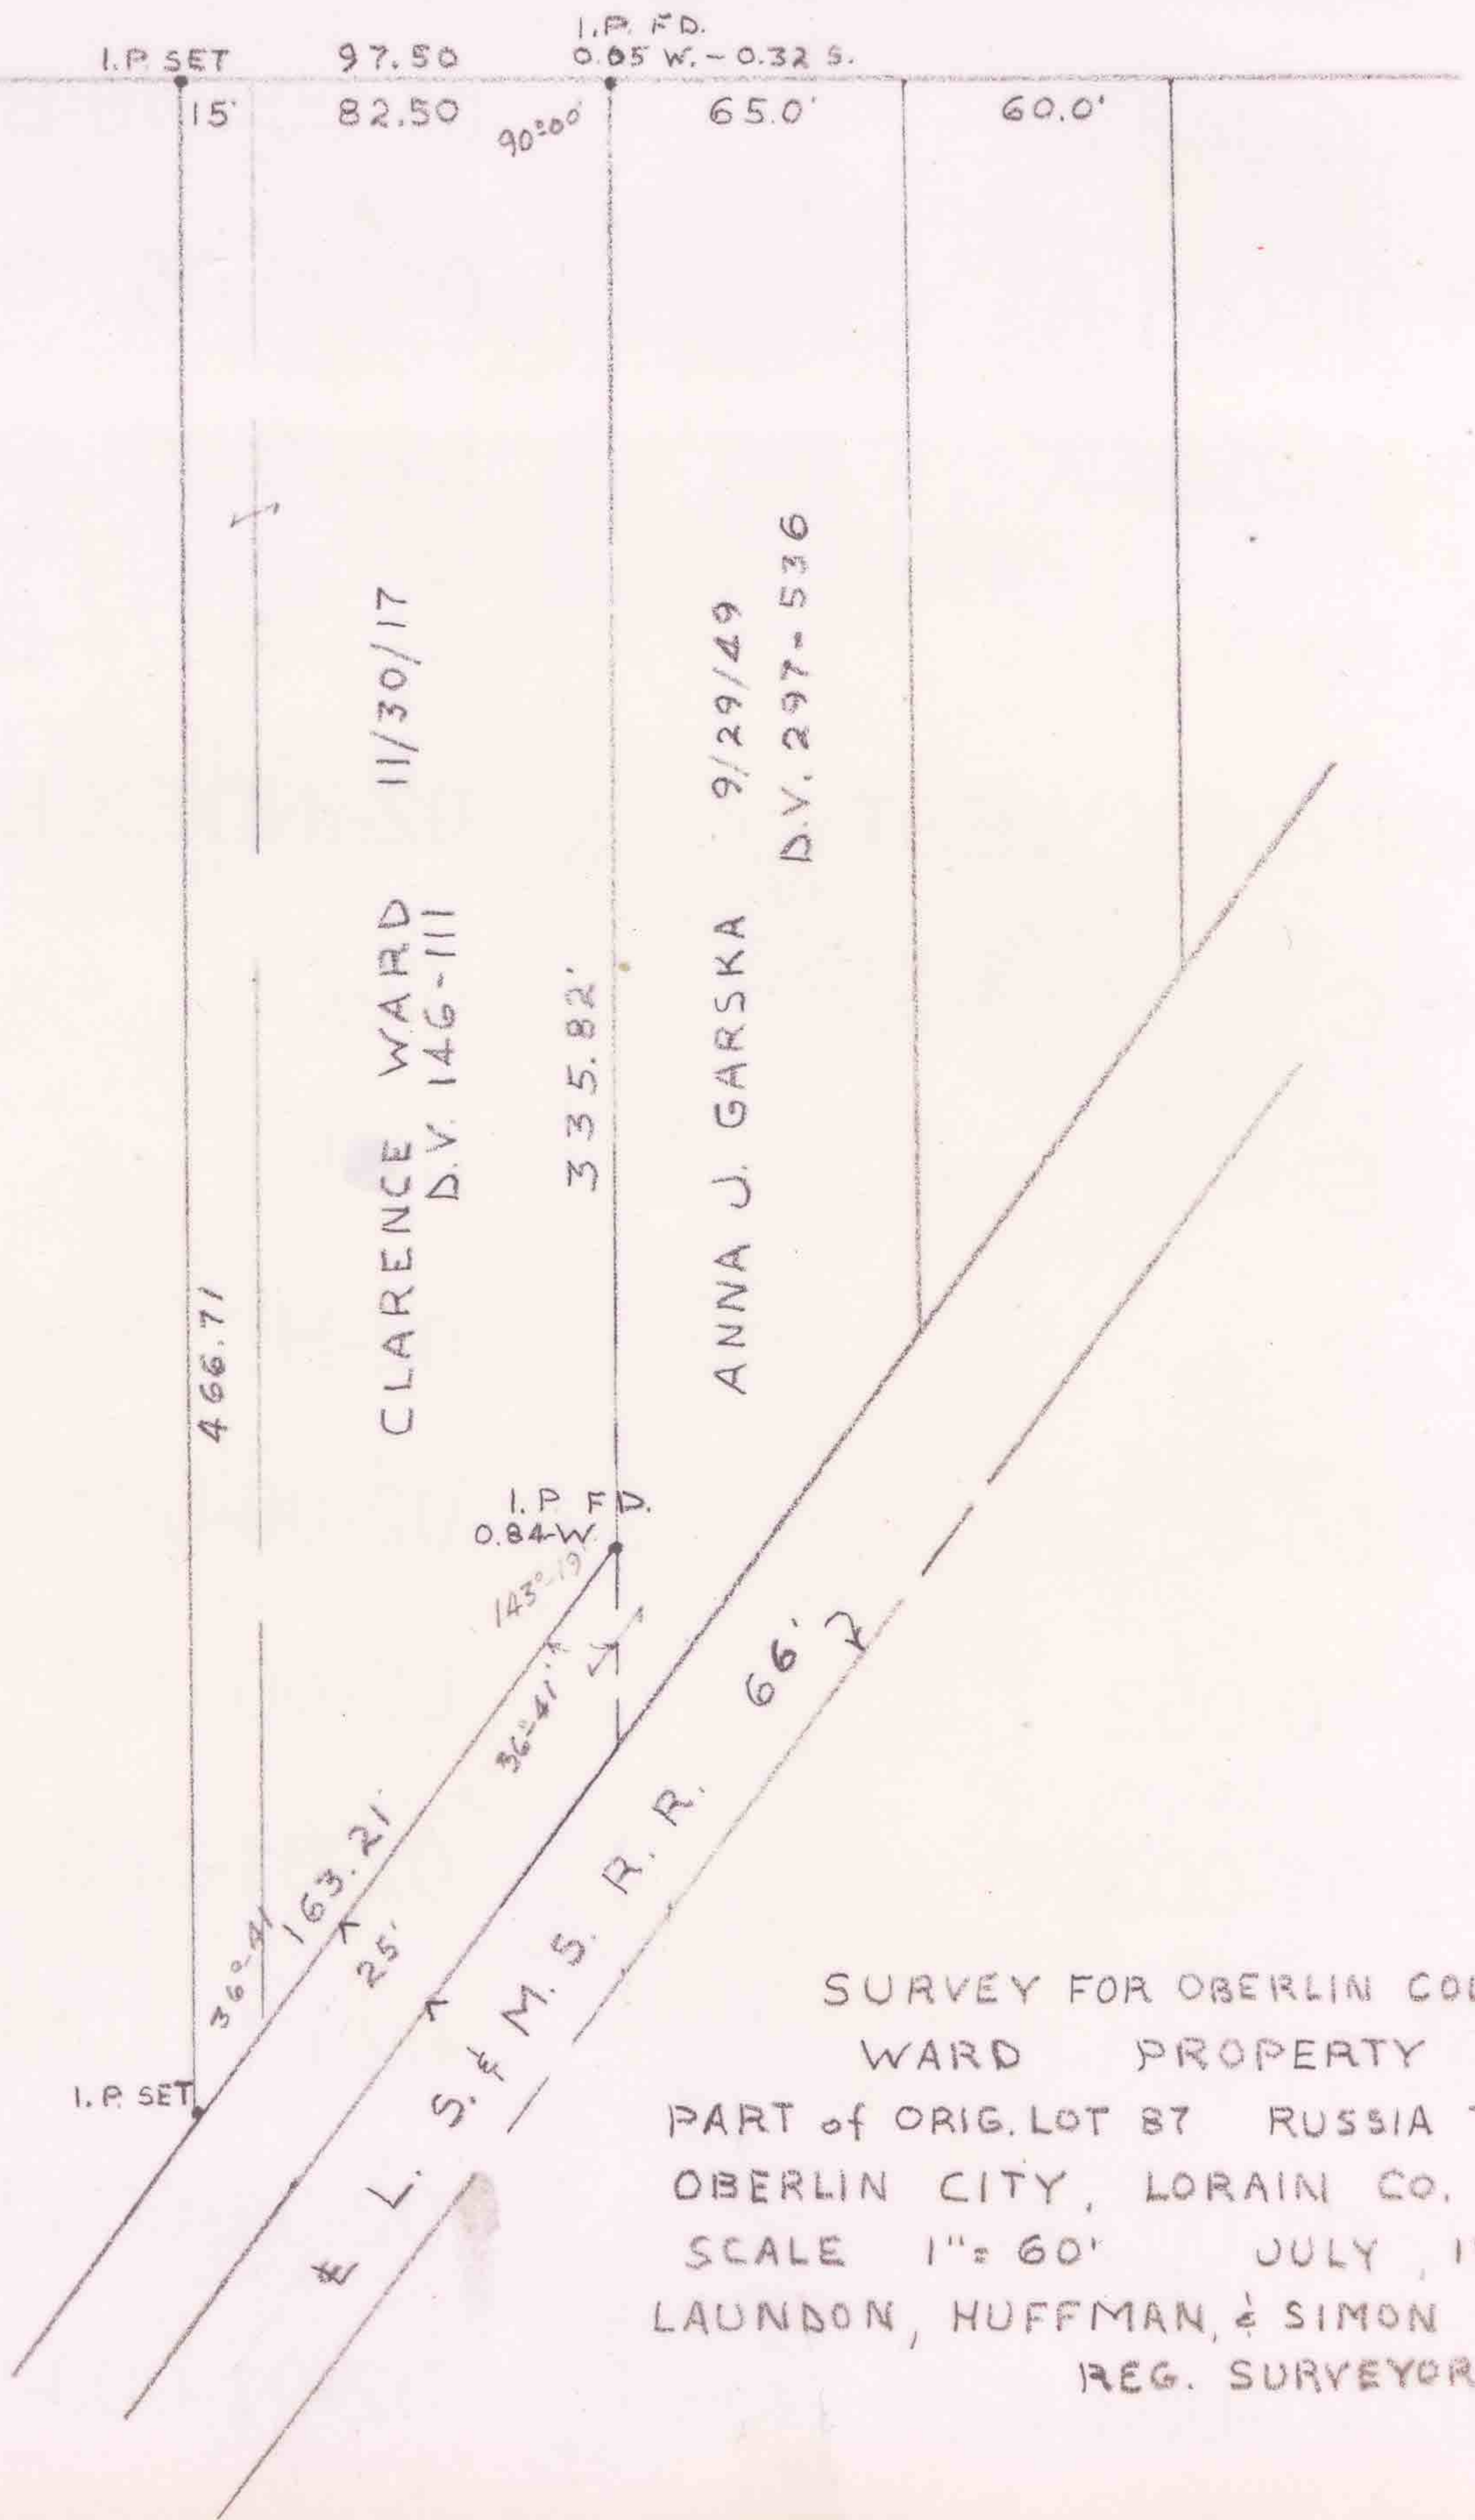

SURVEY FOR OBERLIN COLLEGE  
WARD PROPERTY  
PART of ORIG. LOT 87 RUSSIA TWP.  
OBERLIN CITY, LORAIN CO. OHIO  
SCALE 1" = 60' JULY, 1968  
LAUNDON, HUFFMAN, & SIMON  
REG. SURVEYORS