


9-00-095-108-011  
9-00-095-B  
SCAN #46639

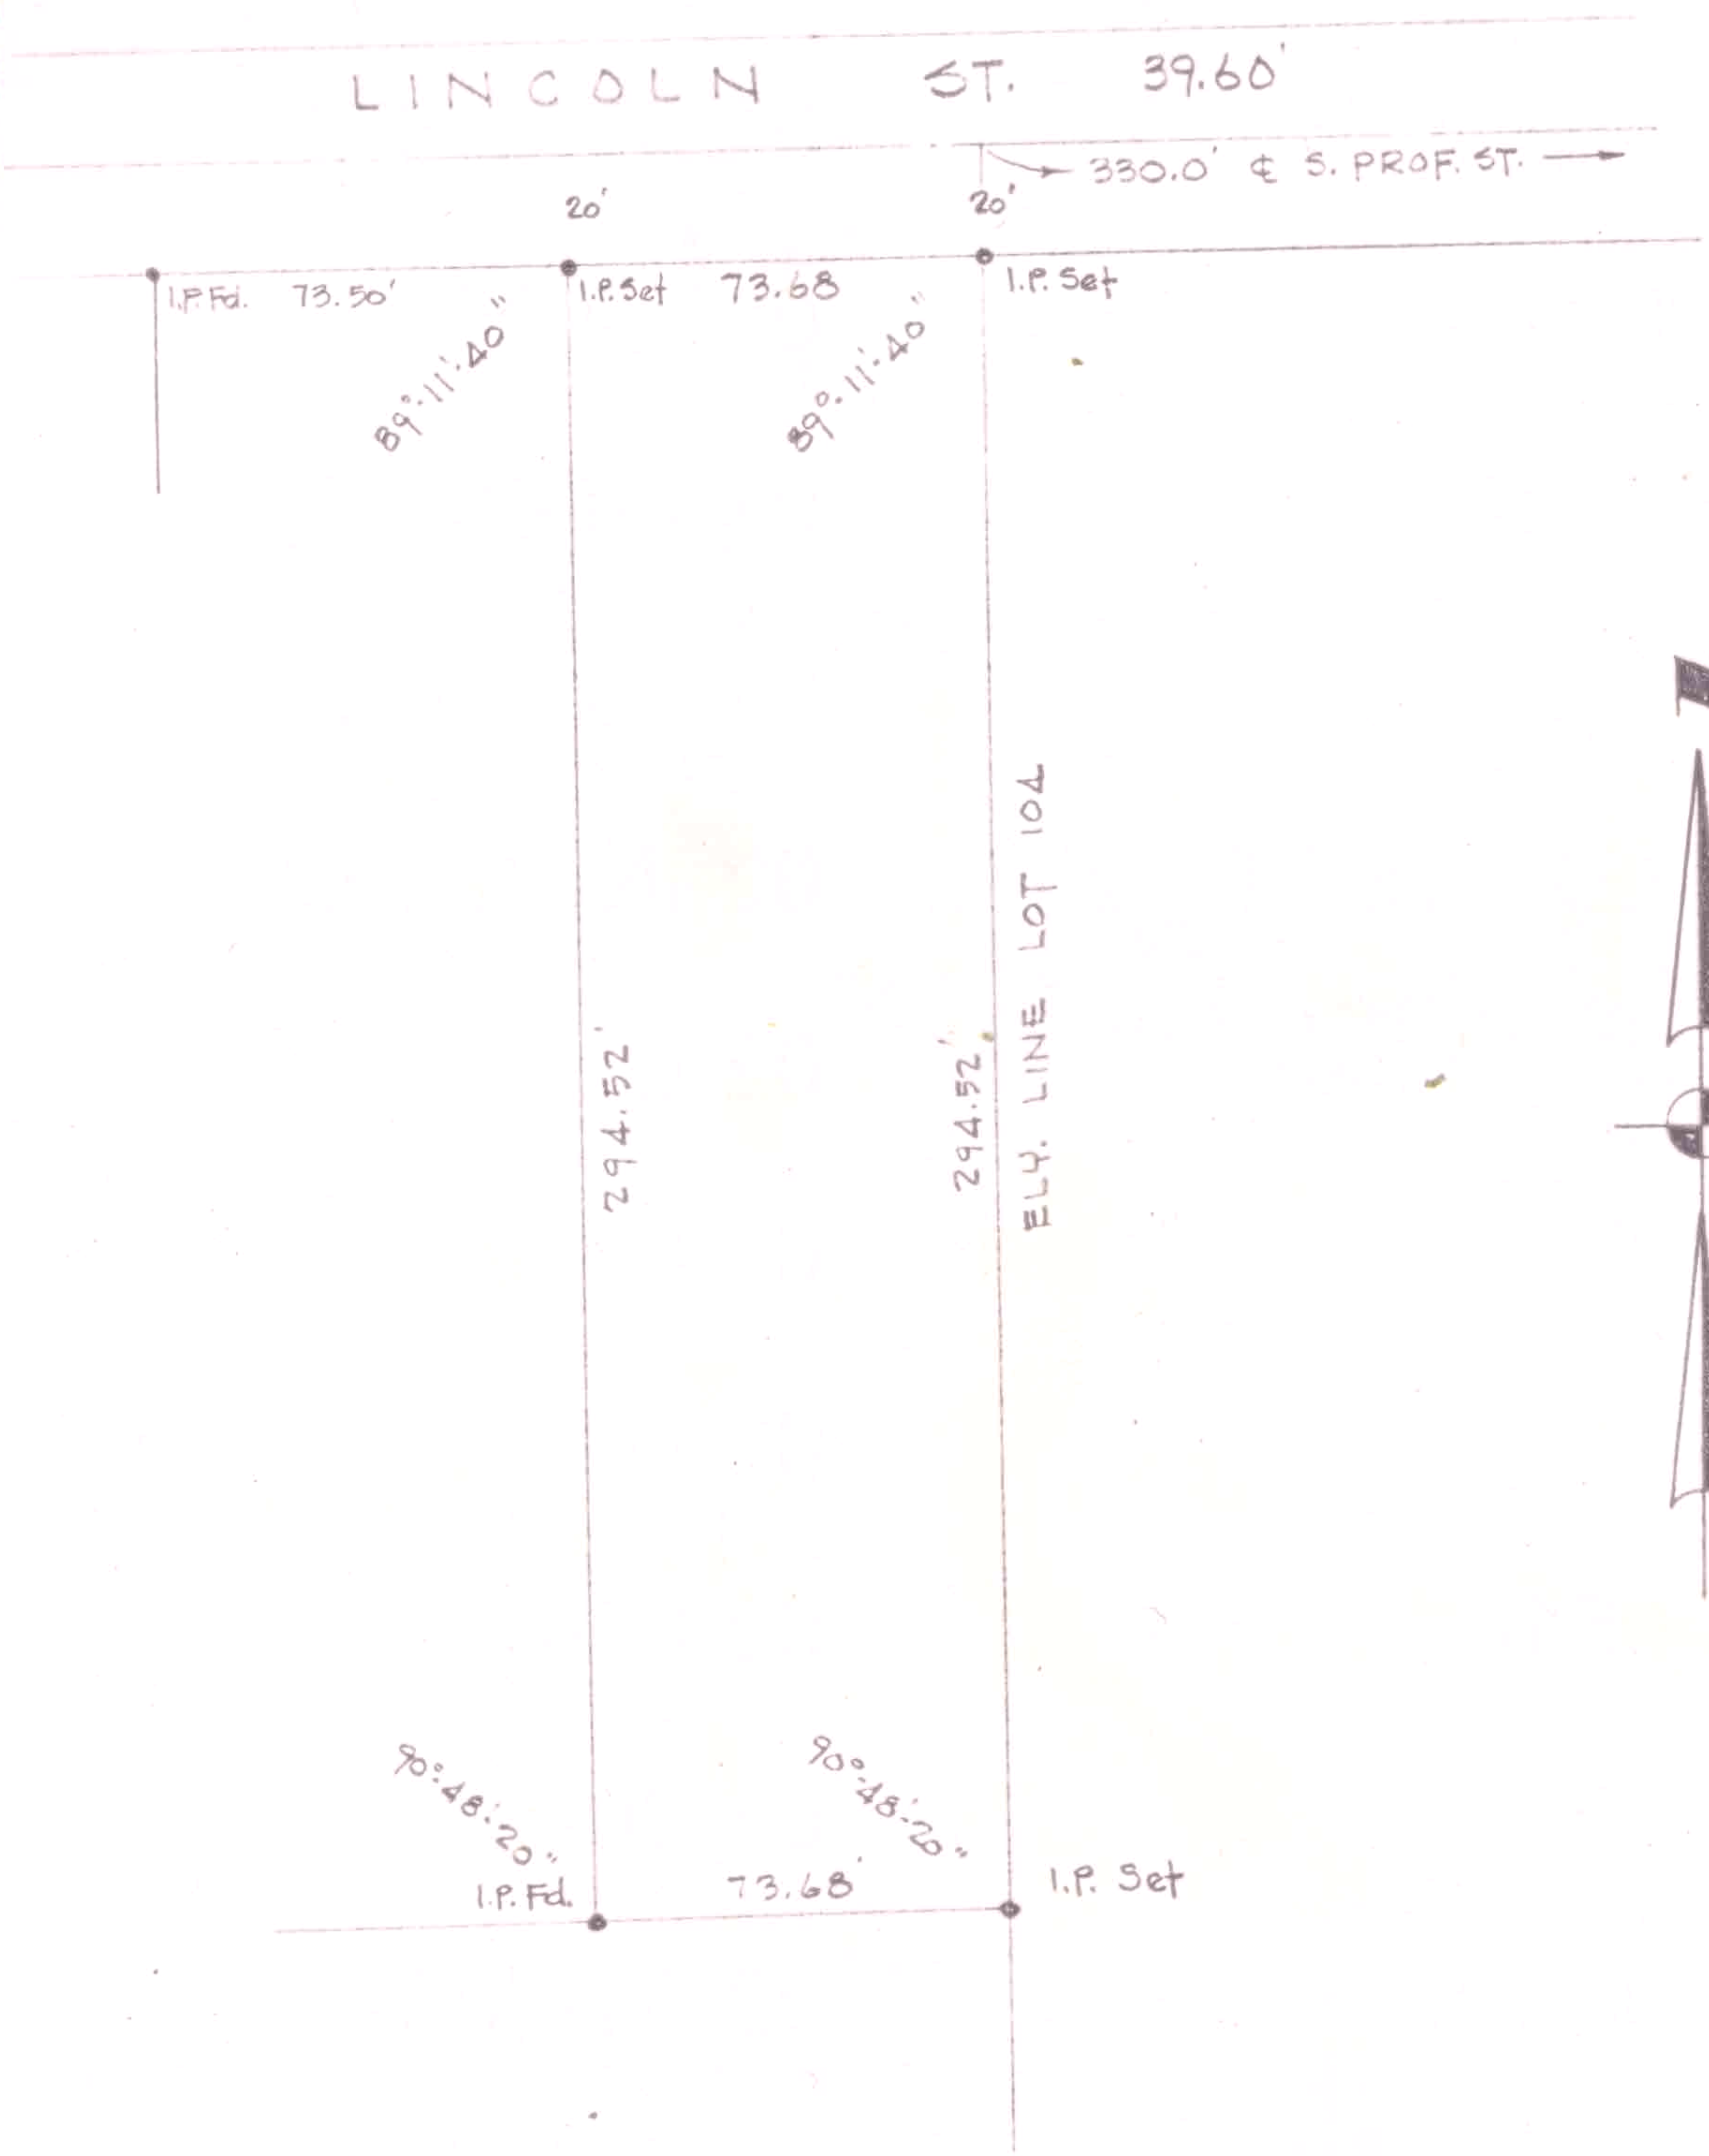

SURVEY FOR  
ZENOBIA DAMPIER  
PART OF LOT 104 FOLLETT'S 2ND ADDN. P.V. 3 P. 9  
CITY OF OBERLIN - LORAIN COUNTY - OHIO  
SCALE 1" = 50' SEPT. 1978  
LAUNDON • SIMON • CAHL & ASSOC.  
ENGINEERS - SURVEYORS No 78-791 F.B. 118/76