


9-00-096-113

9-00-096-B

SCAN# 46653

1 P. 1352.0 FT. FROM
E. LINE PLEASANT ST

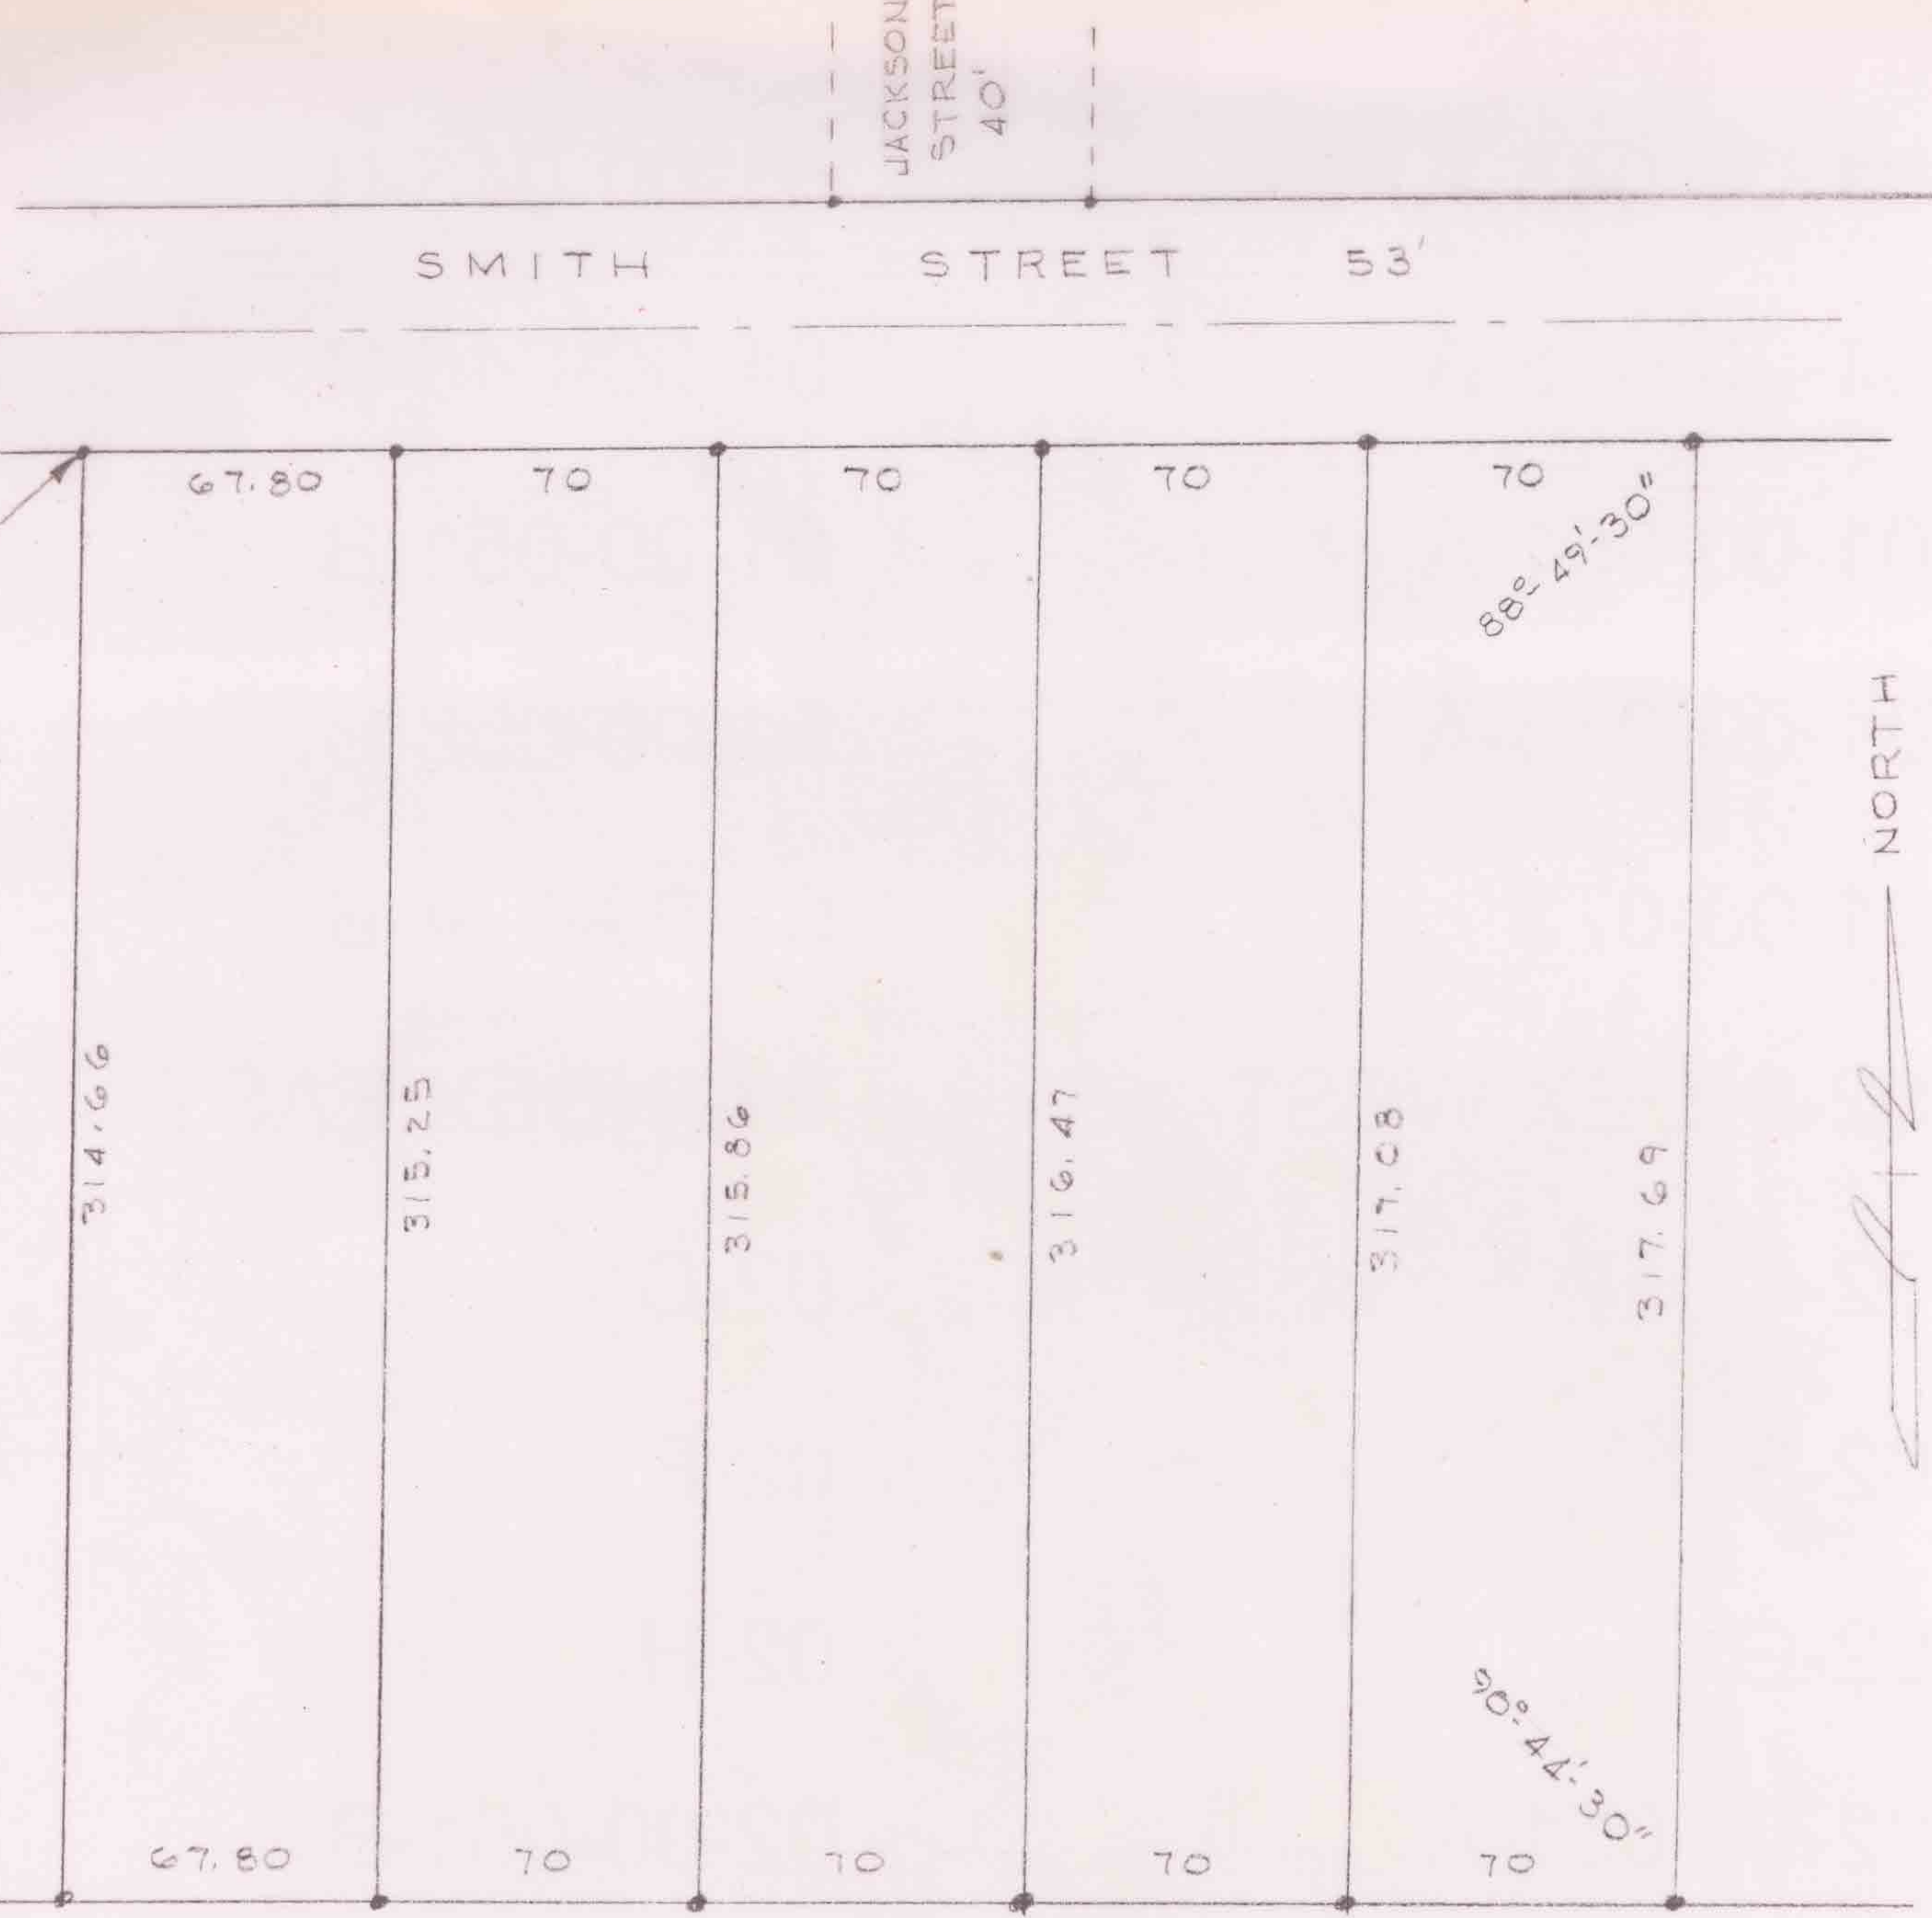

NORTH

SURVEY FOR HARLEY J. SMITH
 O.L. 96 RUSSIA TWP OBERLIN CITY
 LORAIN COUNTY OHIO
 SCALE: 1" = 60' DECEMBER 1964
 LAUNDON-HUFFMAN & SIMON - SURVEYORS