


9-00-099-000-030
 9-00-099-8
 5 CAN #44656

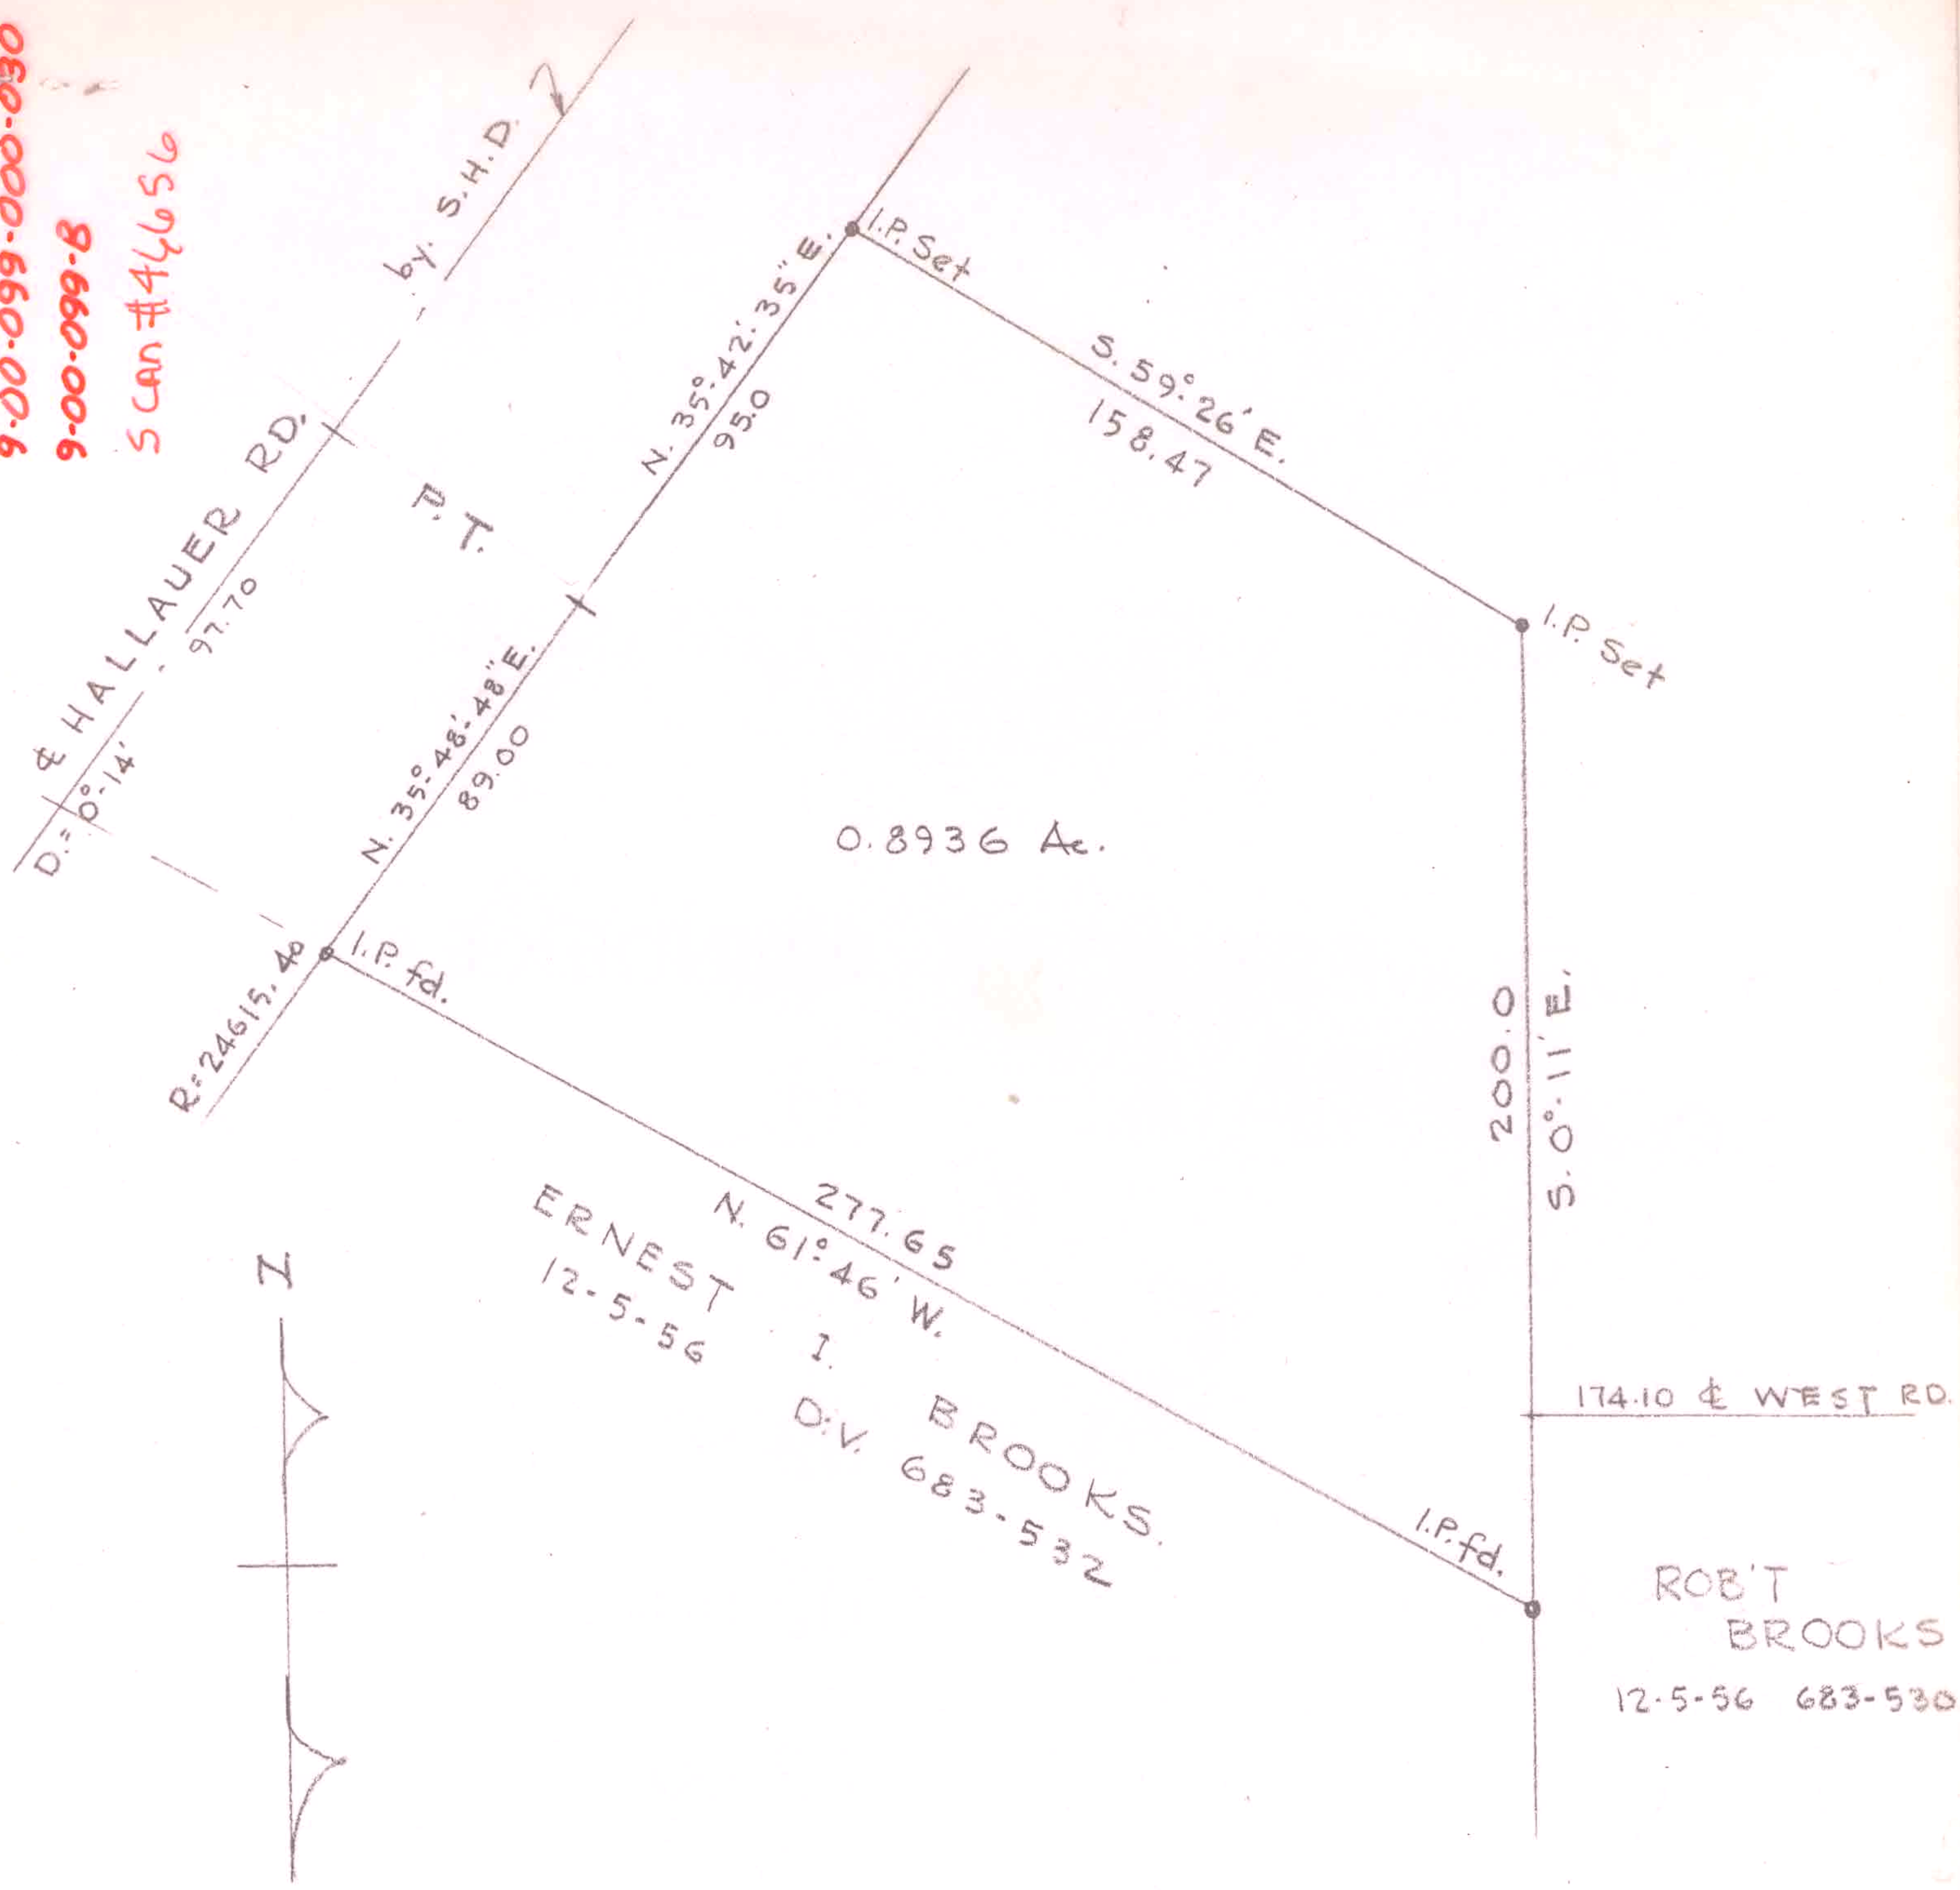

SURVEY FOR BROOKS
 PART OF O.L. 99 RUSSIA TWP, LOR. CO., OHIO
 SCALE 1" = 50'
 LAUNDON & HUFFMAN REG. SURVEYORS
 MARCH, 1964