


9-00-100-000-034
9-00-100-B
SCAN #A16661

ELMO L. LEONARD
3-25-68 D.V. 961 Pg. 858

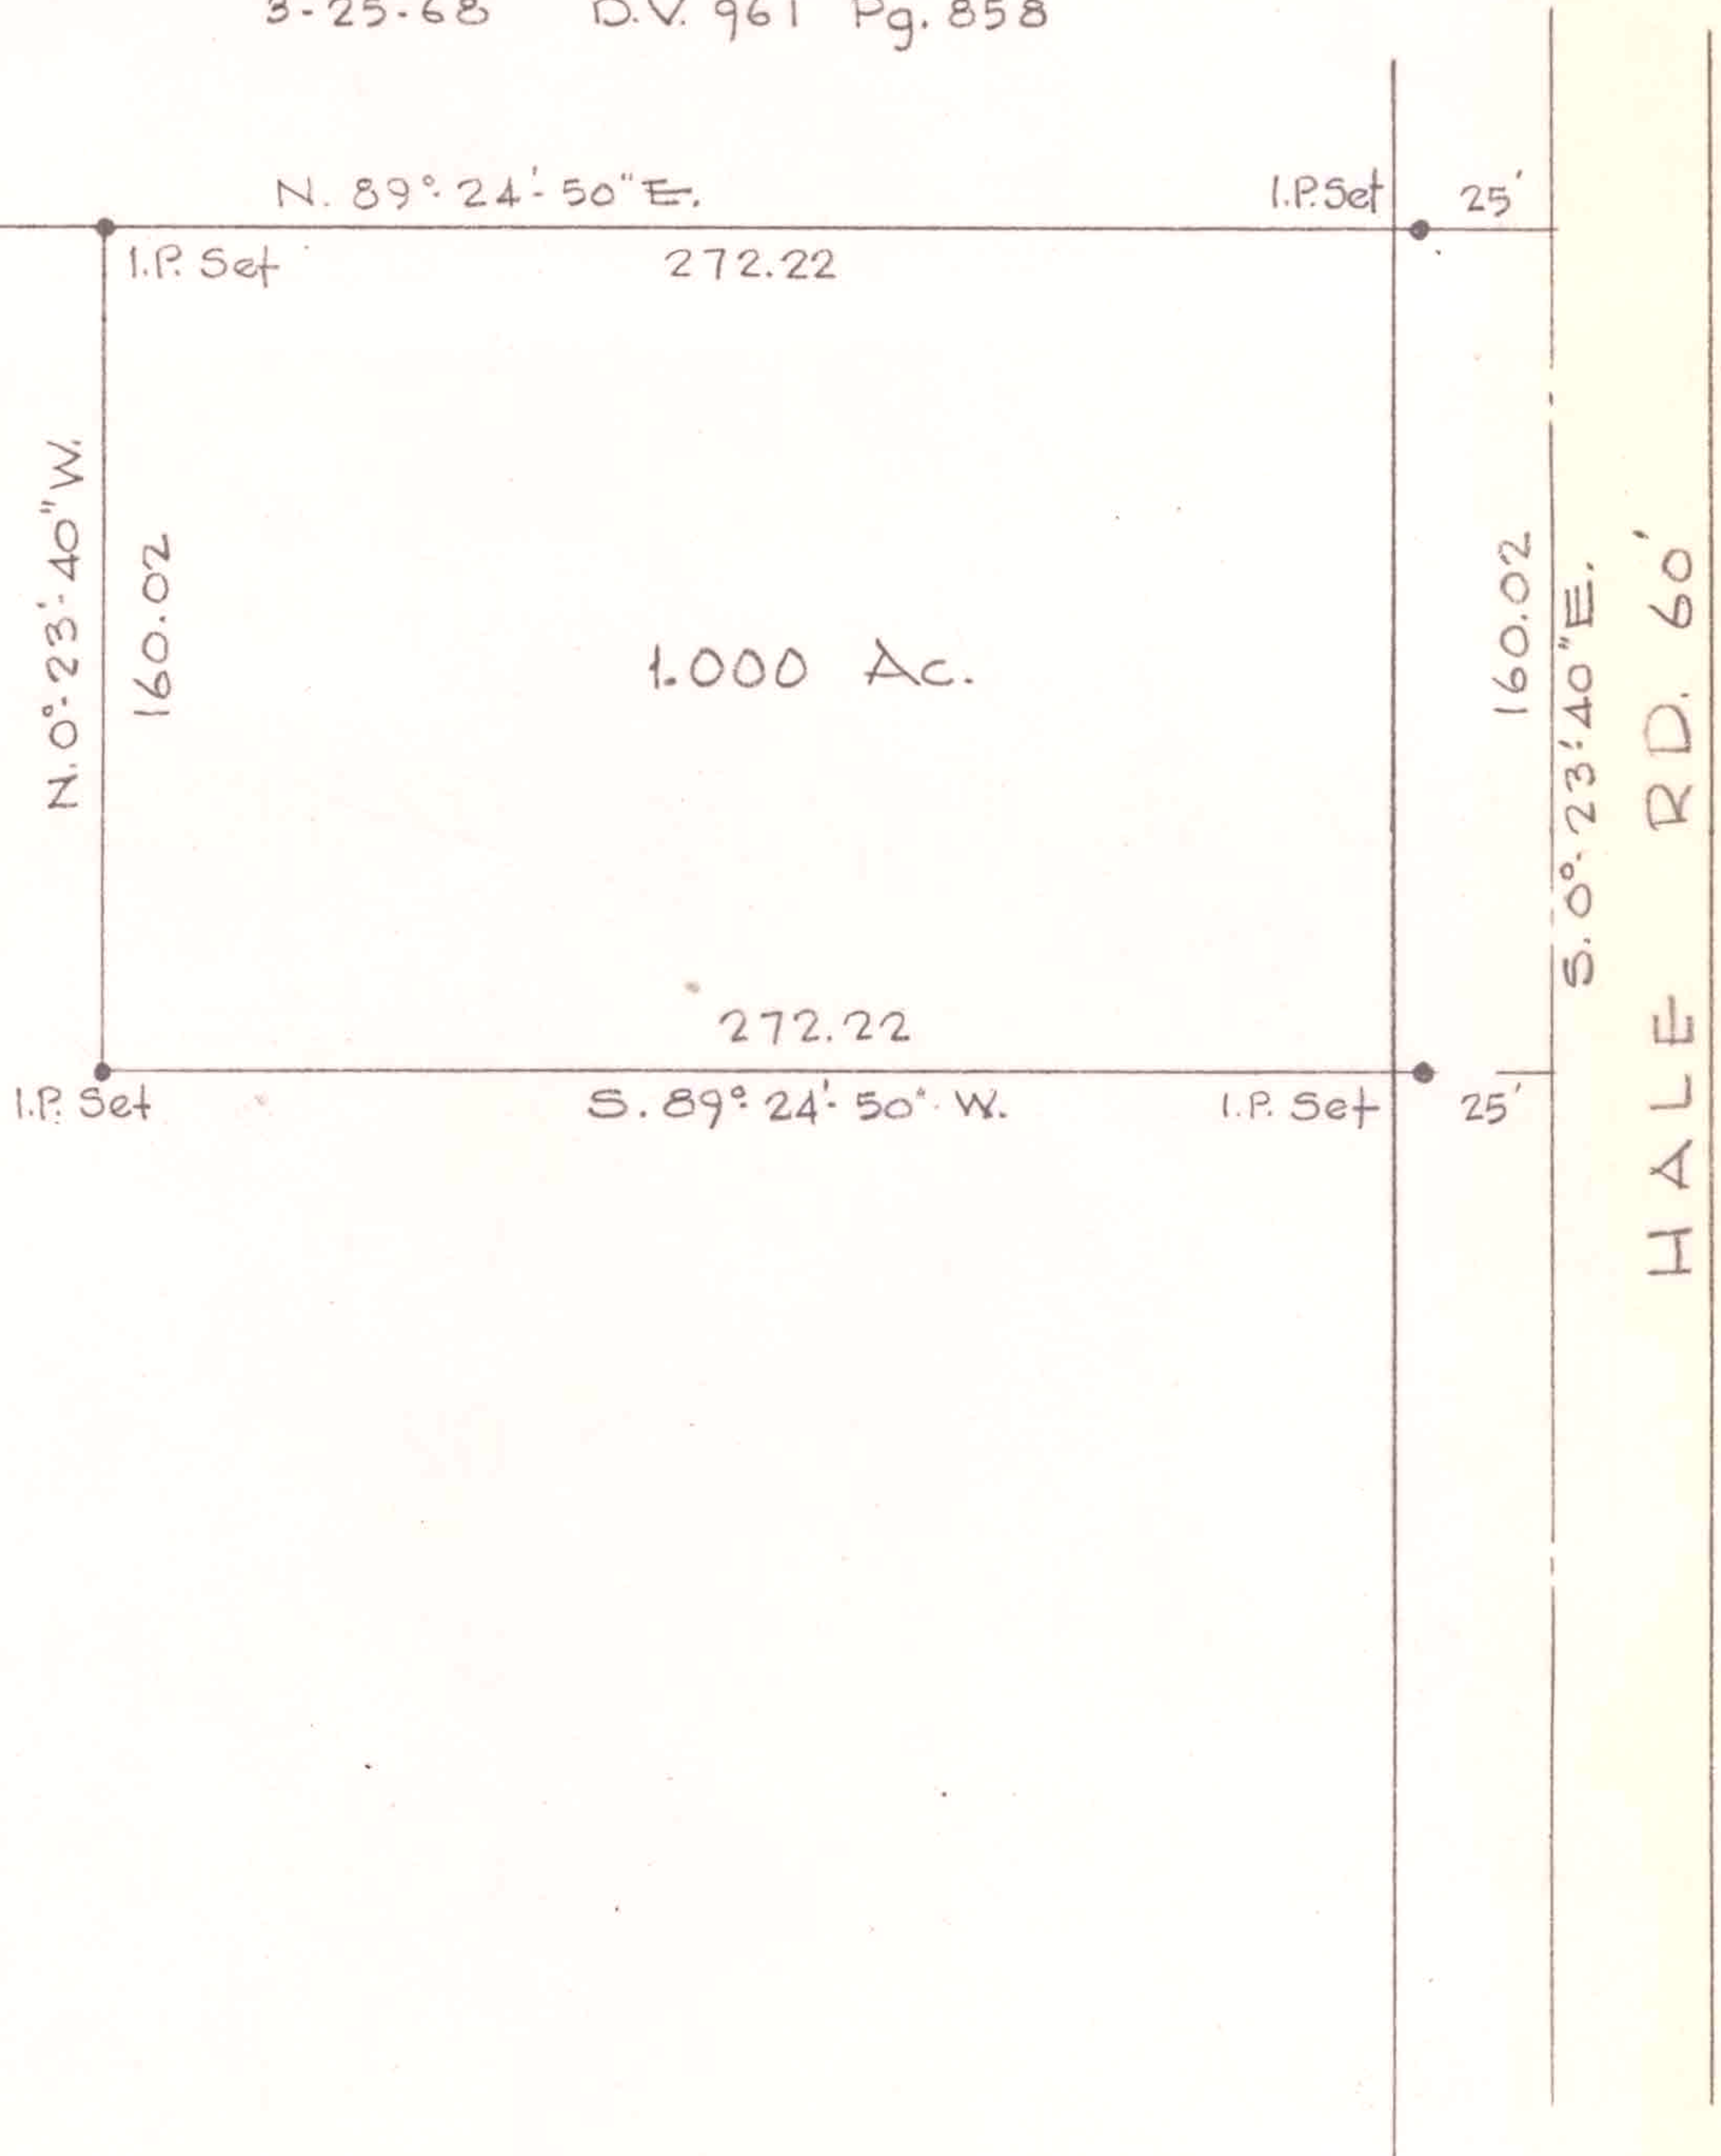

SURVEY FOR

THOMAS BROOKS

O.L. 100 RUSSIA TWP. LORAIN CO., OHIO

SCALE 1"=60'

MARCH, 1976

LAUNDON • SIMON • CAHL & ASSOC.

ENGINEERS

SURVEYORS

FB. 195/19 Job 76-471