


9-00-100-000-056
 9-00-100-000-058
 9-00-100-000-062
 9-00-100-000-066
 9-00-100-B
 Scan # 46662



HIALE RD. 60'

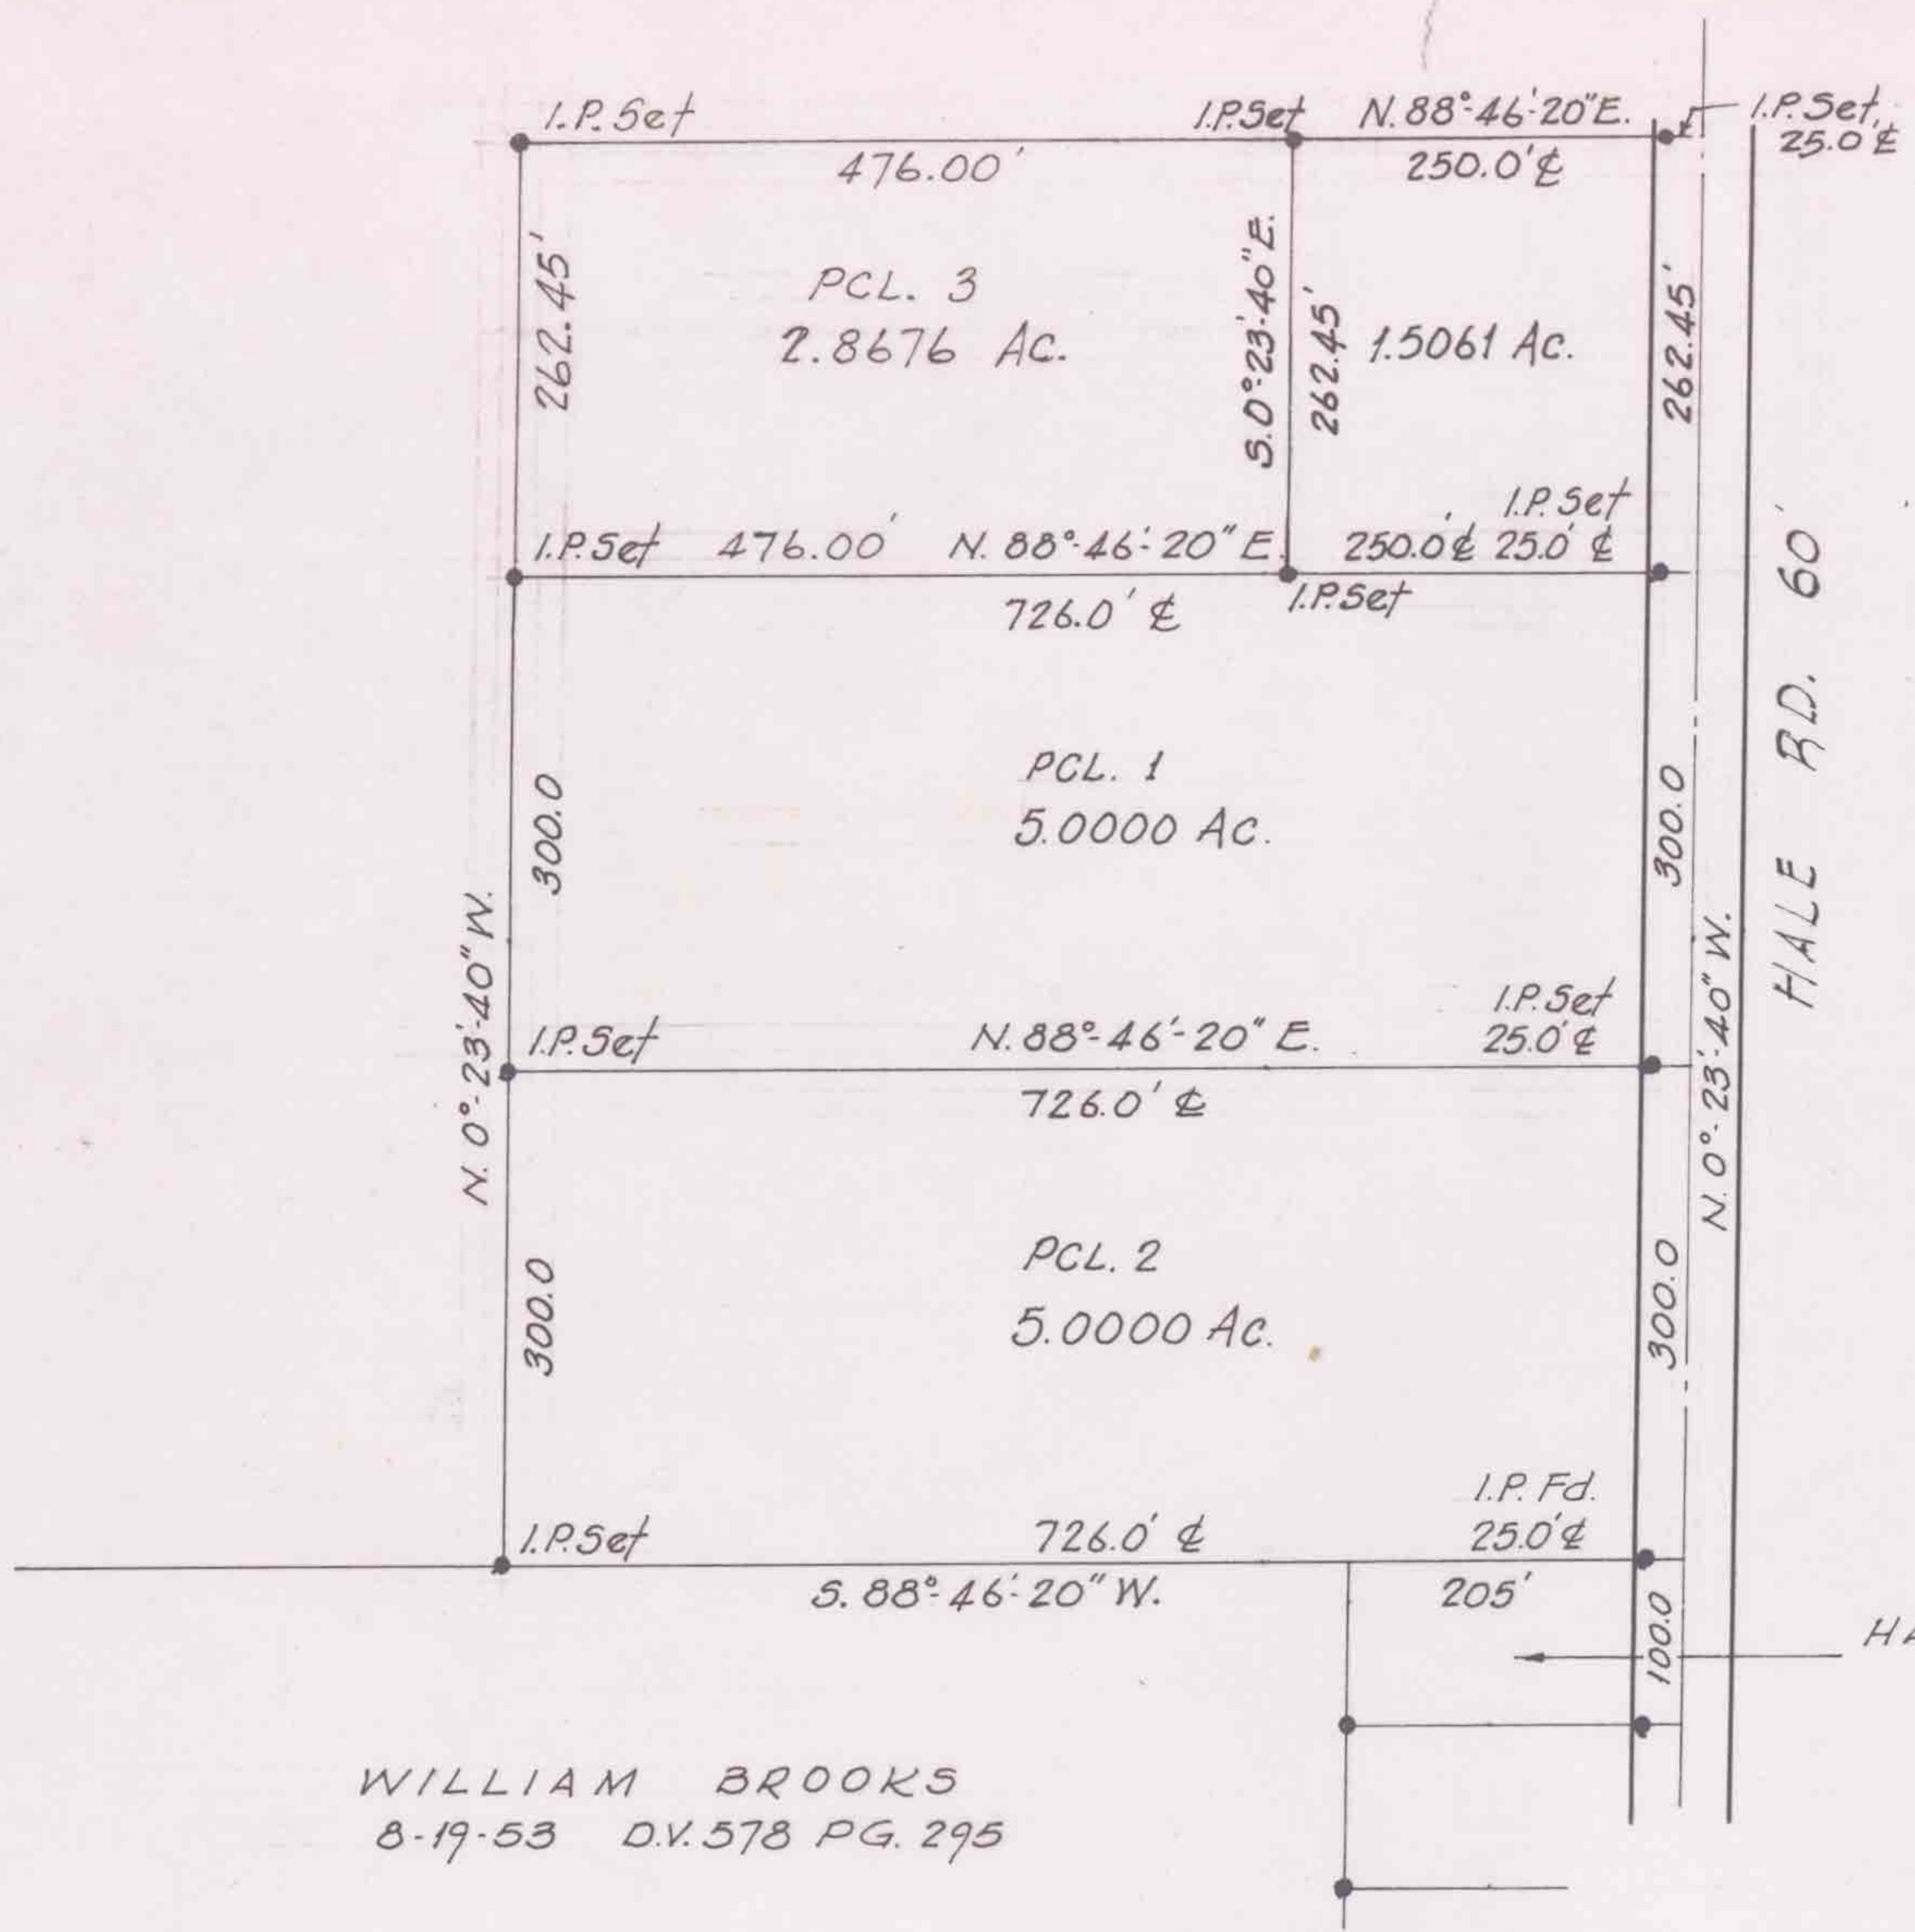

WILLIAM BROOKS
 8-19-53 D.V. 578 PG. 295

HARLAN & BERTHA RATHWELL
 1-4-57 D.V. 685 PG. 616

SURVEY FOR
ROBERT BROOKS

O.L. 100 RUSSIA TWP. LORAIN CO. OHIO

SCALE 1" = 200'

MAY 10, 1976

LAUNDON-SIMON-CAHL & ASSOC.

ENGINEERS

SURVEYORS

Rev. 1-28-82 Adn. of PCL. 3 Job No. 82-1102
 Rev. 4-22-77 Adn. of 1.5061 p.c.l.

F.B. 195/19 JOB No 76-492