


10-00-003-102-022

10-00-003-102-023

10-00-003-A

Scan#

Aug 71

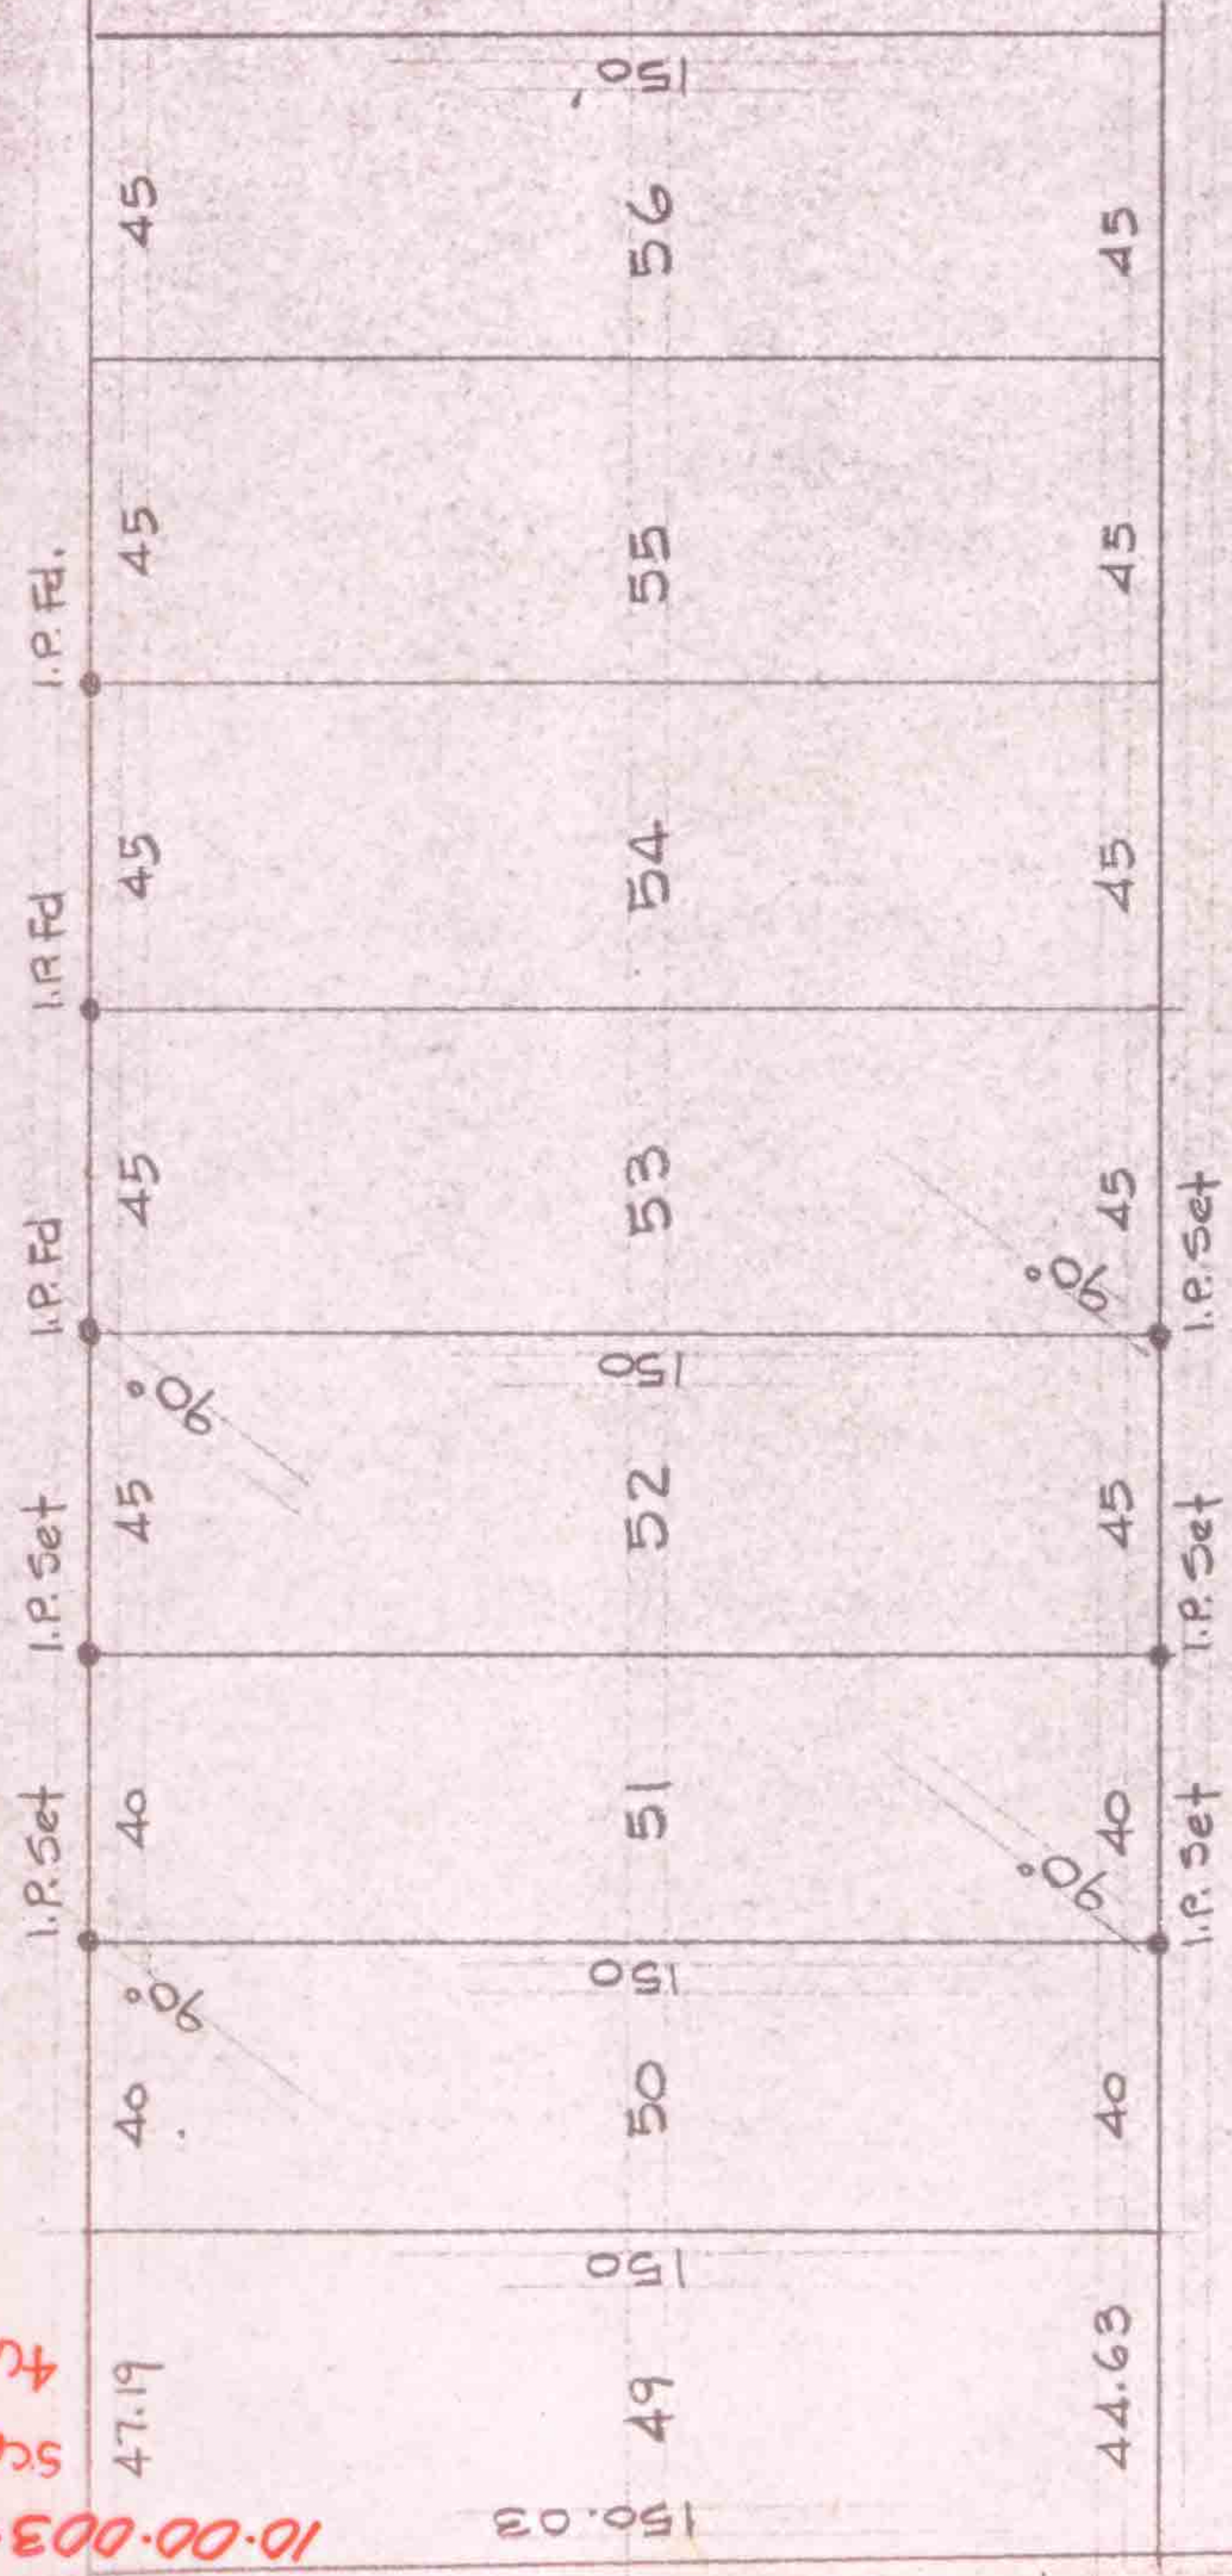

DOUGLAS ST. 50'

19th St. 50'



SURVEY FOR ELYRIA BUSINESS BENEFIT INC.

S/L 51 & 52 BIRMINGHAM PARK ADDN. P.V. 7-45

CITY OF ELYRIA LORAIN COUNTY OHIO

SCALE 1"=50' MARCH, 1975

LAUNDON, SIMON, CAHL & ASSOC.

ENGINEERS

SURVEYORS