


Agnes M. Resar
5-14-69 D.V. 985 Pg. 58
10-00-015-104-005
10-00-015-D

Betty # 1944

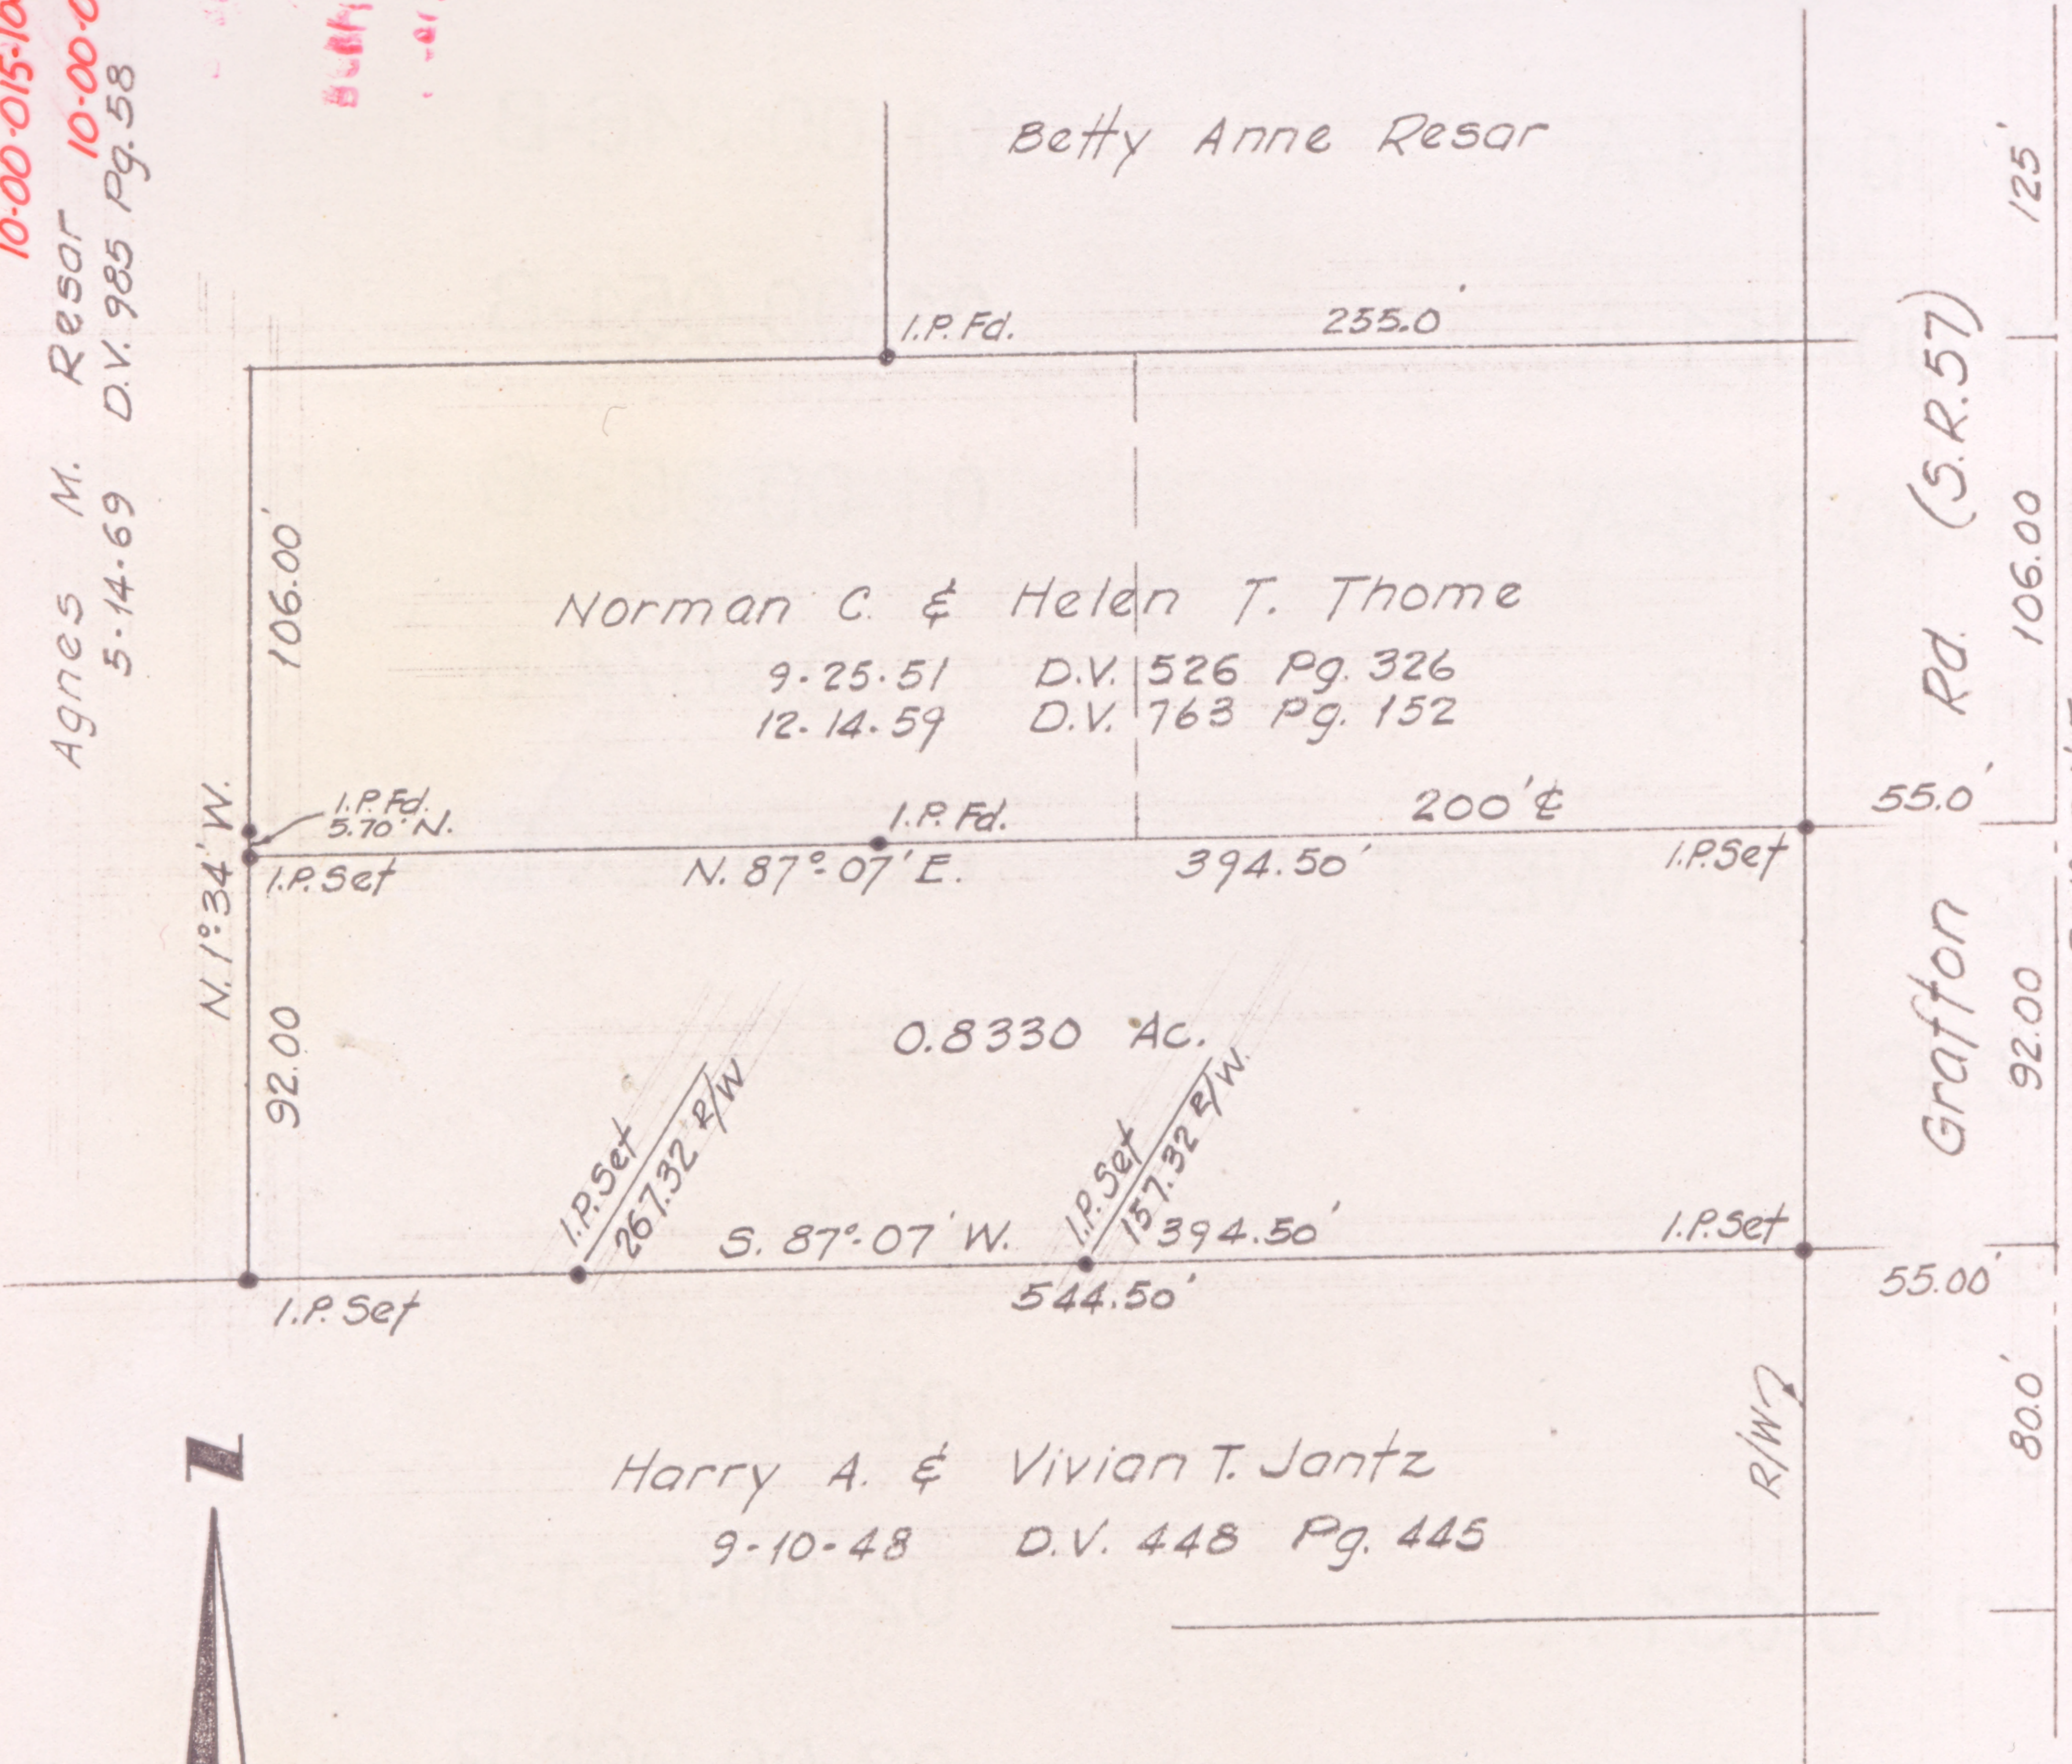

Harry A. & Vivian T. Jantz
9-10-48 D.V. 448 Pg. 445

Survey for Joseph & Marjorie Black
 Section 15 Carlisle Twp.
 Lorain County Ohio
 September, 1975 Scale 1"=60'
 Laudon • Simon • Cohl & Assoc.
 Engineers Surveyors