


11-00-018-000-035
11-00-018-B
SCAN # 46710

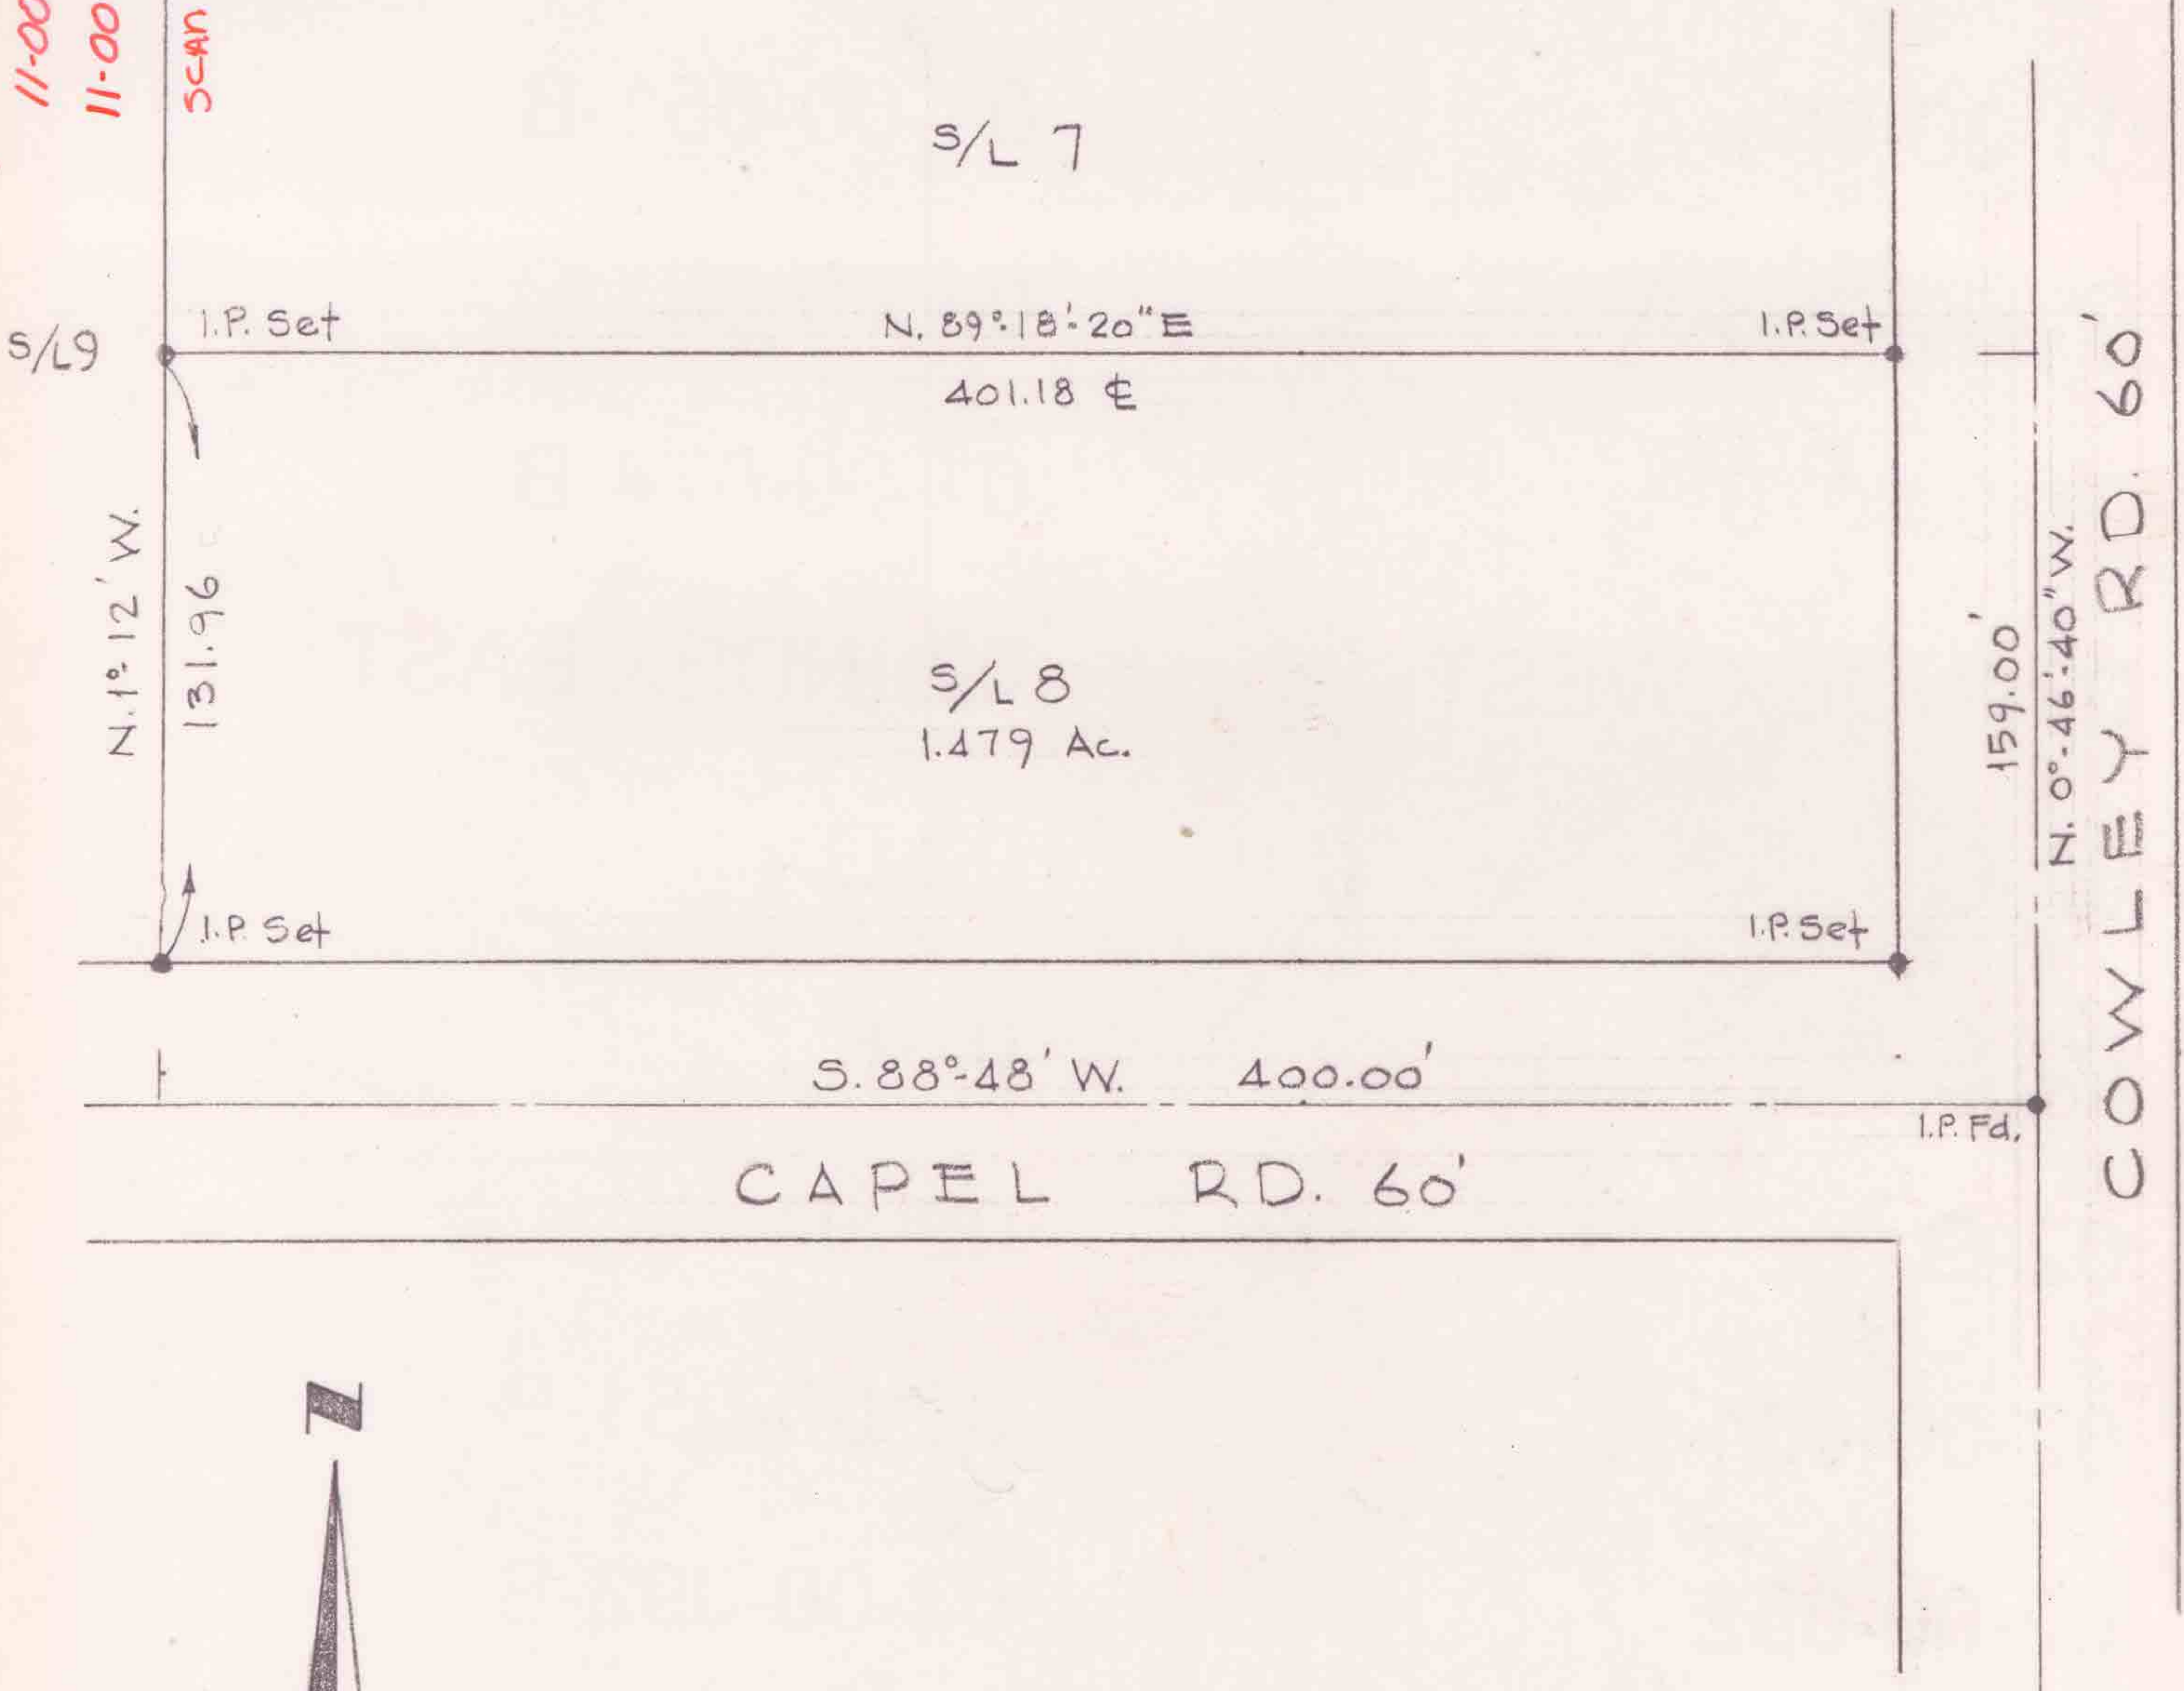

SURVEY FOR
WILLIAM and BERTHA THOMAS
S/L 8 CLEARBROOK ACRES P.V. 17 PG. 7
O.L. 18 EATON TWP. LORAIN CO., OHIO
SCALE 1"=60' MARCH, 1976
LAUNDON • SIMON • CAHL & ASSOC.
ENGINEERS SURVEYORS