


11-00-040-000
11-00-040-B
PARCEL NOT ON TAX MAP
SCAN # 46715

O.L. 39
O.L. 40

ROBERT L. + TACY L. DENNISON
7-27-56 D.V. 671 P. 26

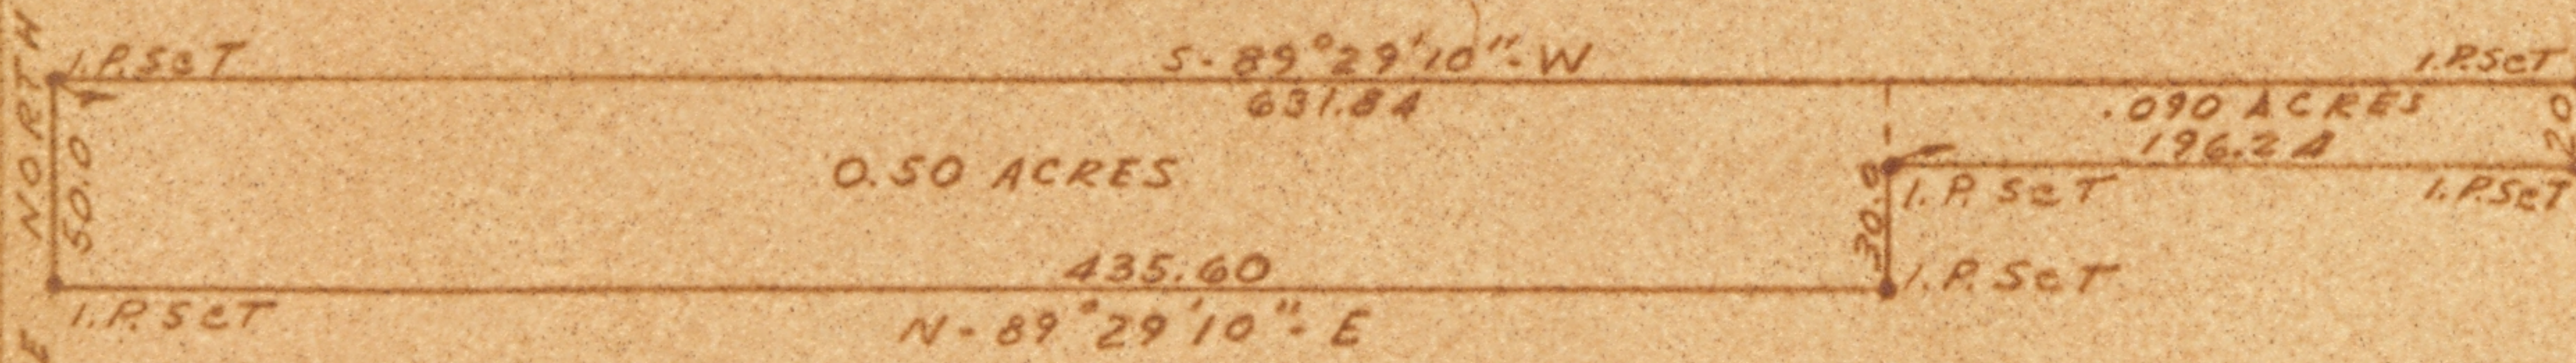

ELEANOR BAKER
4-22-49 D.V. 463 P. 467

NOTE: .590 ACRES TOTAL



ISLAND DUE NORTH ROAD 60

SURVEY FOR
MRS. MASTNY
PART O.L. 40 EATON TWP
LORAIN COUNTY OHIO
SCALE 1"=100' NOV. 1959
LAUNDON & HUFFMAN
REG SURVEYORS