



11-00-044-000
 11-G
 PARCEL NOT ON MAP
 SCAN #46717

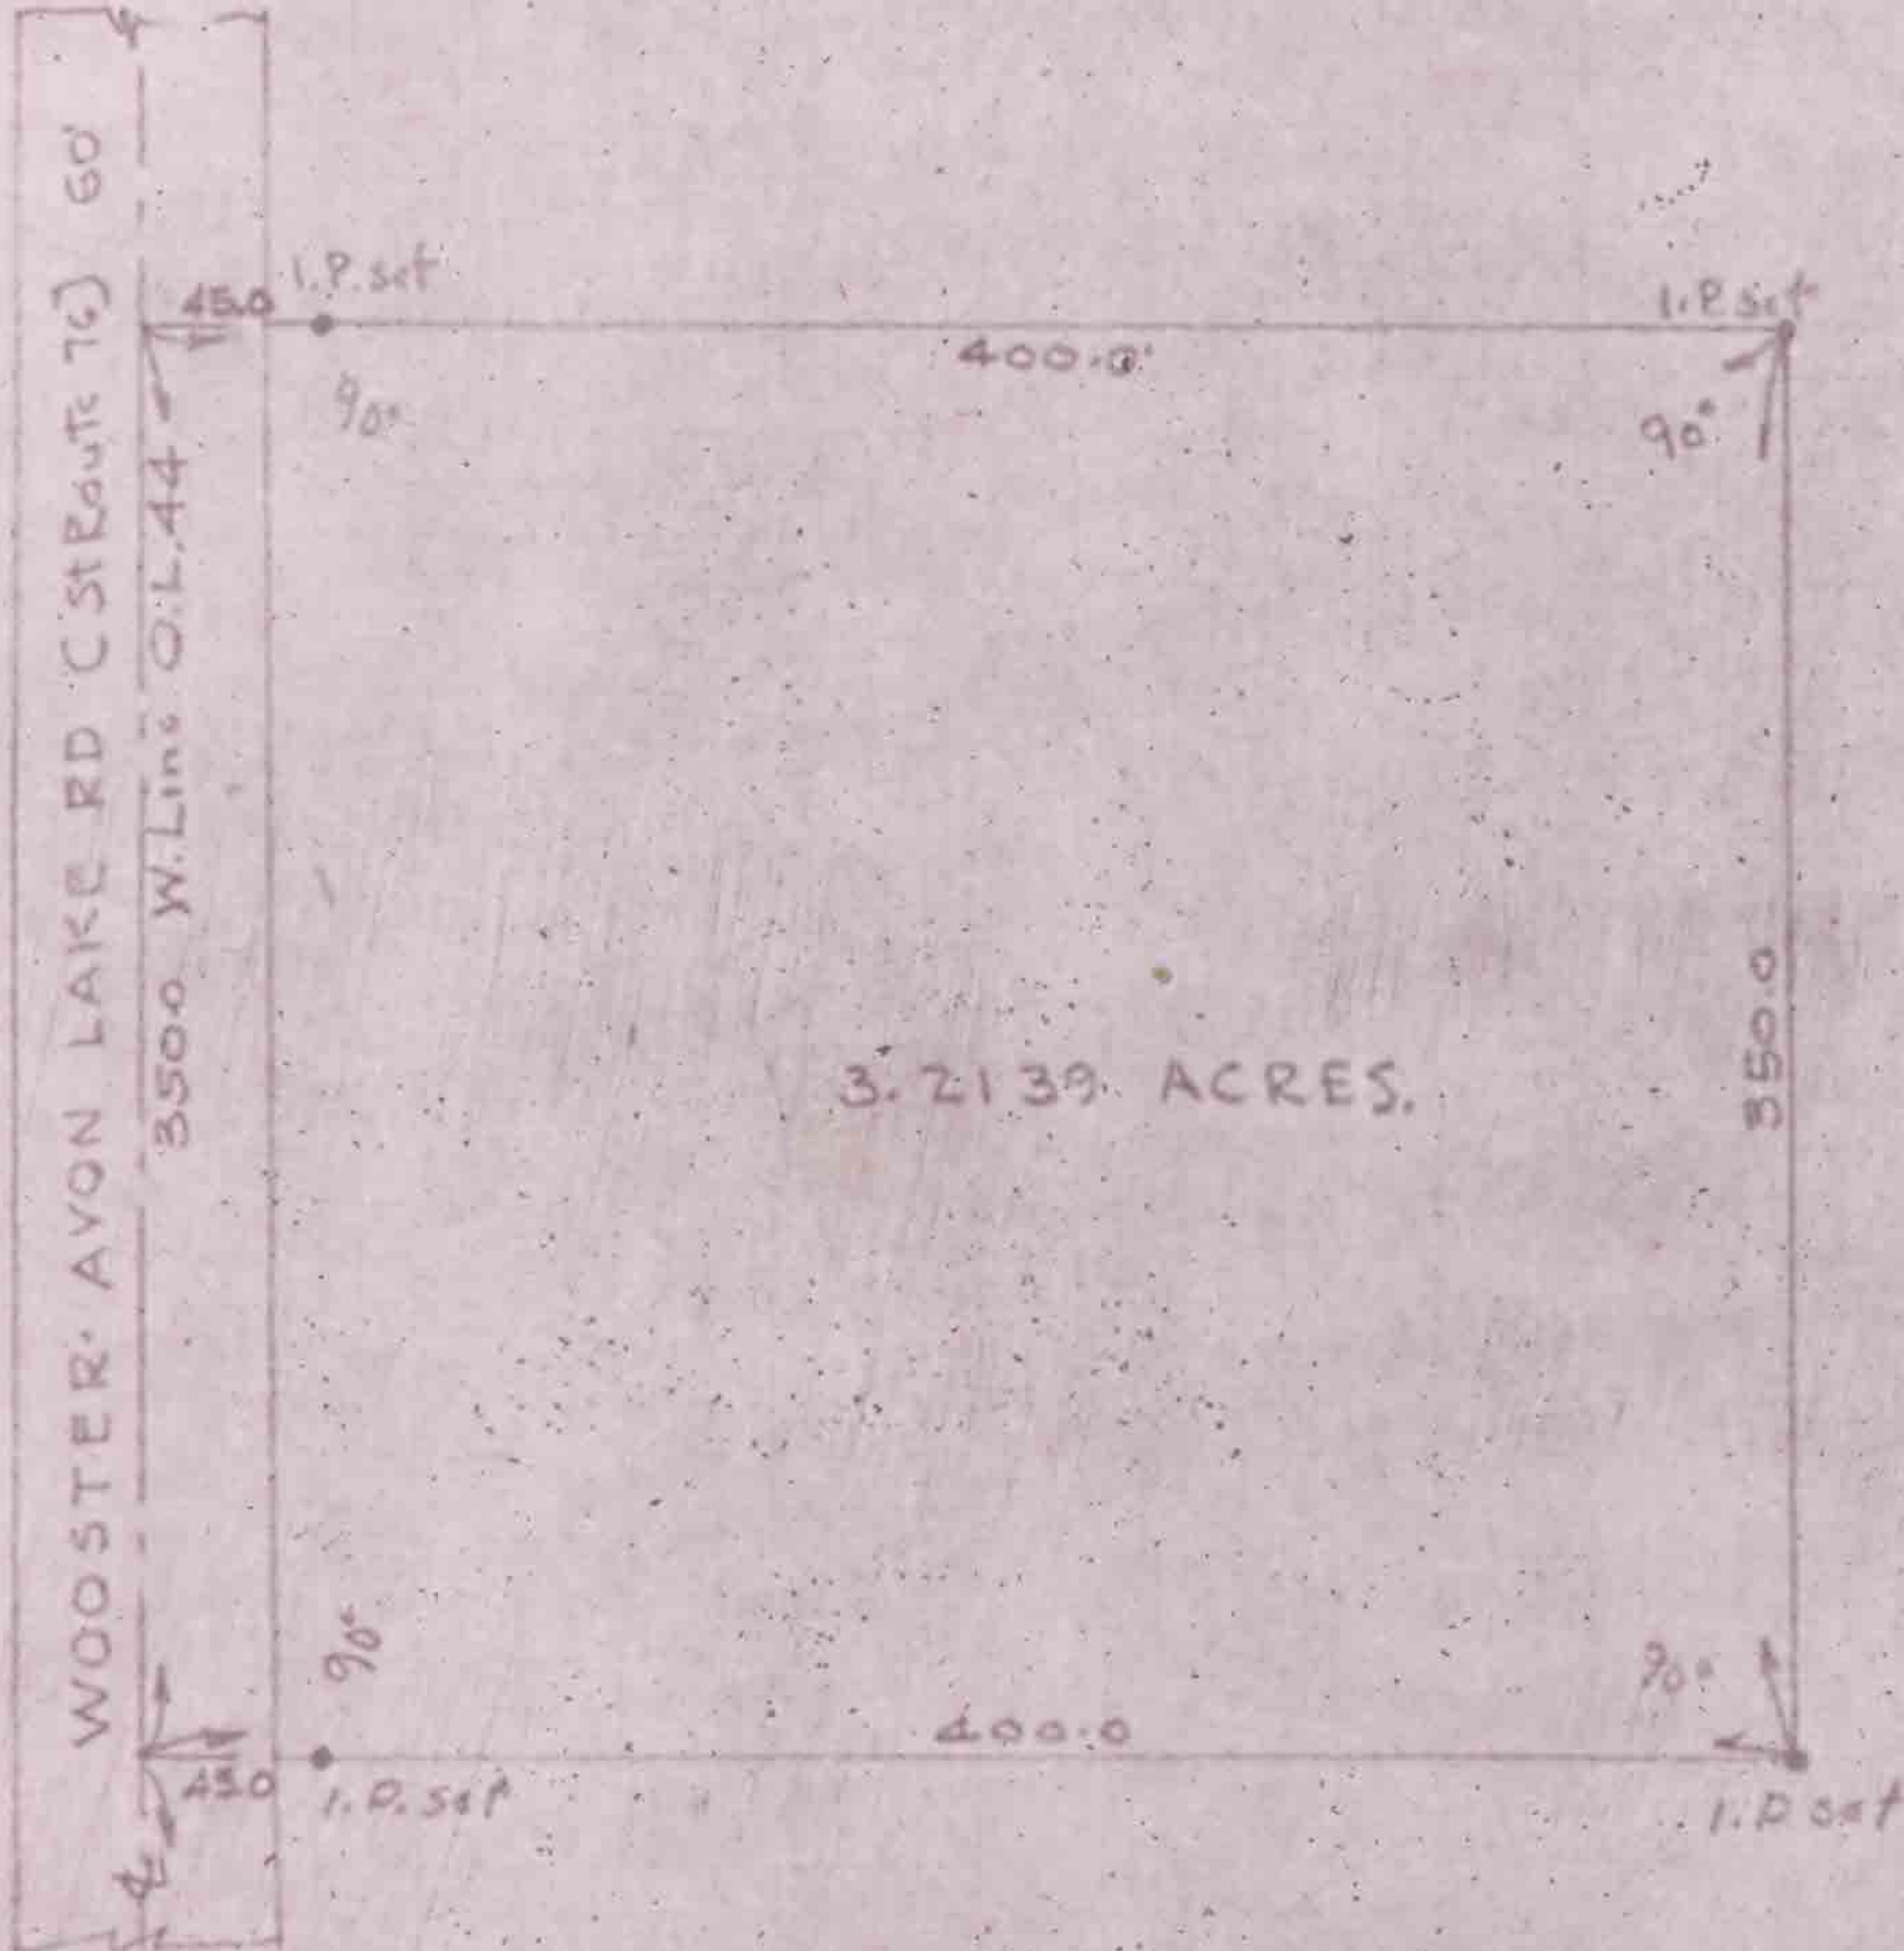

3.2139 ACRES.

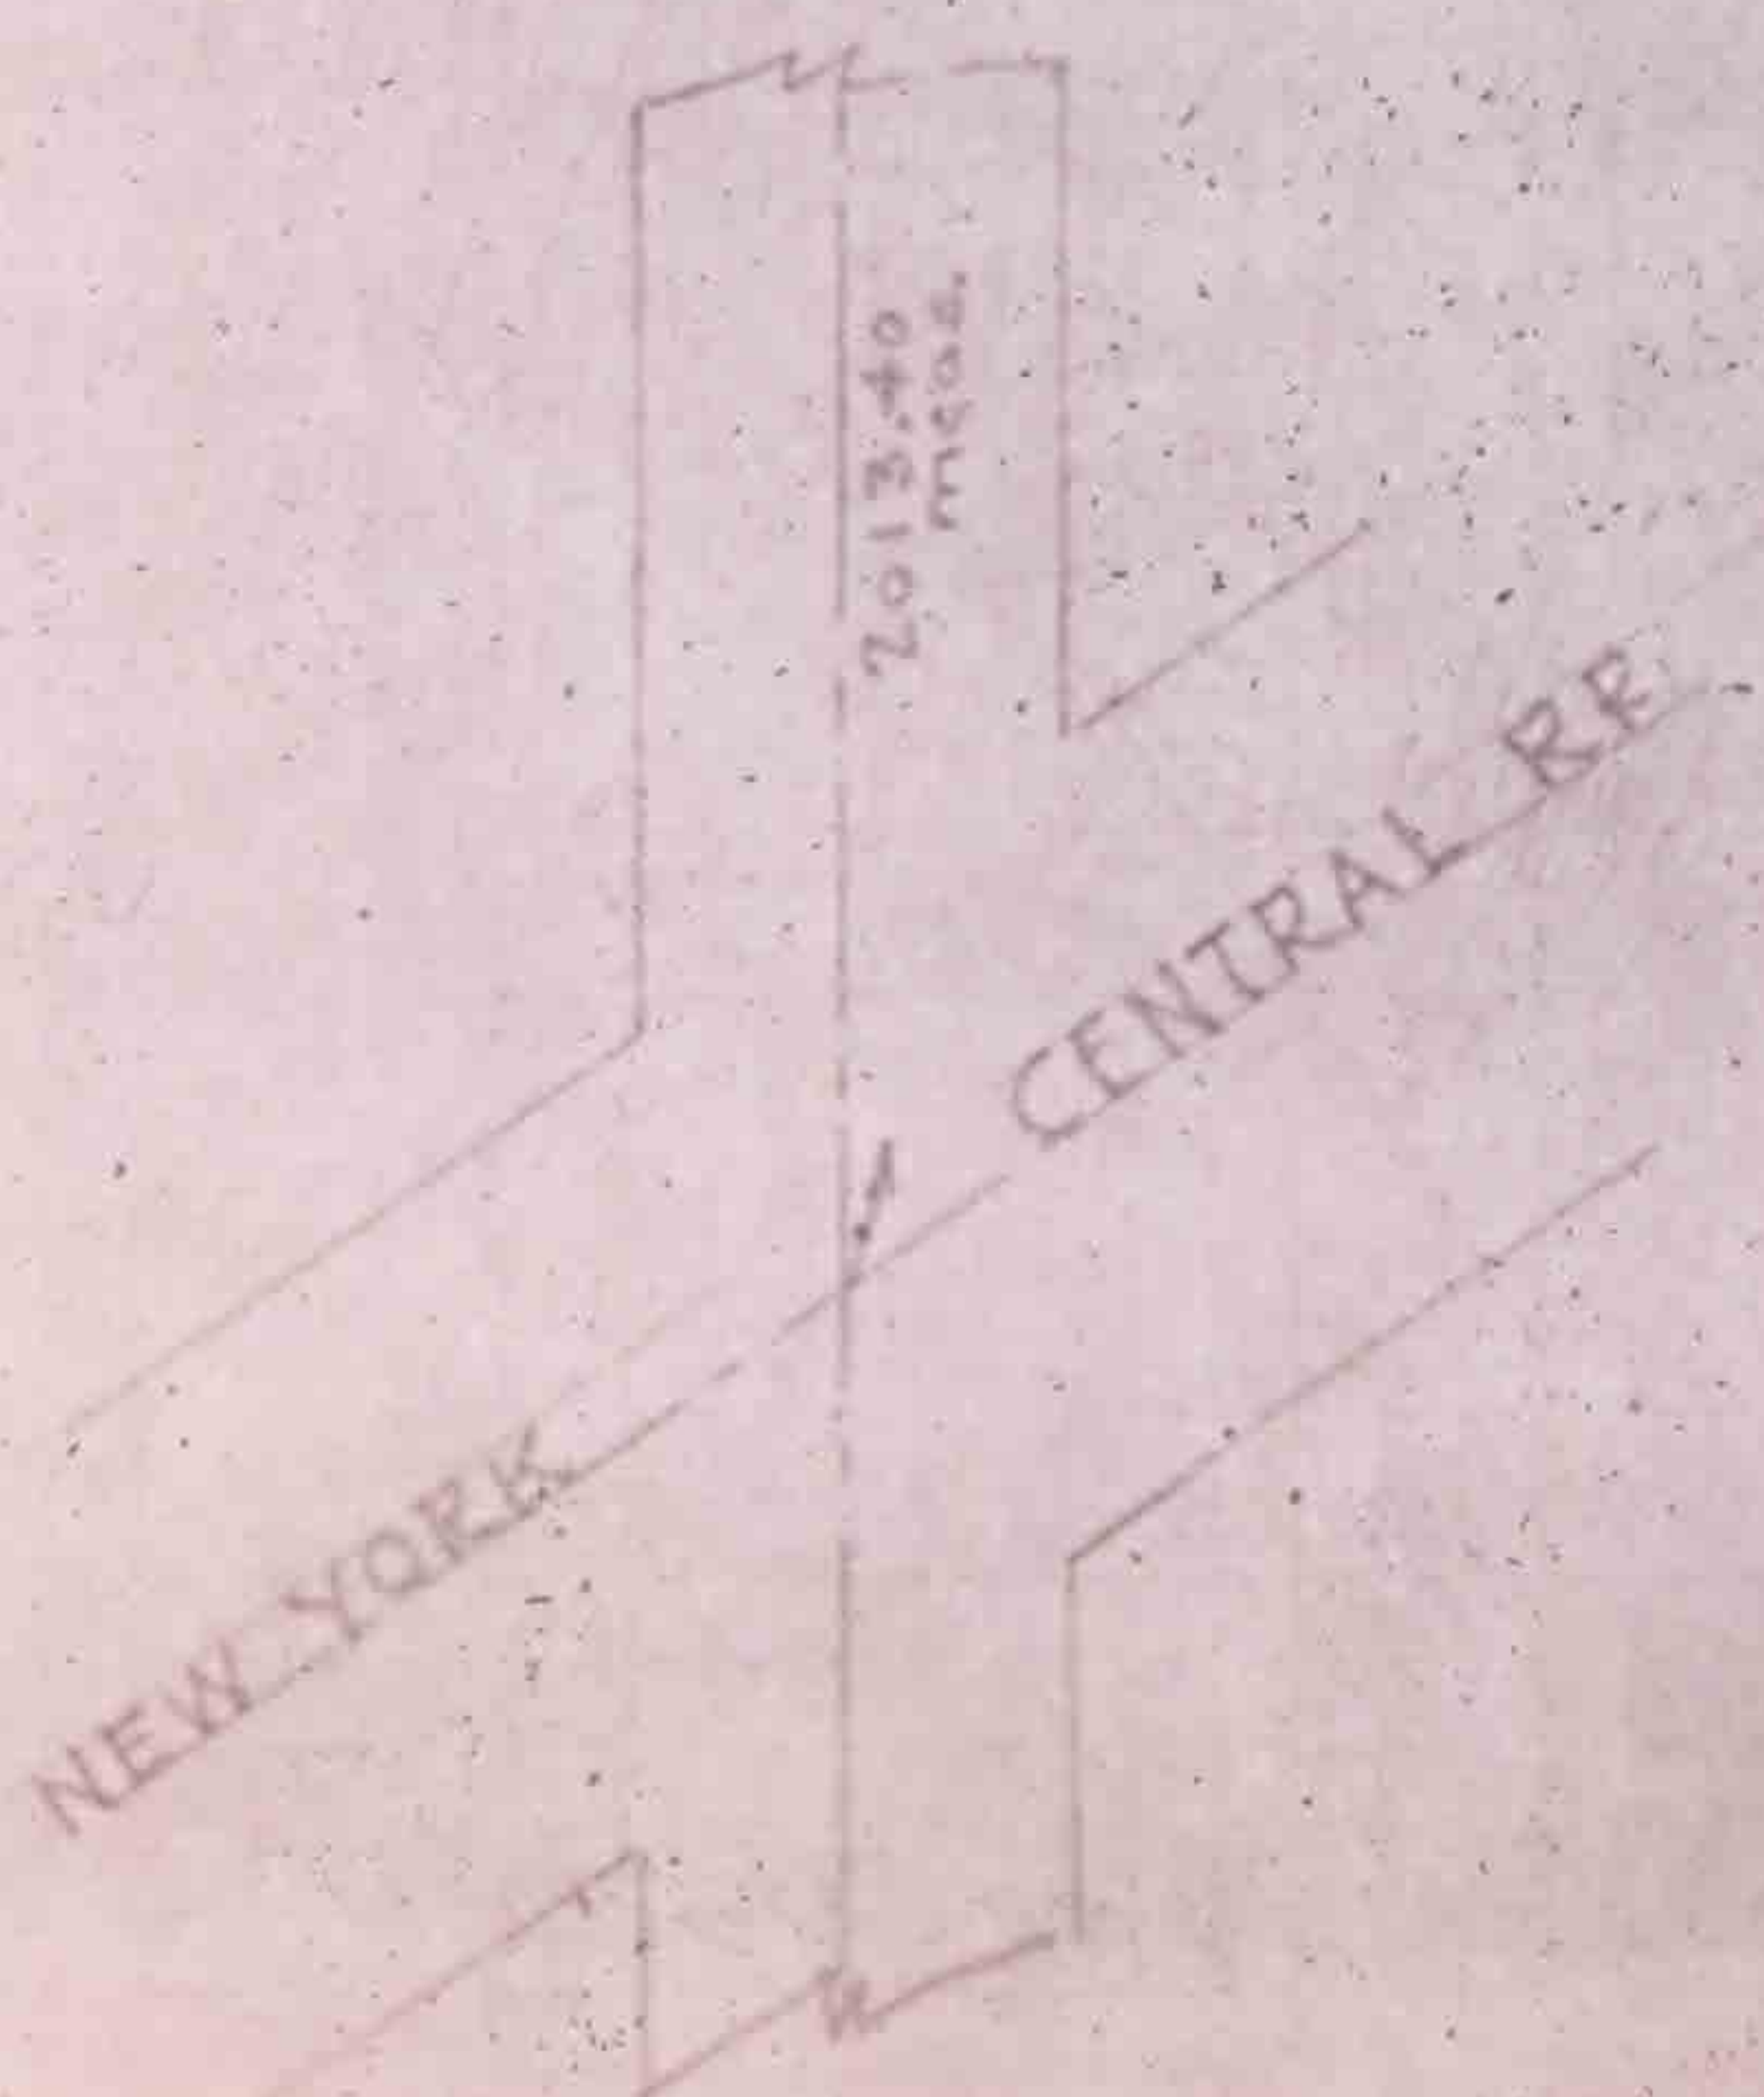

SURVEY FOR
 THE FRIEDMAN LAND DEVELOPMENT
 PART OF ORIG LOT 44 EATON TWP
 LORAIN CO. OHIO SCALE 1"=100'
 LAUNDON & HUFFMAN SURVEYORS
 OCT 1959.