


FREDERICK E. LAWRENCE
D.V. 722 Pg. 1

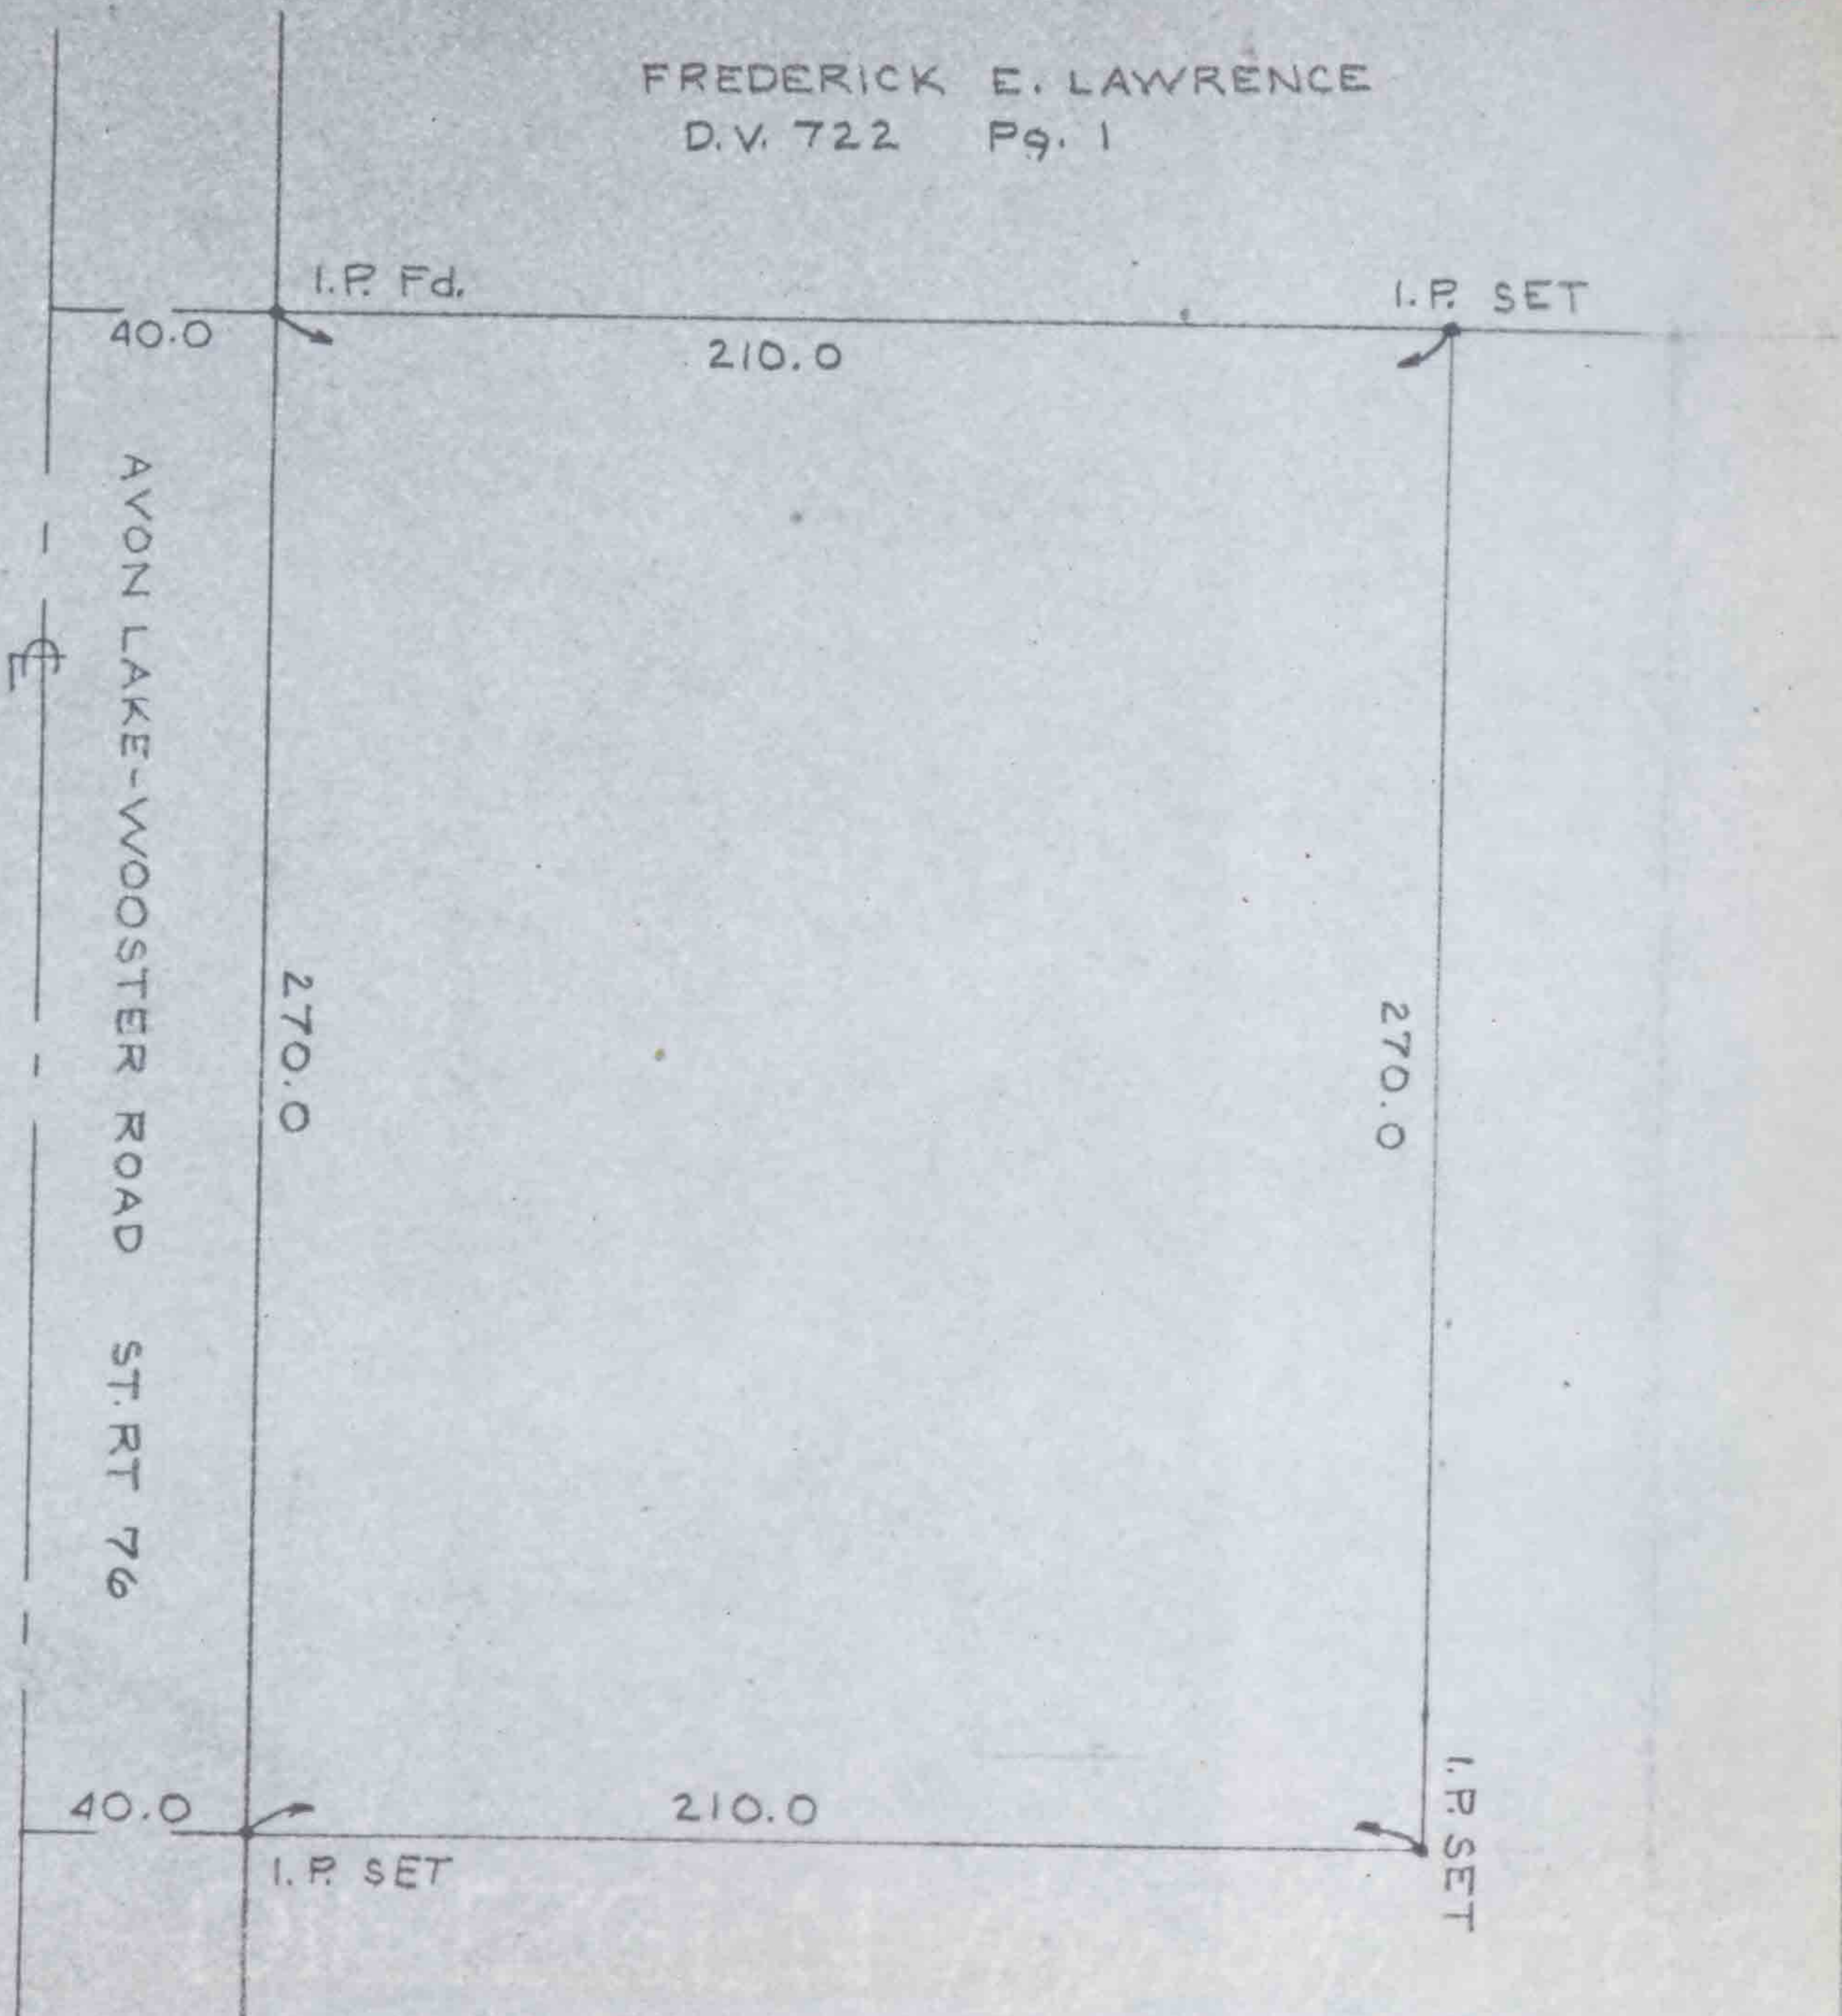

SURVEY FOR J.R. STAPLES
 O.L. 49 EATON TWP. LORAIN CO. OHIO
 SCALE: 1" = 50'
 OCTOBER 1962
 LAUNDON & HUFFMAN
 REG. SURVEYORS