


110-171-100-530
1100-071-A

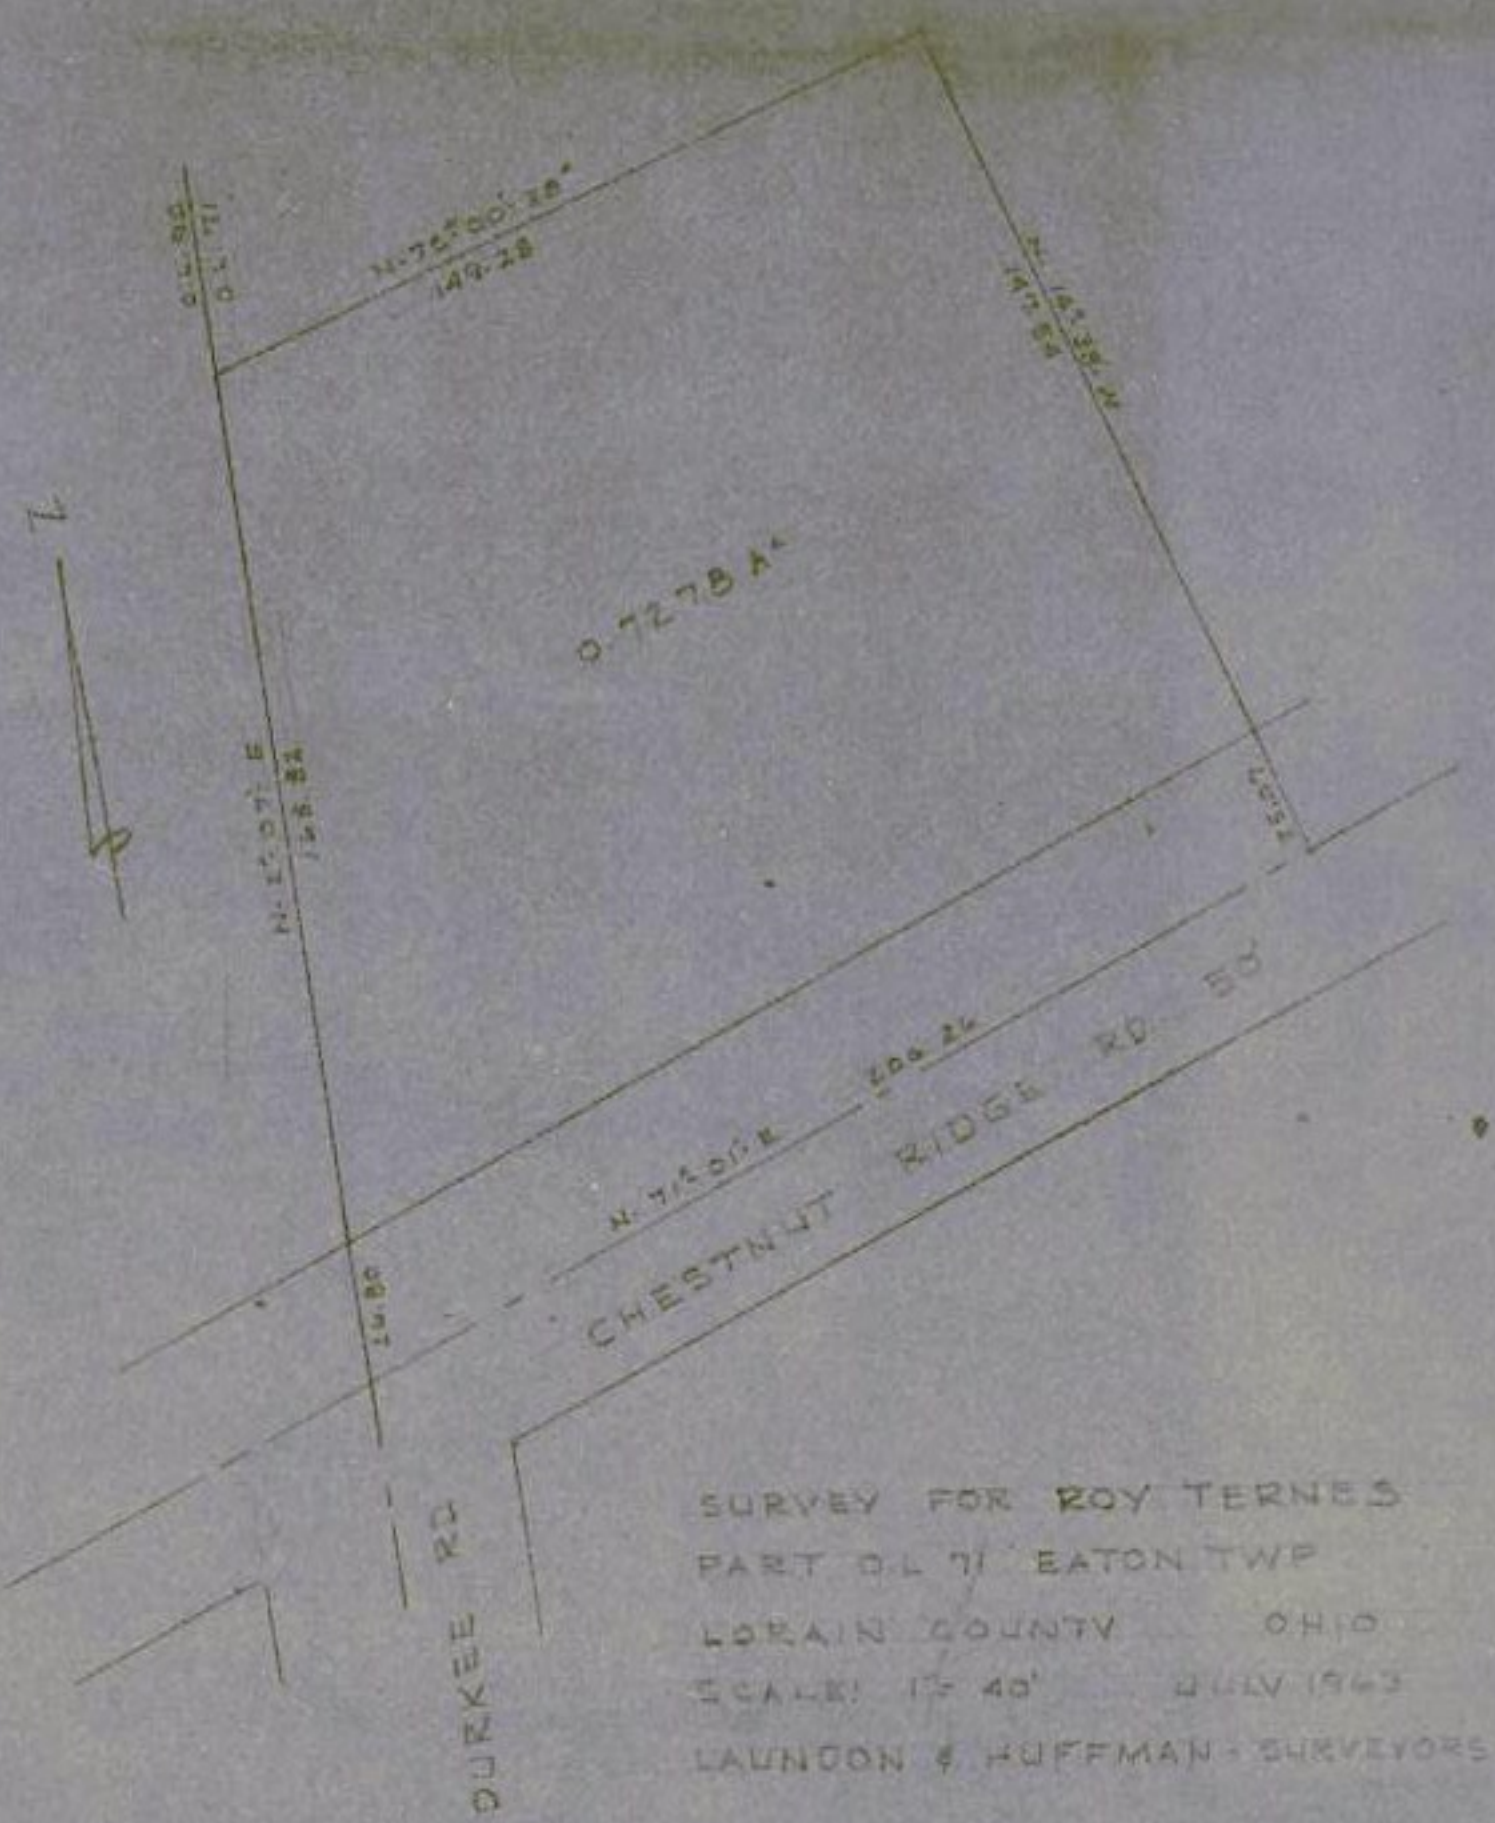

SURVEY FOR ROY TERNES
 PART O.L. 71 EATON TWP
 LORAIN COUNTY OHIO
 SCALE: 1" = 40' JULY 1963
 LAUNSON & HUFFMAN - SURVEYORS