

11-00-090-000-010
11-A
SCAN # 46743.....

BENDER RD. 40'

CHESTNUT RIDGE RD. 60'
N. 66°-21'E.
478.03

109.55

I.P. Set

I.P. Set

R.R.S.

RICHARD J. & BARBARA J. GIBBONS
MAR. 28, 1962 DV. 818-238

HAZEL KONSESKY
NOV. 13, 1962 DV. 836-173

N. 0°-27' E. 733.86

S. 0°-27' W. 778.75

1.7362 Ac.

RAYMOND E. & HAZEL BURKE ET AL
OCT. 20, 1944 DV. 357-87


I.P. fd.

420.74
N. 89°-27' W.

O.L. 90 I.P. Set
O.L. 89

5' 100.0

I.P. Set

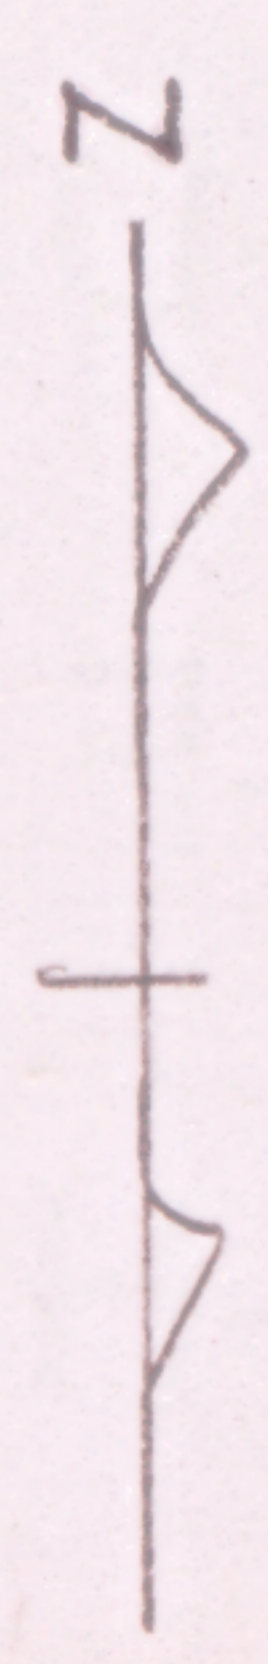

SURVEY FOR IRVIN SCHILDT
O.L. 90 EATON TOWNSHIP
LORAIN COUNTY OHIO
SCALE 1" = 100' MARCH, 1965
LAUNDON, HUFFMAN & SIMON - SURVEYORS