


12-00-057-000-004
SCAN#46787 12-B


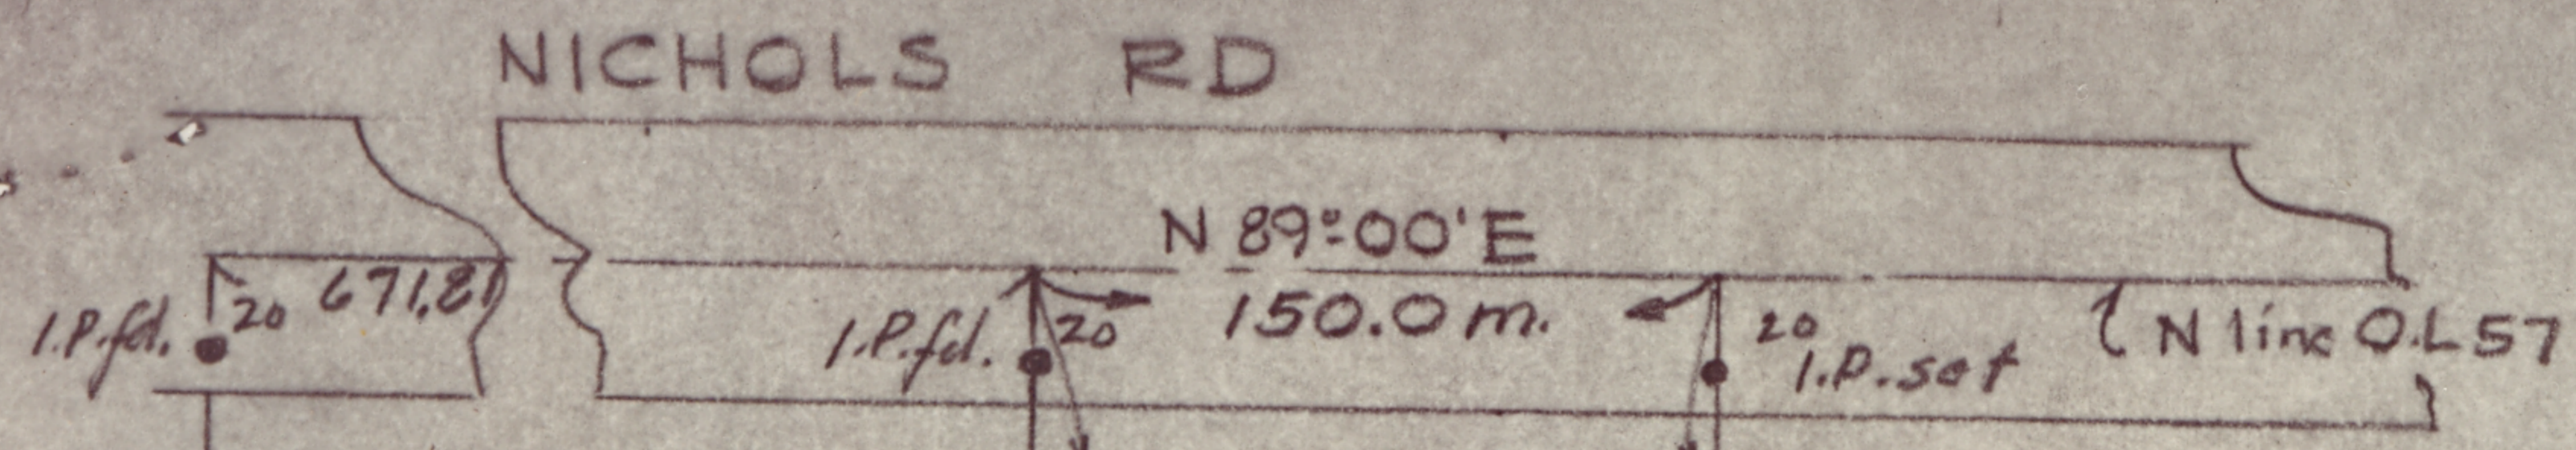


LOUISE, M. HUNTER D.V. 408-89 2-26-47

S 0°18'30"E 764.25

N 0°18'30"W 764.25

2.631 AC.

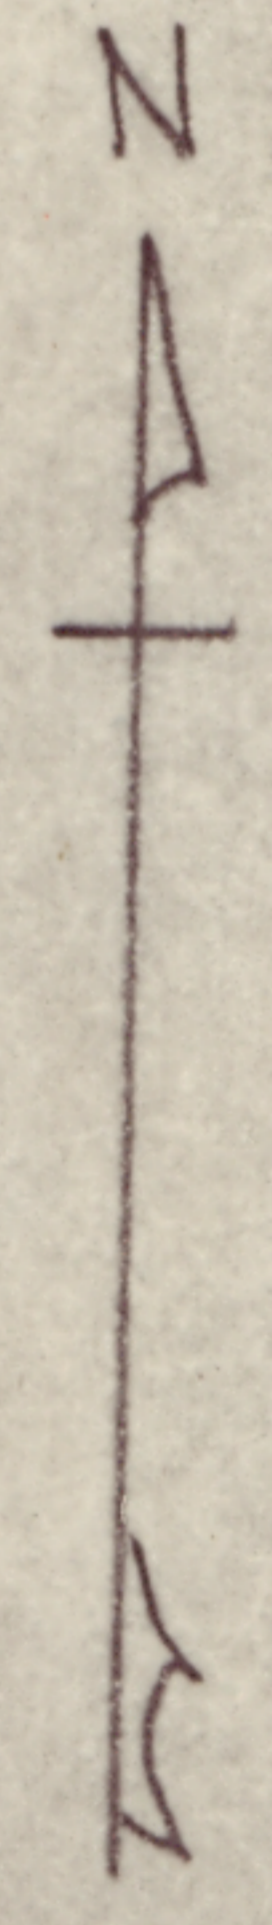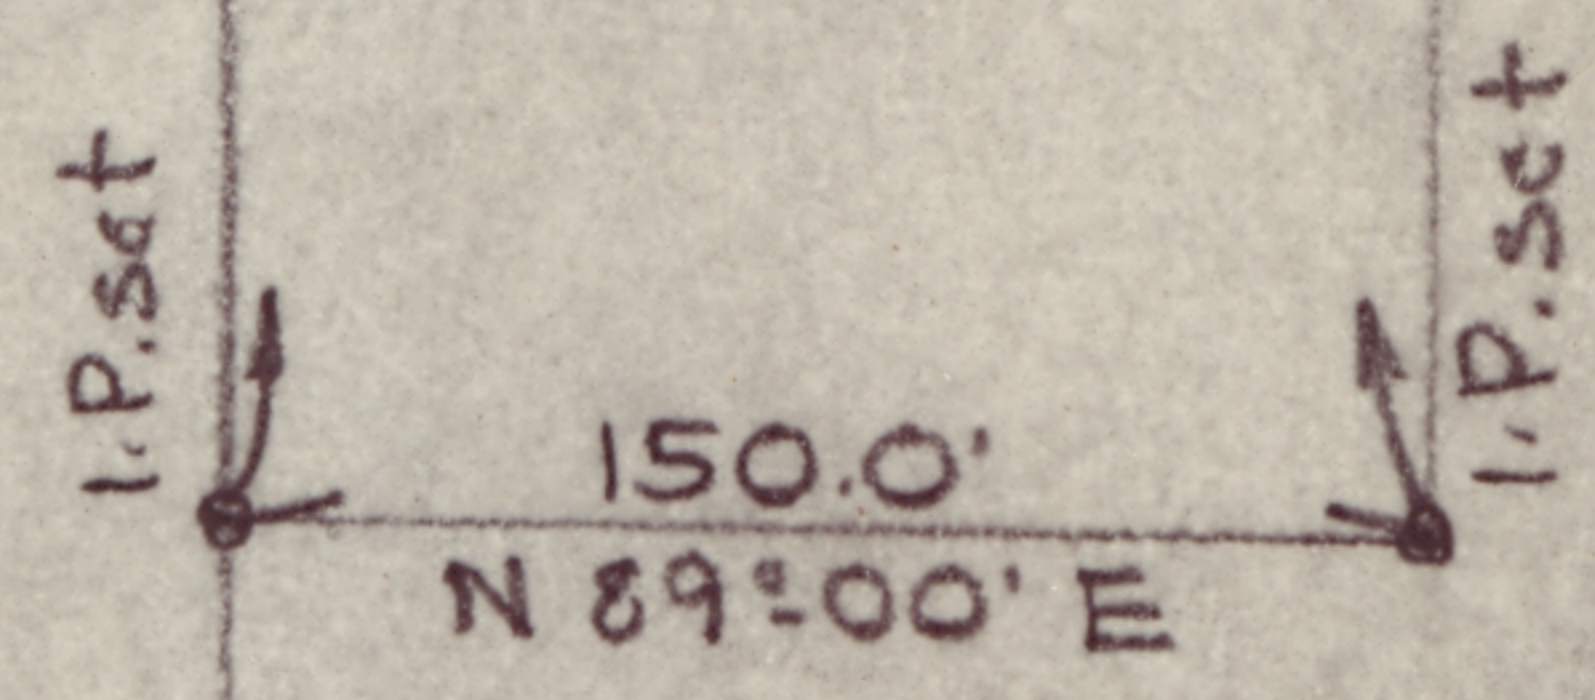

SURVEY OF 2.631 ACRE PARCEL
BERTHA V. WRIGHT FARM,
PART OF O.L. 57 COLUMBIA TWP
LORAIN CO, OHIO SCALE 1"=100'
NOV. 14, 1950 T.W. LAUNDON REG. SURVEYOR