


13-11-005-000-011
13-11-005
Scan # 46800

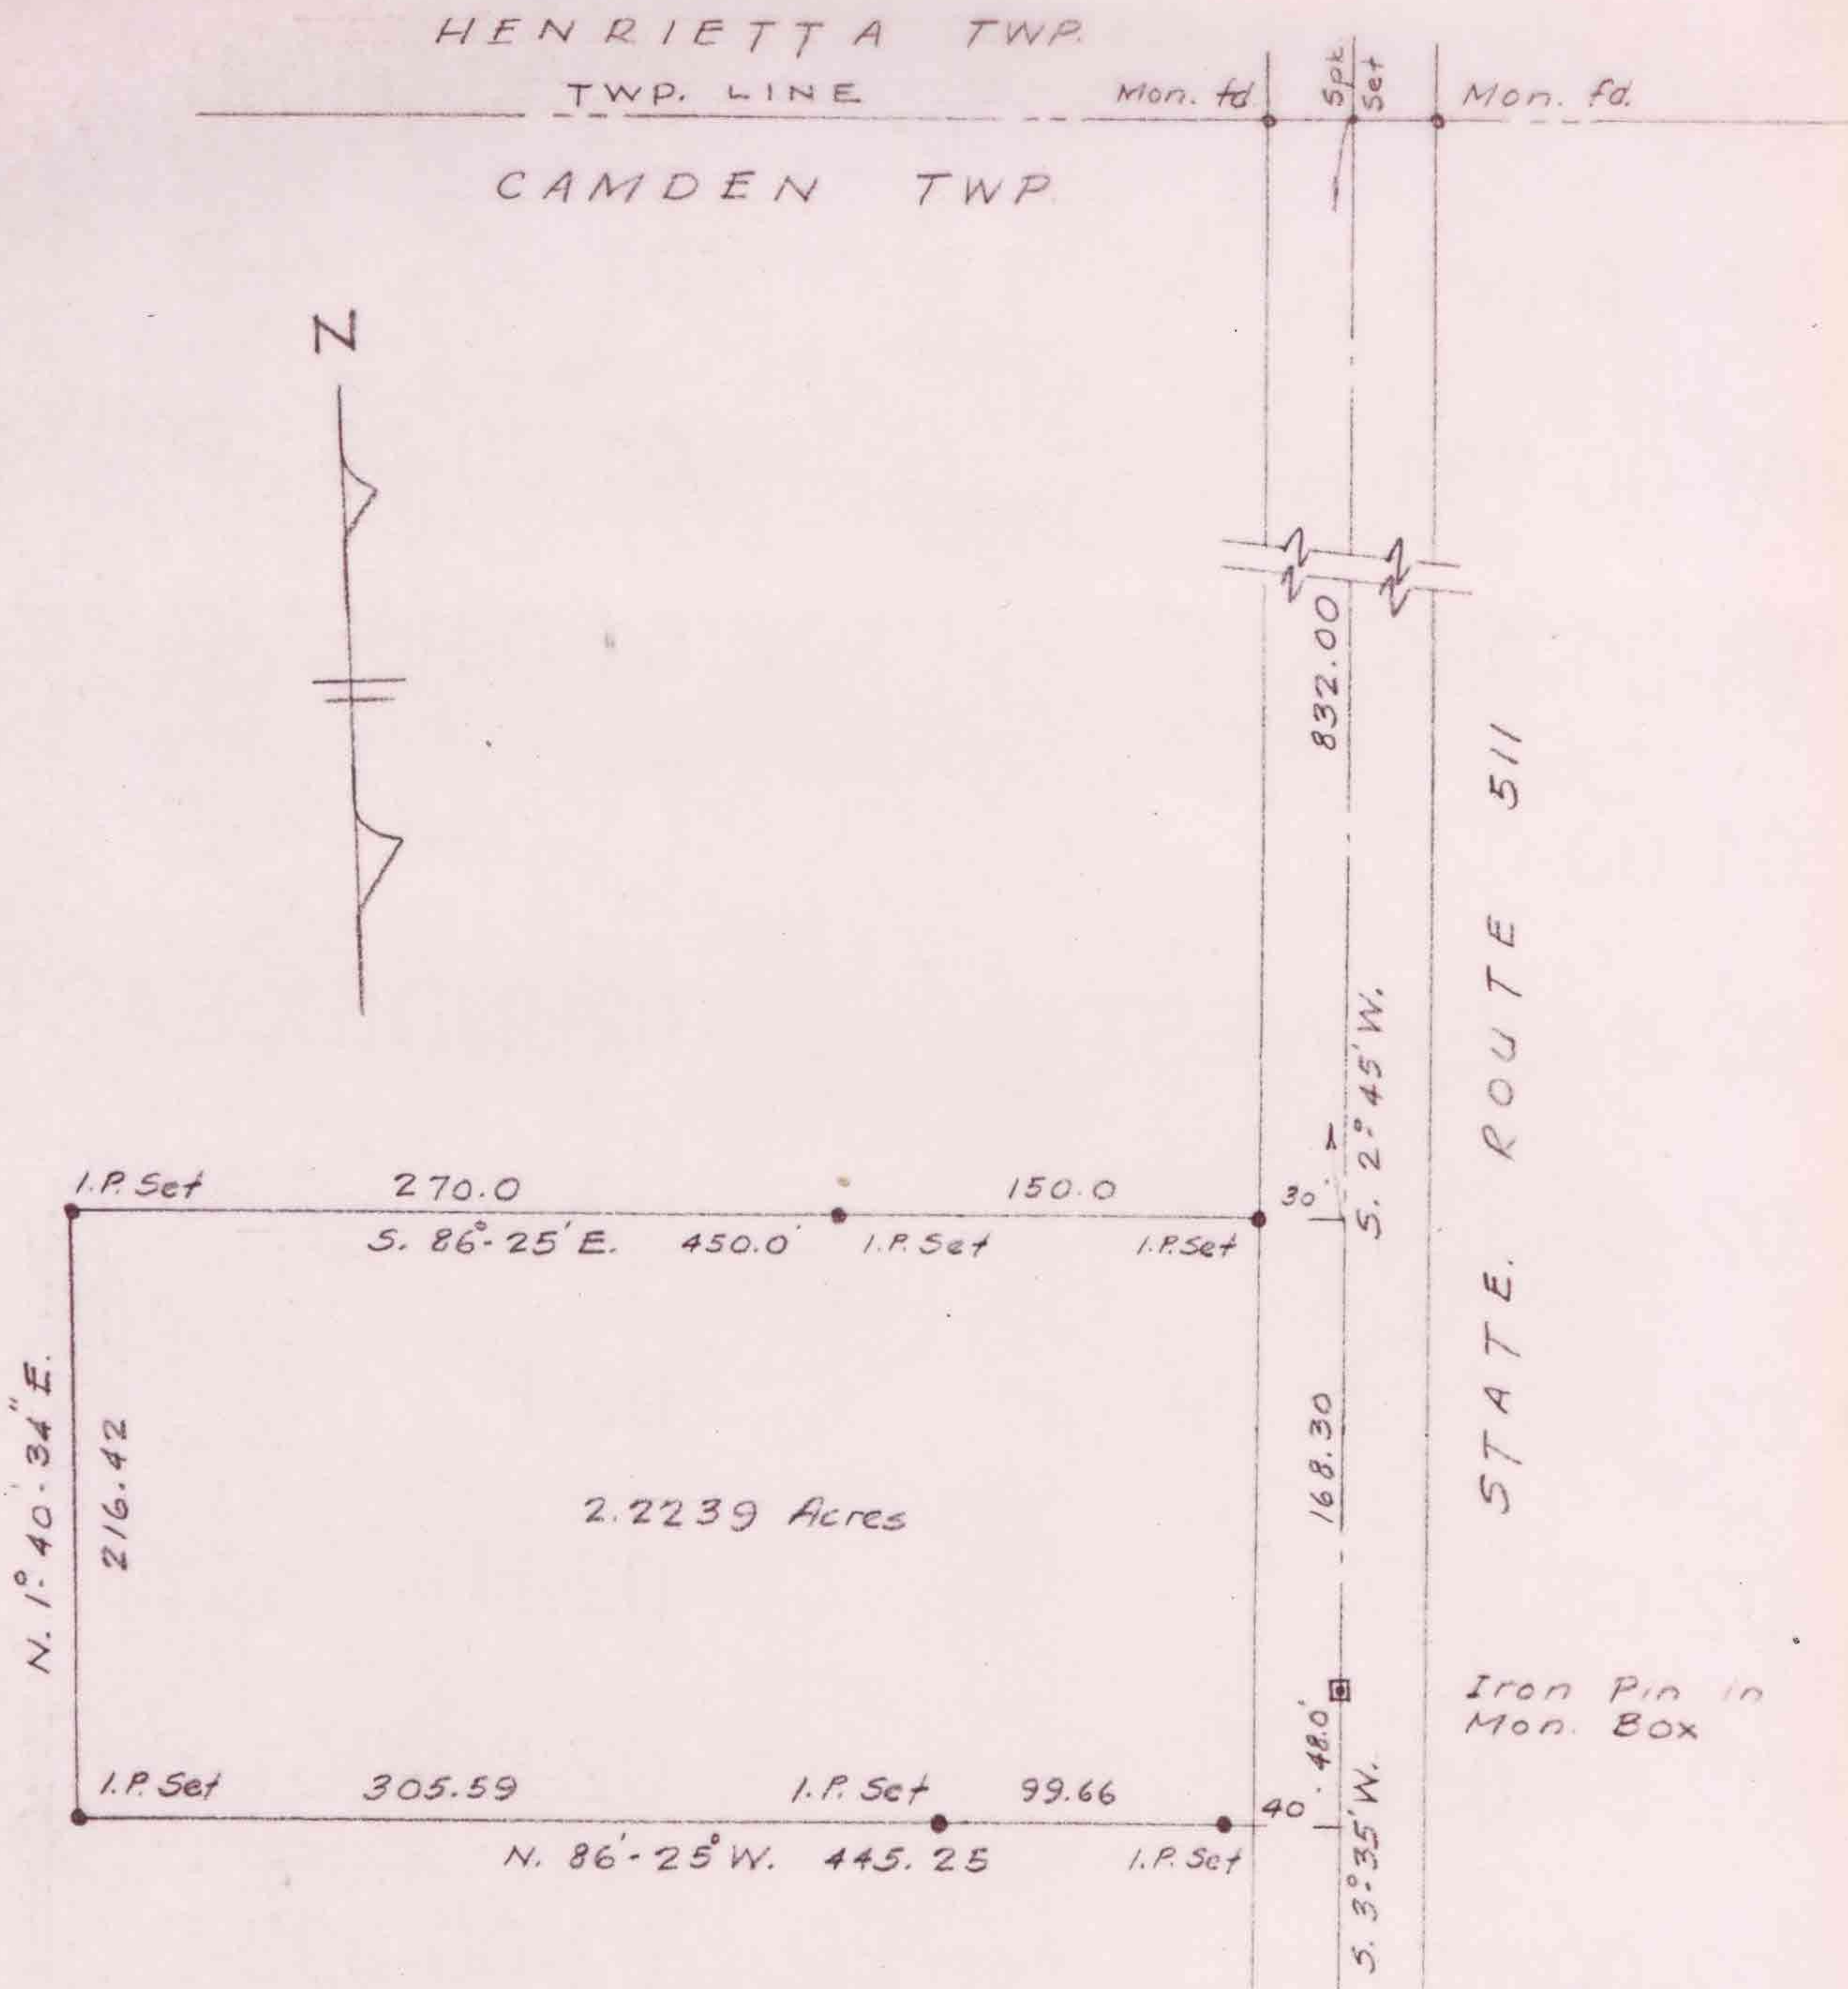

SURVEY FOR EDW. J. & EVA. A. PACHINGER
PT. OF O. L. 5 TR II CAMDEN TWP
LORAIN COUNTY OHIO
SCALE 1" = 100' APRIL 1965
LAUNDON, HUFFMAN & SIMON SURVEYORS