



STATE ROUTE 303

PT 14-00-087-000-014
 SCAN # 46826
 14.F

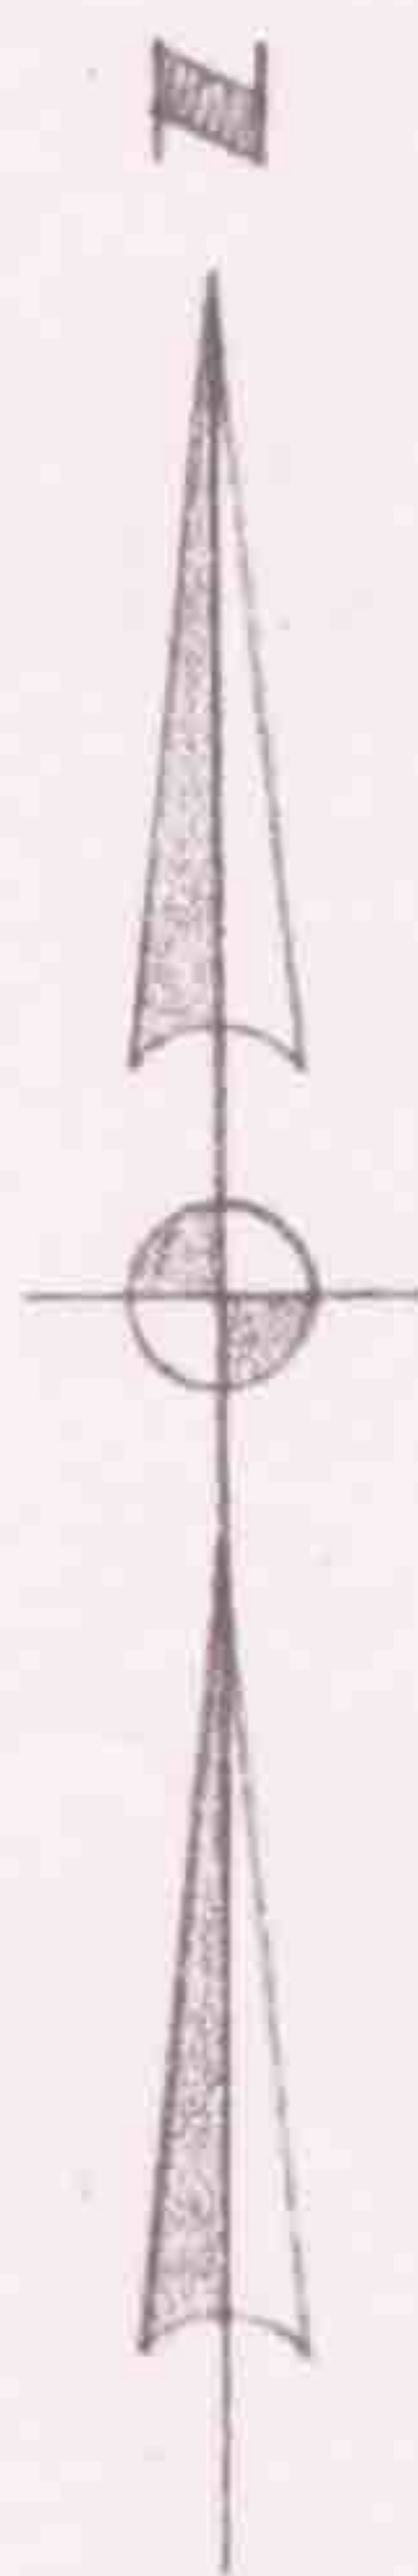

MEARL & KATHRYN KLINE
 11-30-72 D.V. 1065 P. 348

2.3561 Ac.

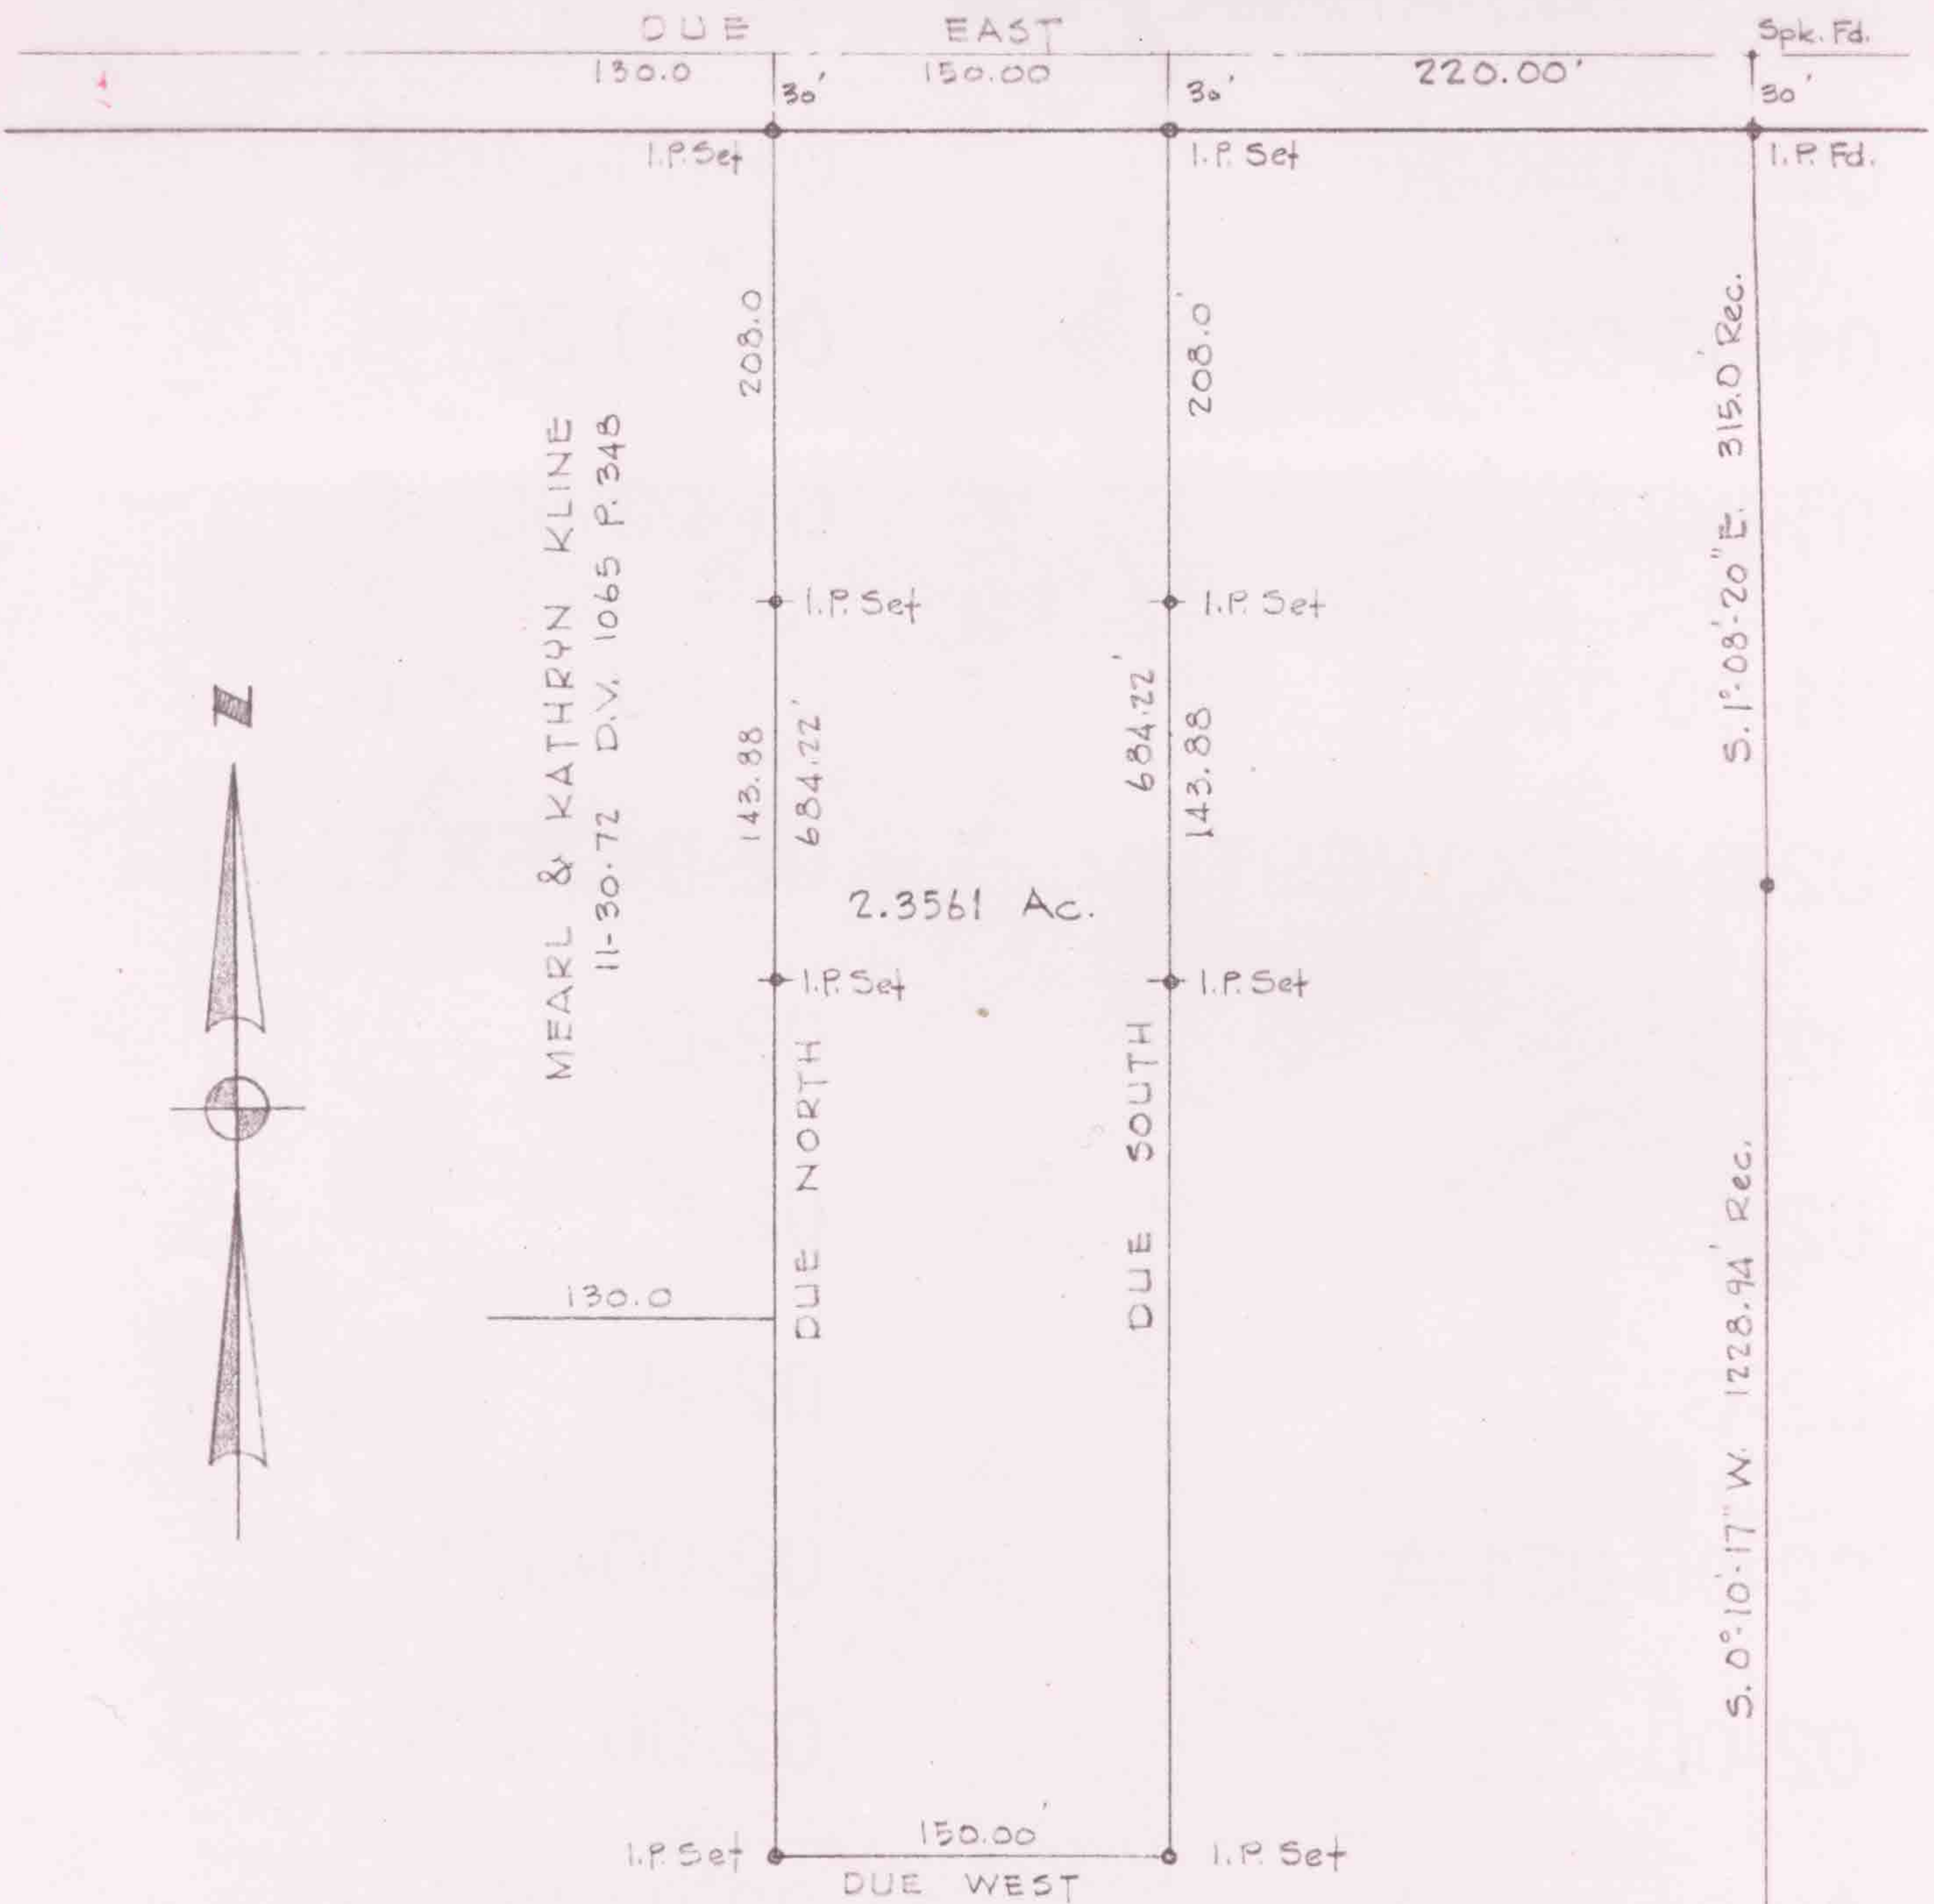

SURVEY FOR

CARL C. & CATHERINE J. DEWEY

O.L. 87 PITTSFIELD TWP LORAIN COUNTY OHIO :
 SCALE 1"=100' JULY 31, 1978
 LAUNDON • SIMON • CAHL & ASSOC. ENGINEERS - SURVEYORS

Job. No. 78-779 F.B. 175/50