


16-00-069-000-007
 16-00-069-000-008
 16-00-069-000-009
 16-H
 SCAN # 44870



O.L. 68 O.L. 69

OSTRO

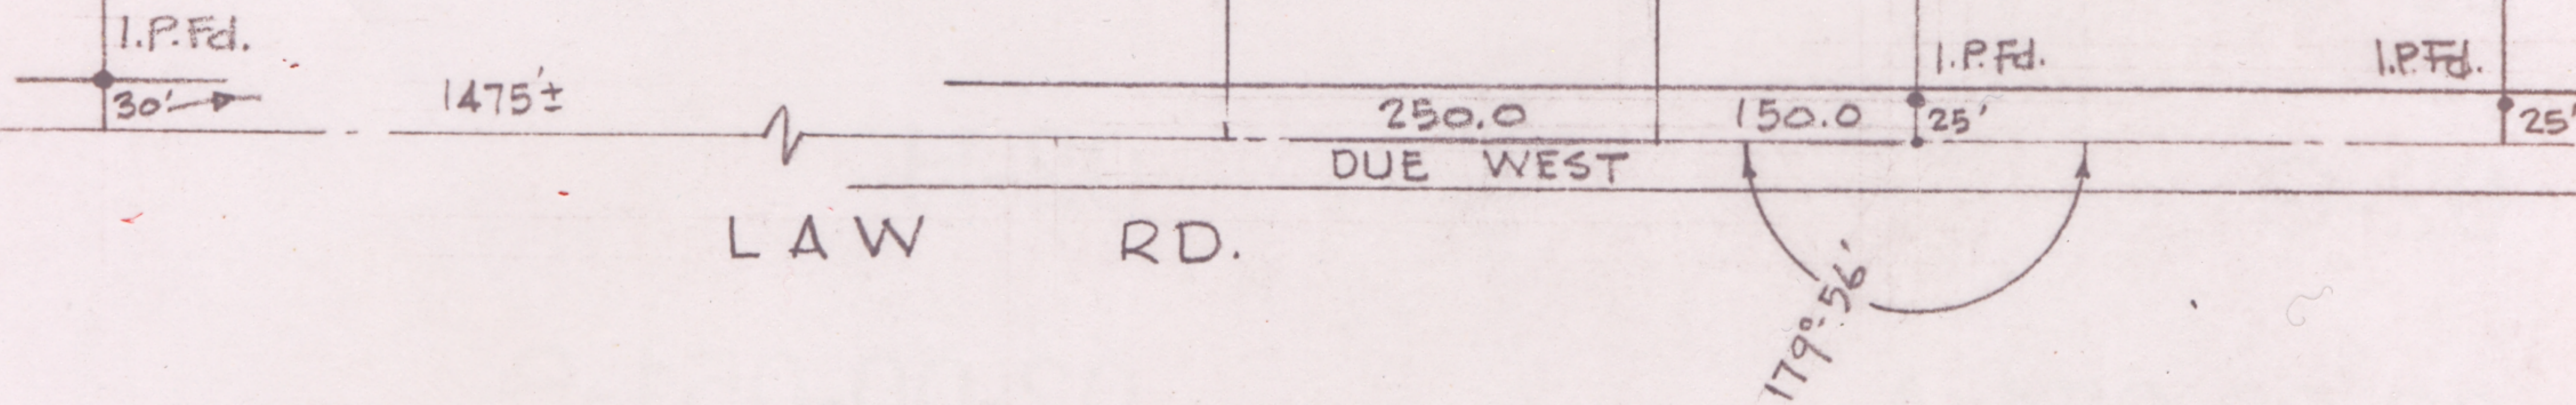

EDNA E. BAUER
 ESTHER E. FLEW.

10-6-60 D.V. 783 P. 158

BEARINGS SHOWN USED TO DESCRIBE ANGLES ONLY.

SURVEY FOR

BILL GARRETT

O.L. 69 GRAFTON TWP.
 LORAIN COUNTY OHIO
 SCALE 1" = 200' DEC. 1, 1977
 LAUNDON • SIMON • CAHL & ASSOC.
 ENGINEERS SURVEYORS
 #77-693 F.B 118 / 72

REVISED 2/13/78

*I.P.'s not reset
 as of 2/13/78*