





ELYRIA - MILAN RD.

PYLE - SOUTH AMHERST ROAD

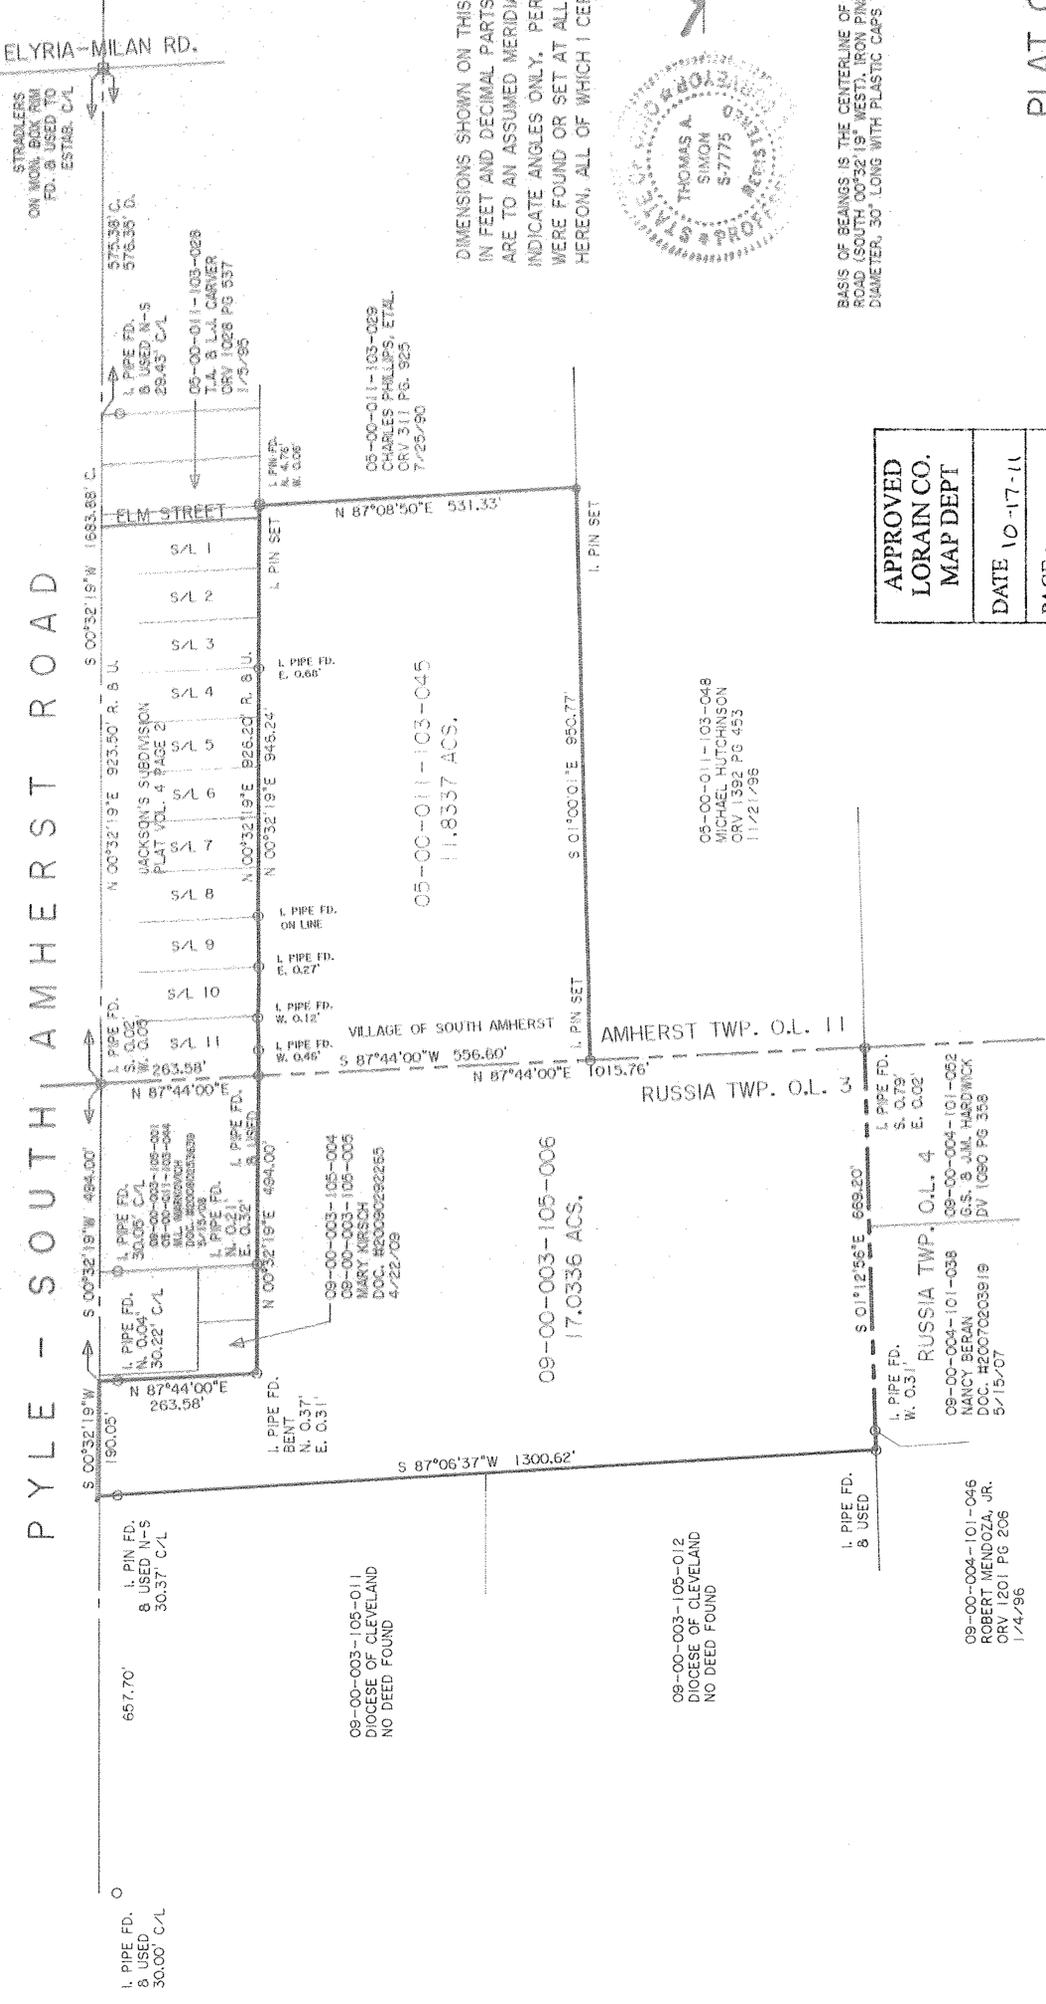

DIMENSIONS SHOWN ON THIS PLAT ARE EXPRESSED IN FEET AND DECIMAL PARTS THEREOF, ALL BEARINGS ARE TO AN ASSUMED MERIDIAN AND ARE USED TO INDICATE ANGLES ONLY. PERMANENT MONUMENTS WERE FOUND OR SET AT ALL POINTS INDICATED HEREON, ALL OF WHICH I CERTIFY TO BE CORRECT.

THAS
 THOMAS A. SIMON
 REG. PROFESSIONAL SURVEYOR
 NO. S-7775

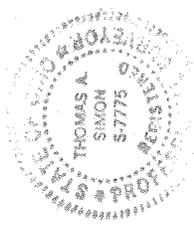

BASIS OF BEARINGS IS THE CENTERLINE OF PYLE-SOUTH AMHERST ROAD (SOUTH 00°32'19" WEST), IRON PINS SET ARE 5/8" DIAMETER, 30" LONG WITH PLASTIC CAPS "T. SIMON, S-7775".

APPROVED LORAIN CO. MAP DEPT
DATE 10-17-11
PAGE 9-00-003-8
BY R. MAINES
11-02-0308-A

PLAT OF SURVEY
 FOR
 HARVEY WENTLING

09-00-003-105-006
 05-00-011-103-045

BEING KNOWN AS PART OF ORIGINAL AMHERST TOWNSHIP LOT NO. 11, IN THE VILLAGE OF SOUTH AMHERST AND PART OF ORIGINAL RUSSIA TOWNSHIP LOT NO. 3

COUNTY OF LORAIN STATE OF OHIO
 OCTOBER, 2011 SCALE: 1" = 200'

THOMAS SIMON & ASSOCIATES, INC.
 PROFESSIONAL LAND SURVEYORS
 150 SOUTH OLIVE STREET
 ELYRIA, OHIO 44035
 (440) 327-2925
 FAX 327-2964

SCAN # 40997
 09-00-003-8

09-00-003-105-006
 05-00-011-103-045