

# MAP OF SURVEY

# MACKAY

PREPARED FOR: MILLER HOME TITLE  
 PERM. PCL. NO. 06-25-002-101-055  
 STREET ADDRESS 523 STANFORD AVENUE  
 PART OF ORIGINAL ELYRIA TOWNSHIP LOT NO.

Engineering & Surveying Company  
 7017 Pearl Road, Cleveland, Ohio 44130  
 (440) 886-4500 (440) 886-4590 Fax




2, EAST OF BLACK RIVER  
 CITY OF ELYRIA COUNTY OF LORAIN STATE OF OHIO  
 DATE APRIL 5, 2012 SCALE 1"=40'  
 JOB # 5367

DISTANCES ARE EXPRESSED IN FEET AND DECIMAL PARTS THEREOF. MONUMENTS WERE FOUND OR SET AS INDICATED. ALL OF WHICH I CERTIFY TO BE CORRECT.



LINE	BEARING	DISTANCE
L1	N 89°23'20" E	12.00' C&U
L2	S 00°36'40" E	51.39' C&U

*Michael Mackay* 4/9/12  
 REGISTERED OHIO SURVEYOR NO. 4195

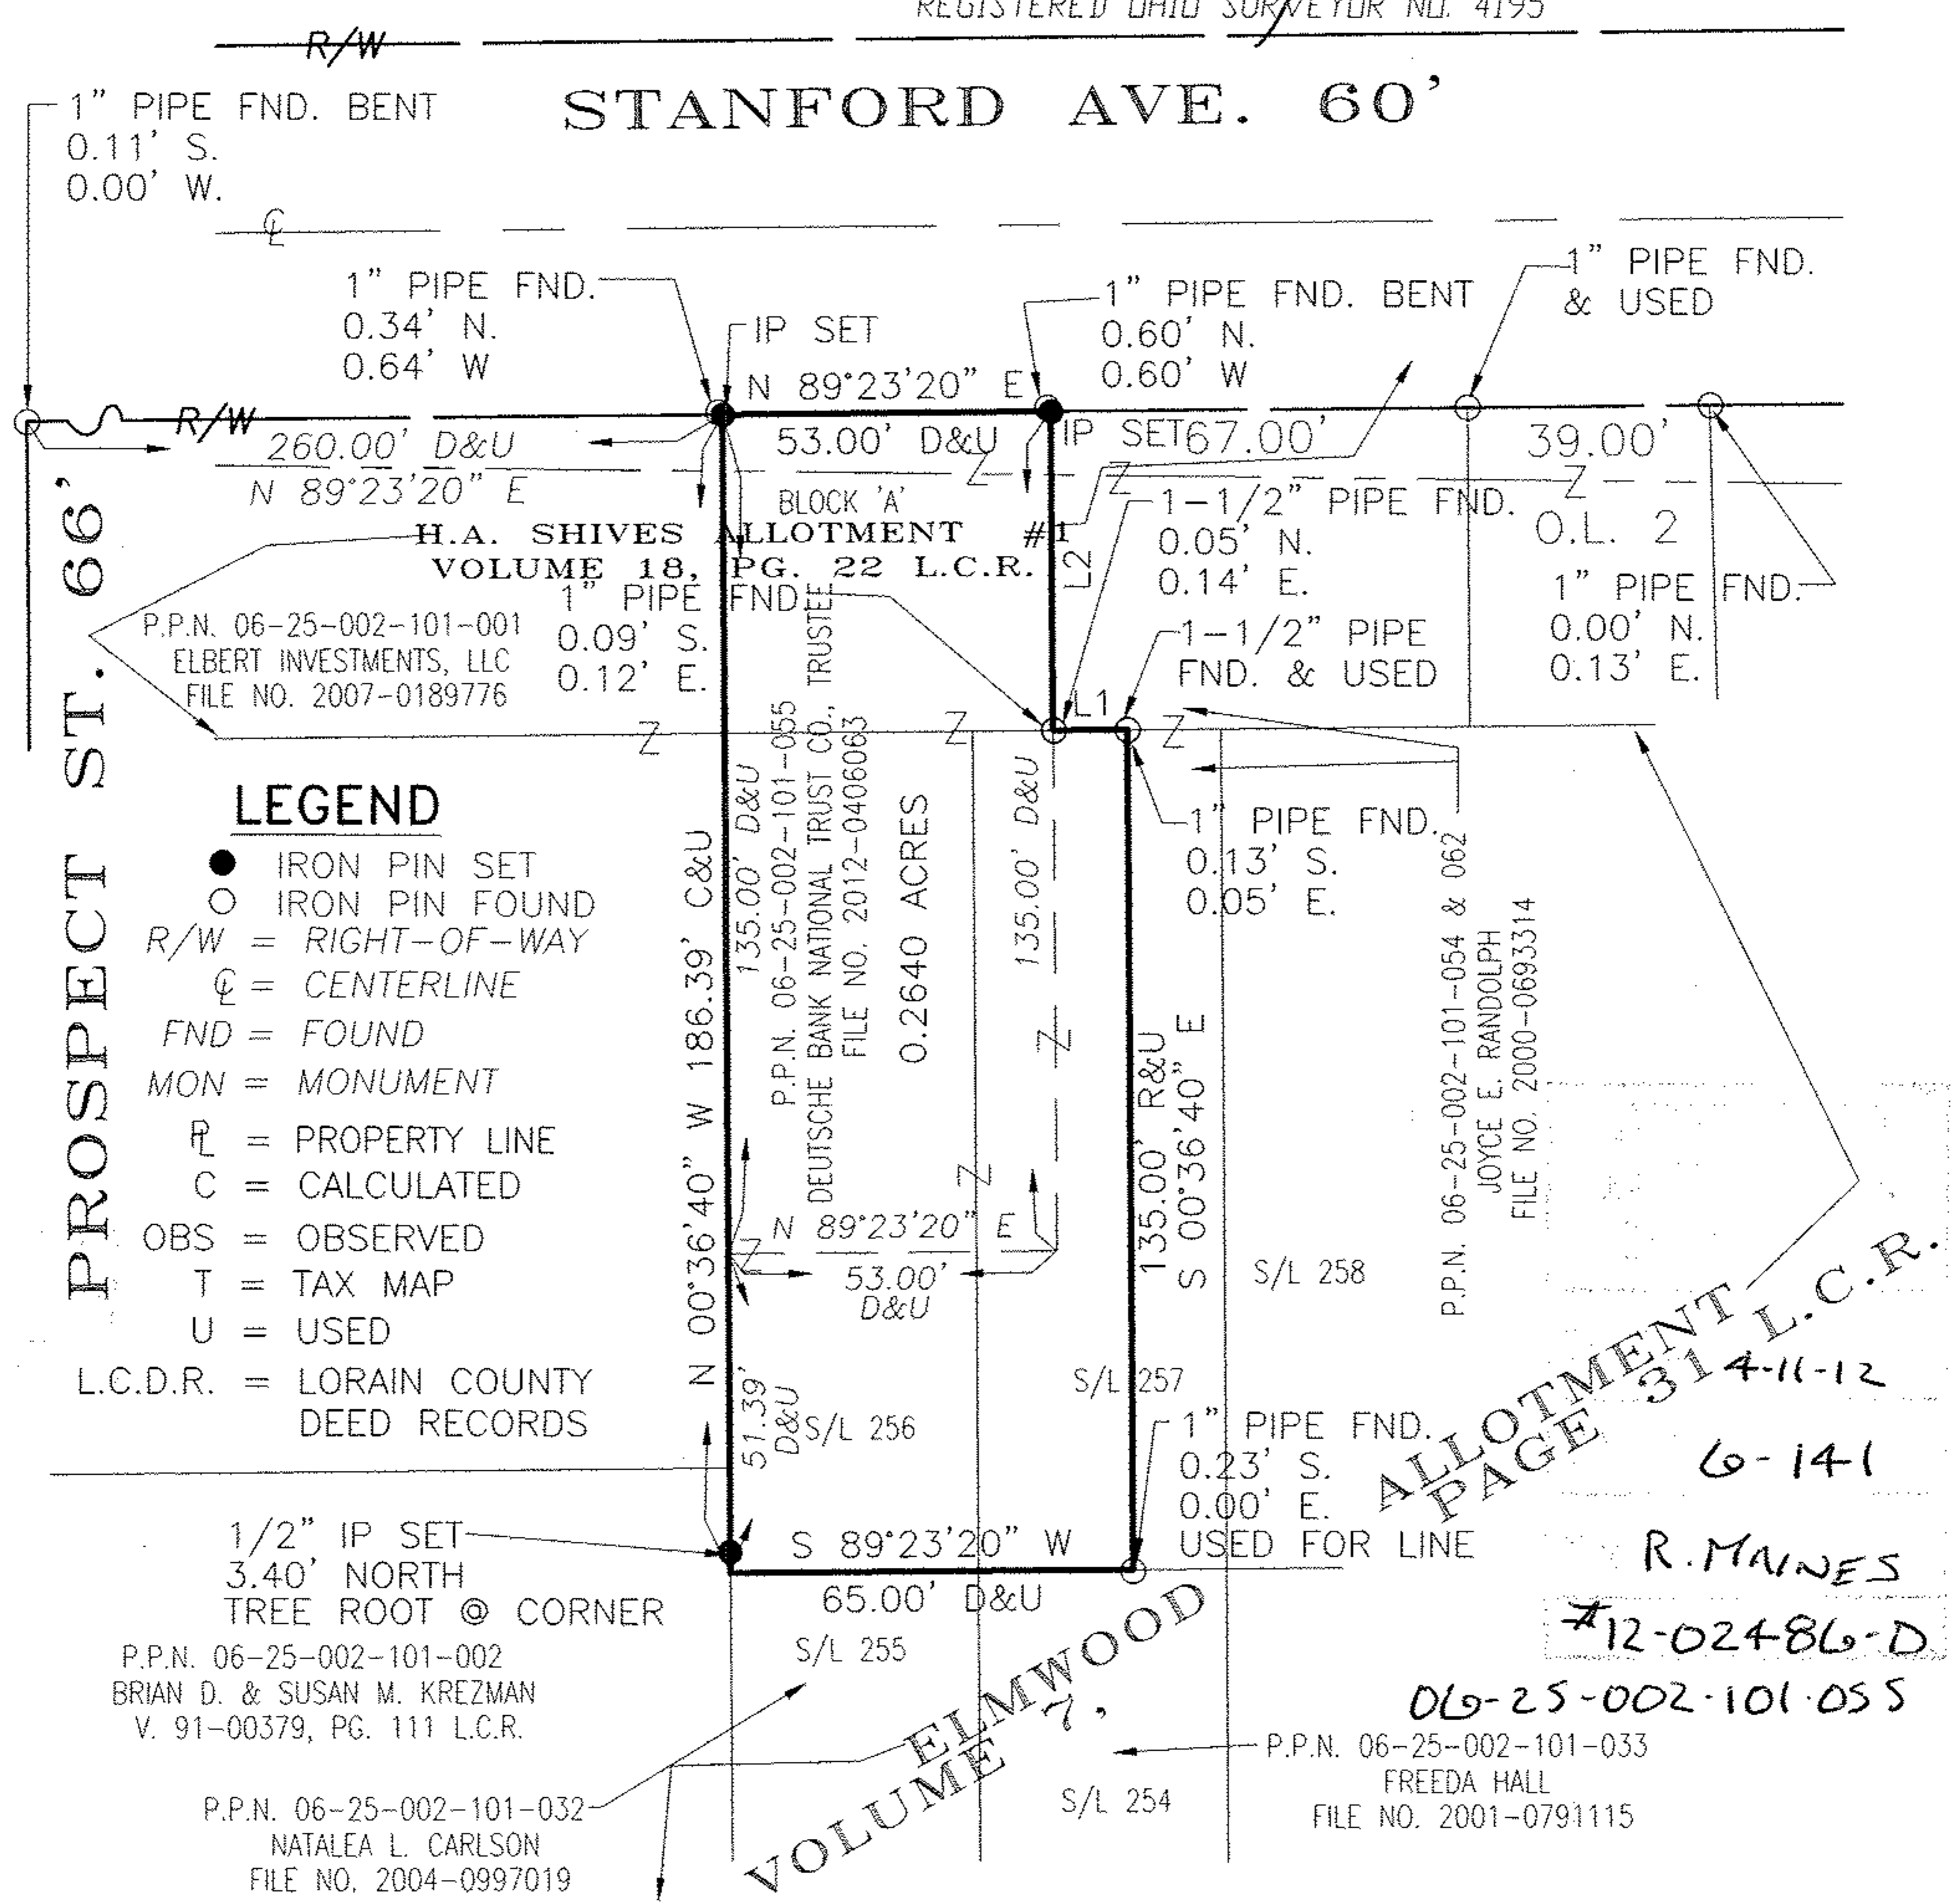

- LEGEND**
- IRON PIN SET
  - IRON PIN FOUND
  - R/W = RIGHT-OF-WAY
  - ⊕ = CENTERLINE
  - FND = FOUND
  - MON = MONUMENT
  - ℙ = PROPERTY LINE
  - C = CALCULATED
  - OBS = OBSERVED
  - T = TAX MAP
  - U = USED
  - L.C.D.R. = LORAIN COUNTY DEED RECORDS

ALLOTMENT # 314-11-12  
 PAGE 6-141  
 R. MAINES  
 #12-02486-D

06-25-002-101-055

P.P.N. 06-25-002-101-033  
 FREEDA HALL  
 FILE NO. 2001-0791115

P.P.N. 06-25-002-101-002  
 BRIAN D. & SUSAN M. KREZMAN  
 V. 91-00379, PG. 111 L.C.R.

P.P.N. 06-25-002-101-032  
 NATALEA L. CARLSON  
 FILE NO. 2004-0997019

ELMWOOD  
 VOLUME 2