


Dane A. HAPONEK

5444 Stoney Ridge Road North Ridgeville, Ohio 44039 (440) 327-4776
Reg. Surveyor S6211

SURVEY
OF PART OF
ORIGINAL LOT N^o 3 TRACT N^o 1
IN
BLACK RIVER TOWNSHIP
CITY OF LORAIN

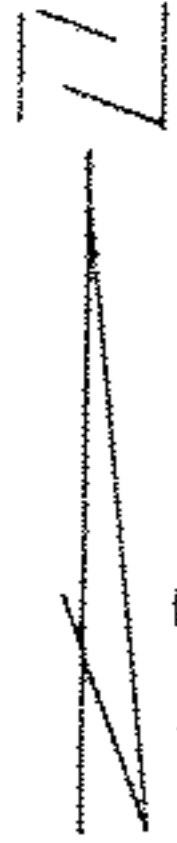


DATE: SEPT 2008
SCALE: 1" = 40'

S-11-12
2-01-003-B
R. MAINES
#12-02506-D



02-01-003-110-
-003

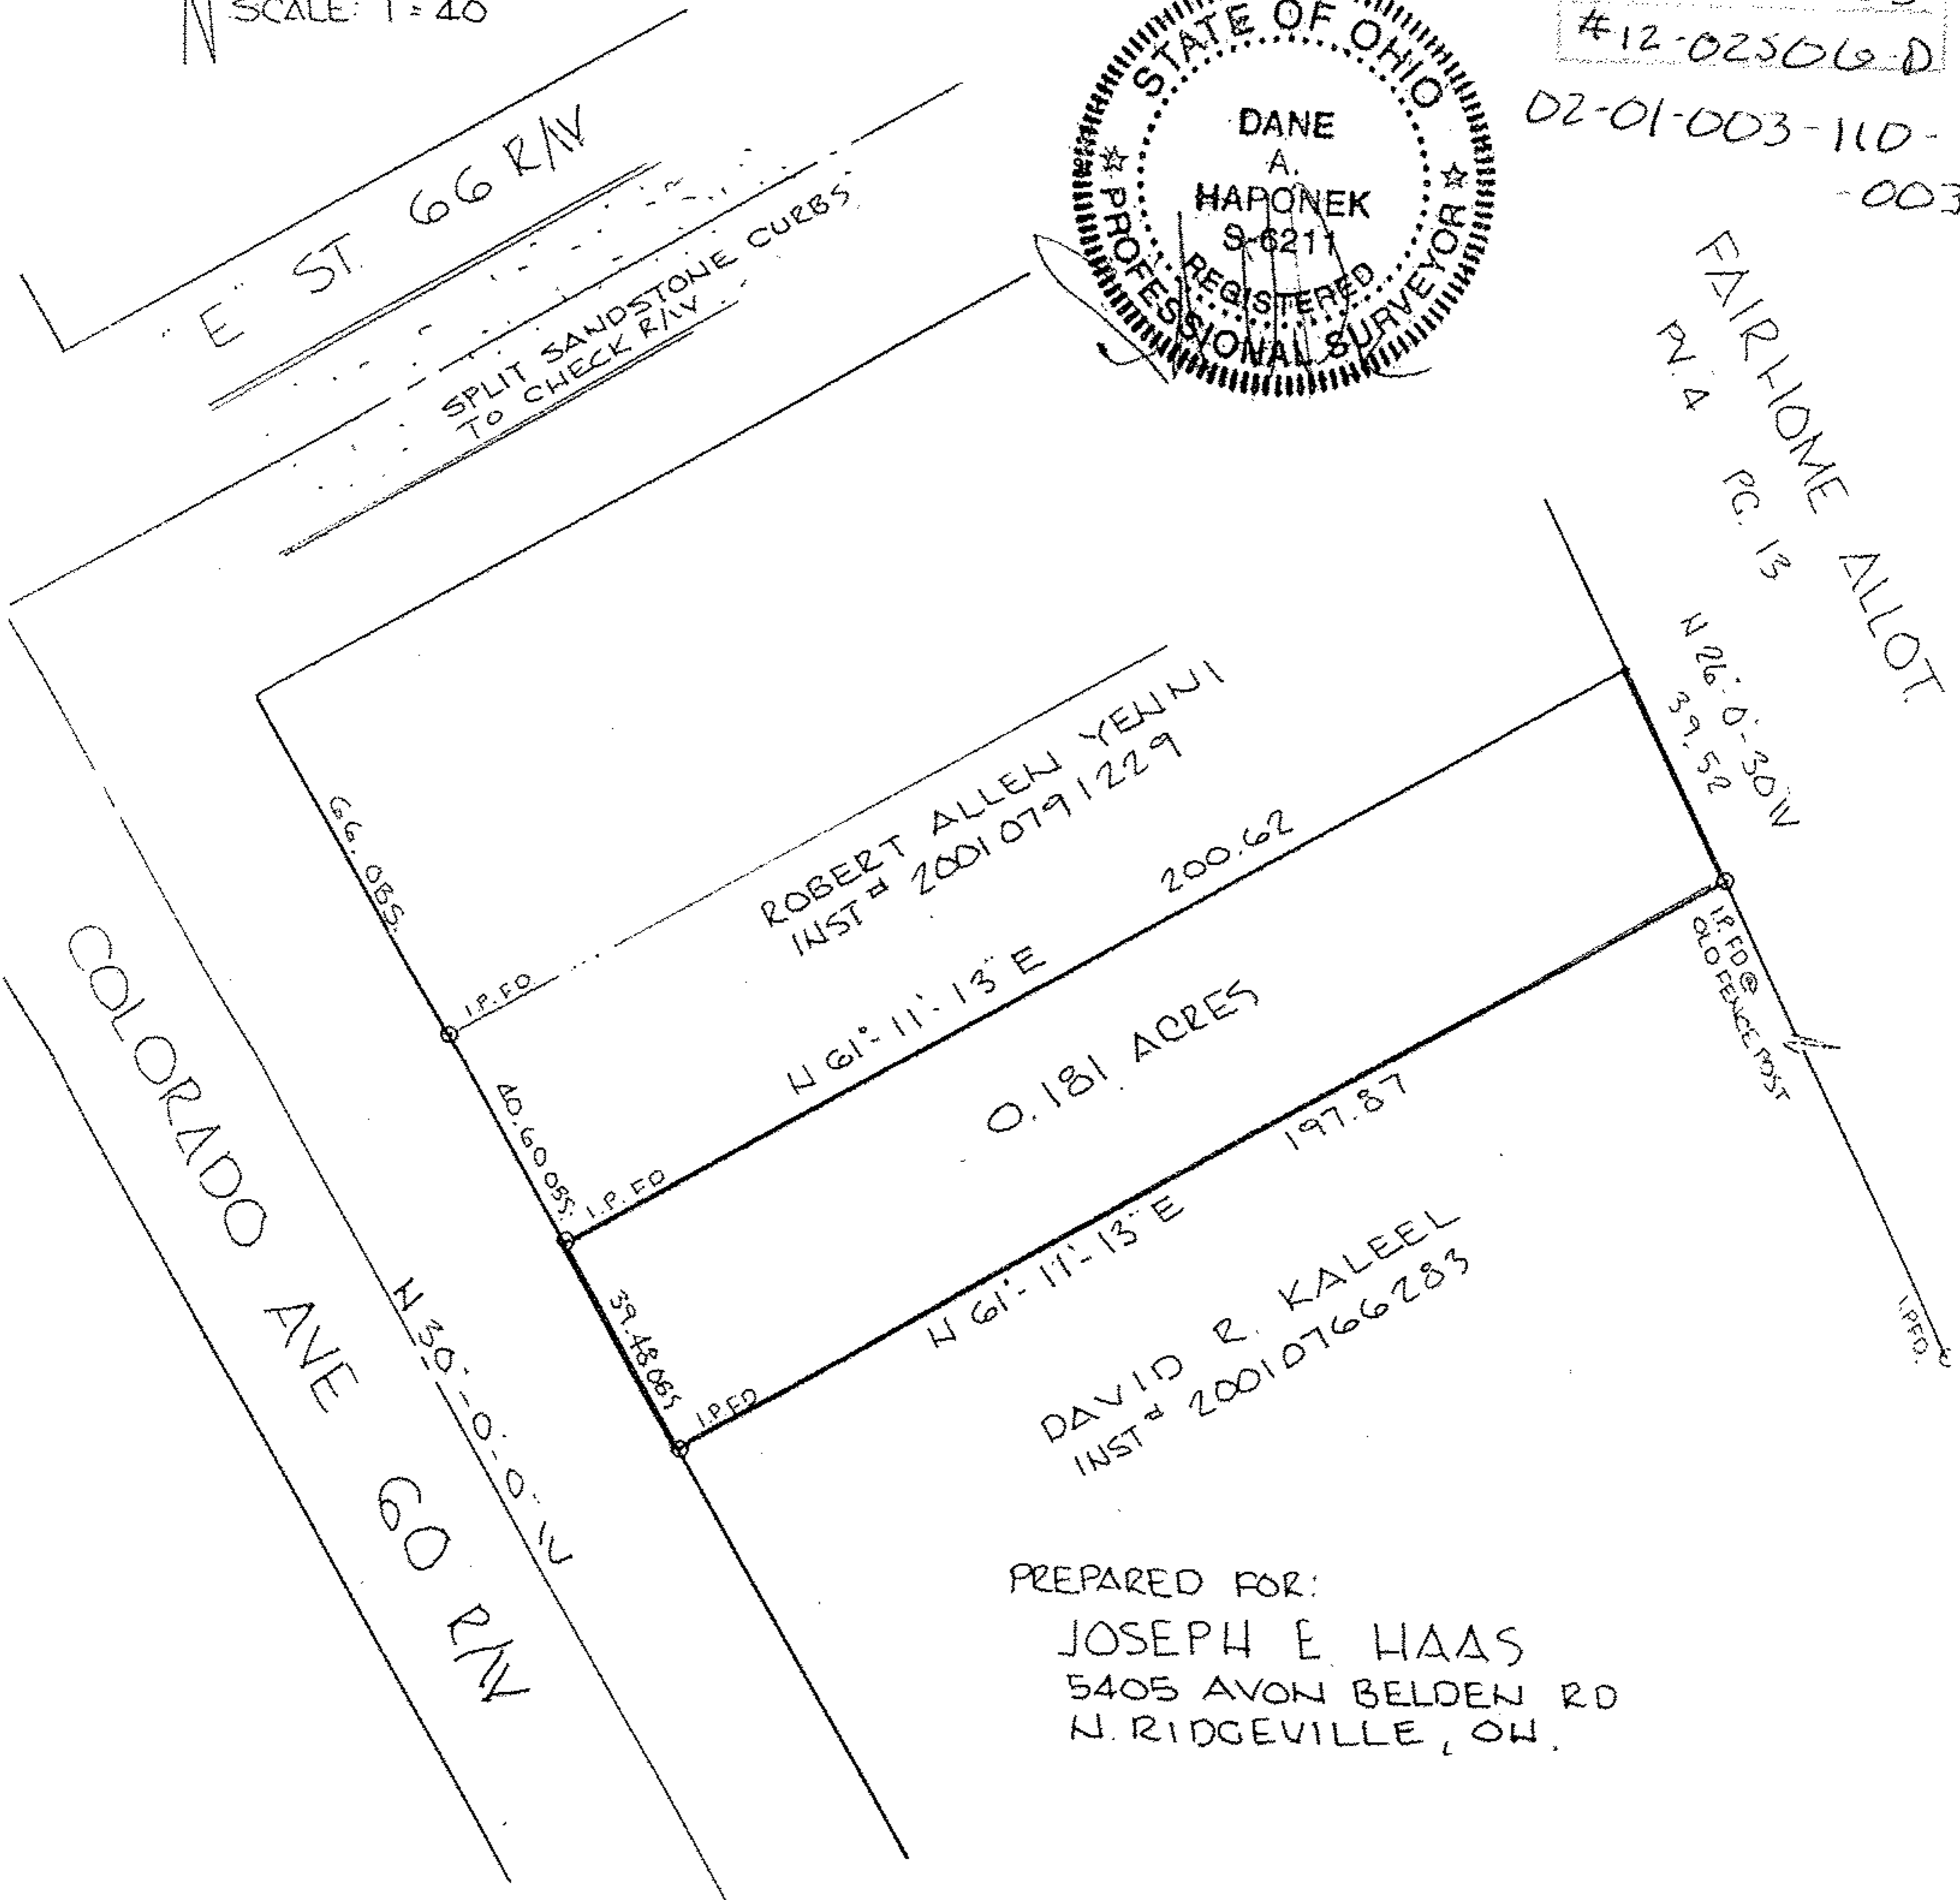

FAIRHOME ALLOT.
P. 4 PG. 13
N 26° 0' 30" W
39.52

PREPARED FOR:
JOSEPH E. HAAS
5405 AVON BELDEN RD
N. RIDGEVILLE, OH.