

LOT SPLIT SURVEY for ESTATE OF SHIRLEY A. WOLFF PART OF COLUMBIA TOWNSHIP LOTS 39 AND 40 IN LORAIN COUNTY, OHIO.



JUNE 2012 12027 F.B. 53, PG. 23

REFERENCES: LORAIN COUNTY HIGHWAY ENGINEERS ROAD RECORD PLAN "COLUMBIA-WEST RIVER ROAD PART SEC. B. AND SEC. C & D. DATE JULY 1927. LORAIN COUNTY RECORDERS DEED VOL. 335, PG. 92-93, O.R. VOL. 249-794, INSTR.#2007-0184182.

BASIS OF BEARINGS: N 70° 00' 00" W ALONG THE NORTHERLY LINE OF THE 6.384 AC. "FORSMARK" PARCEL DESCRIBED IN D.V. 1384, PG. 1.

LEGEND

- MONUMENT FOUND AS NOTED.
- 5/8" BAR WITH CAP NO. 7265 SET.

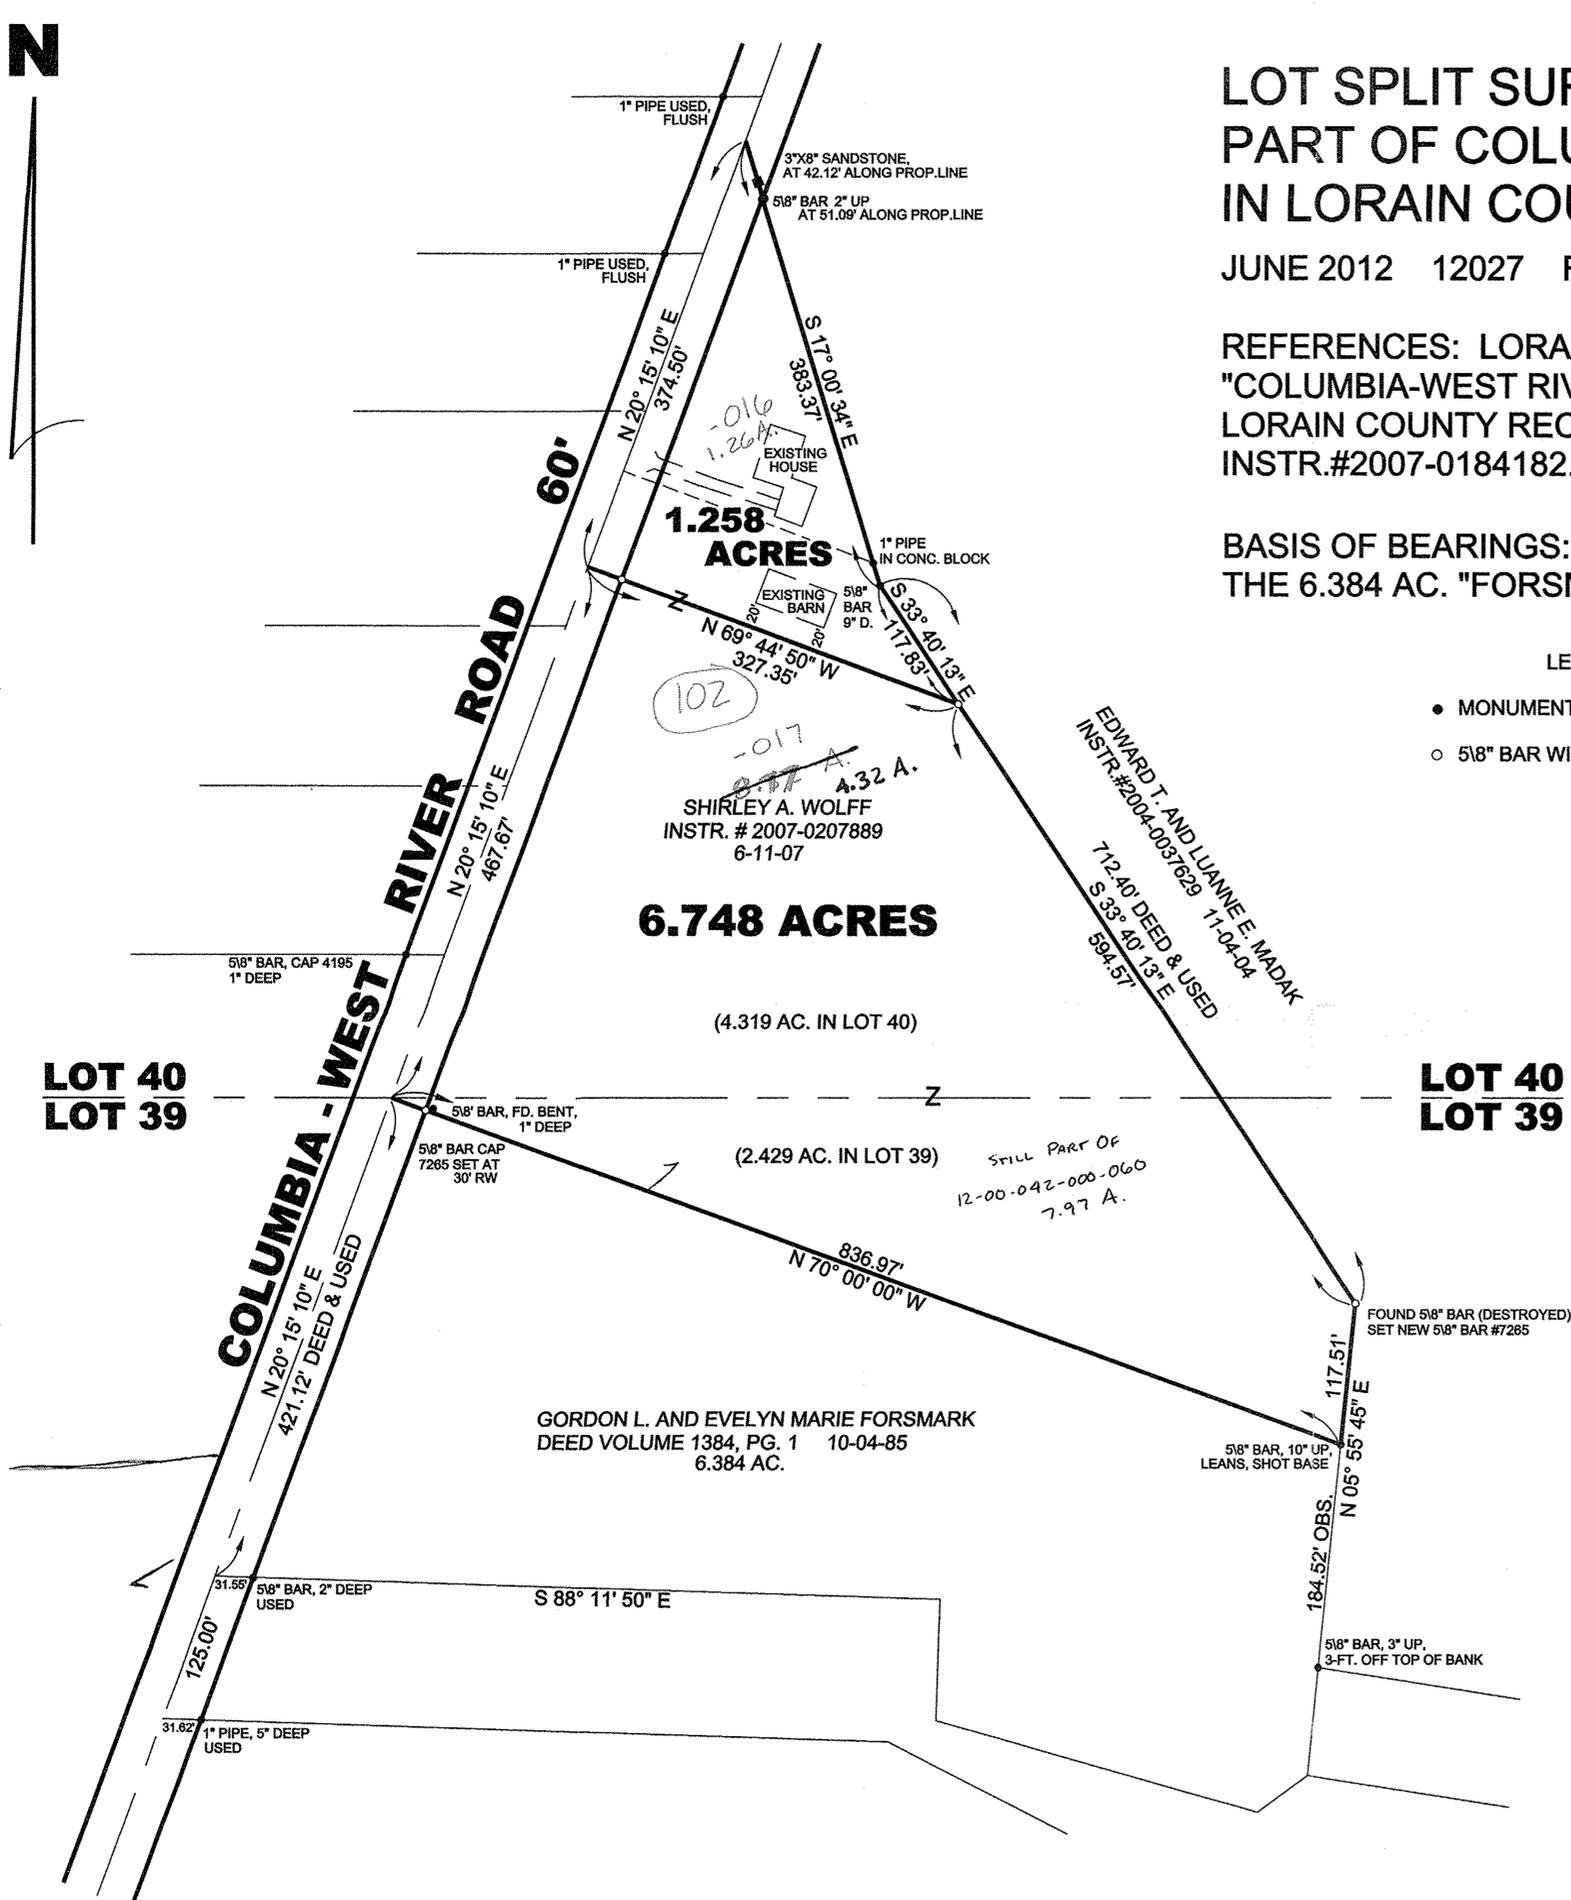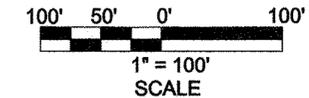

603046
APPROVED
LORAIN CO.
MAP DEPT.
DATE 7/25/12
CASE 12-00-040-A
T. Spillner
#12-03046



Susan L. Eichhorn
SUSAN L. EICHHORN P.S. 7265

Scan # 47181

PH. 330-723-2612
FAX 330-722-5327

4123 WEYMOUTH RD.
MEDINA, OHIO 44256

Corner Stone Professional Land Surveyors, Inc.