

5956


SCHAFFER, HORN & ASSOCIATES, INC.

ENGINEERS AND SURVEYORS

4570 OBERLIN AVE.
LORAIN, OHIO

- Iron Pin found
- Iron Pin Set

03-00-075-114-005
 03-00-075-C
 Scan# 47189

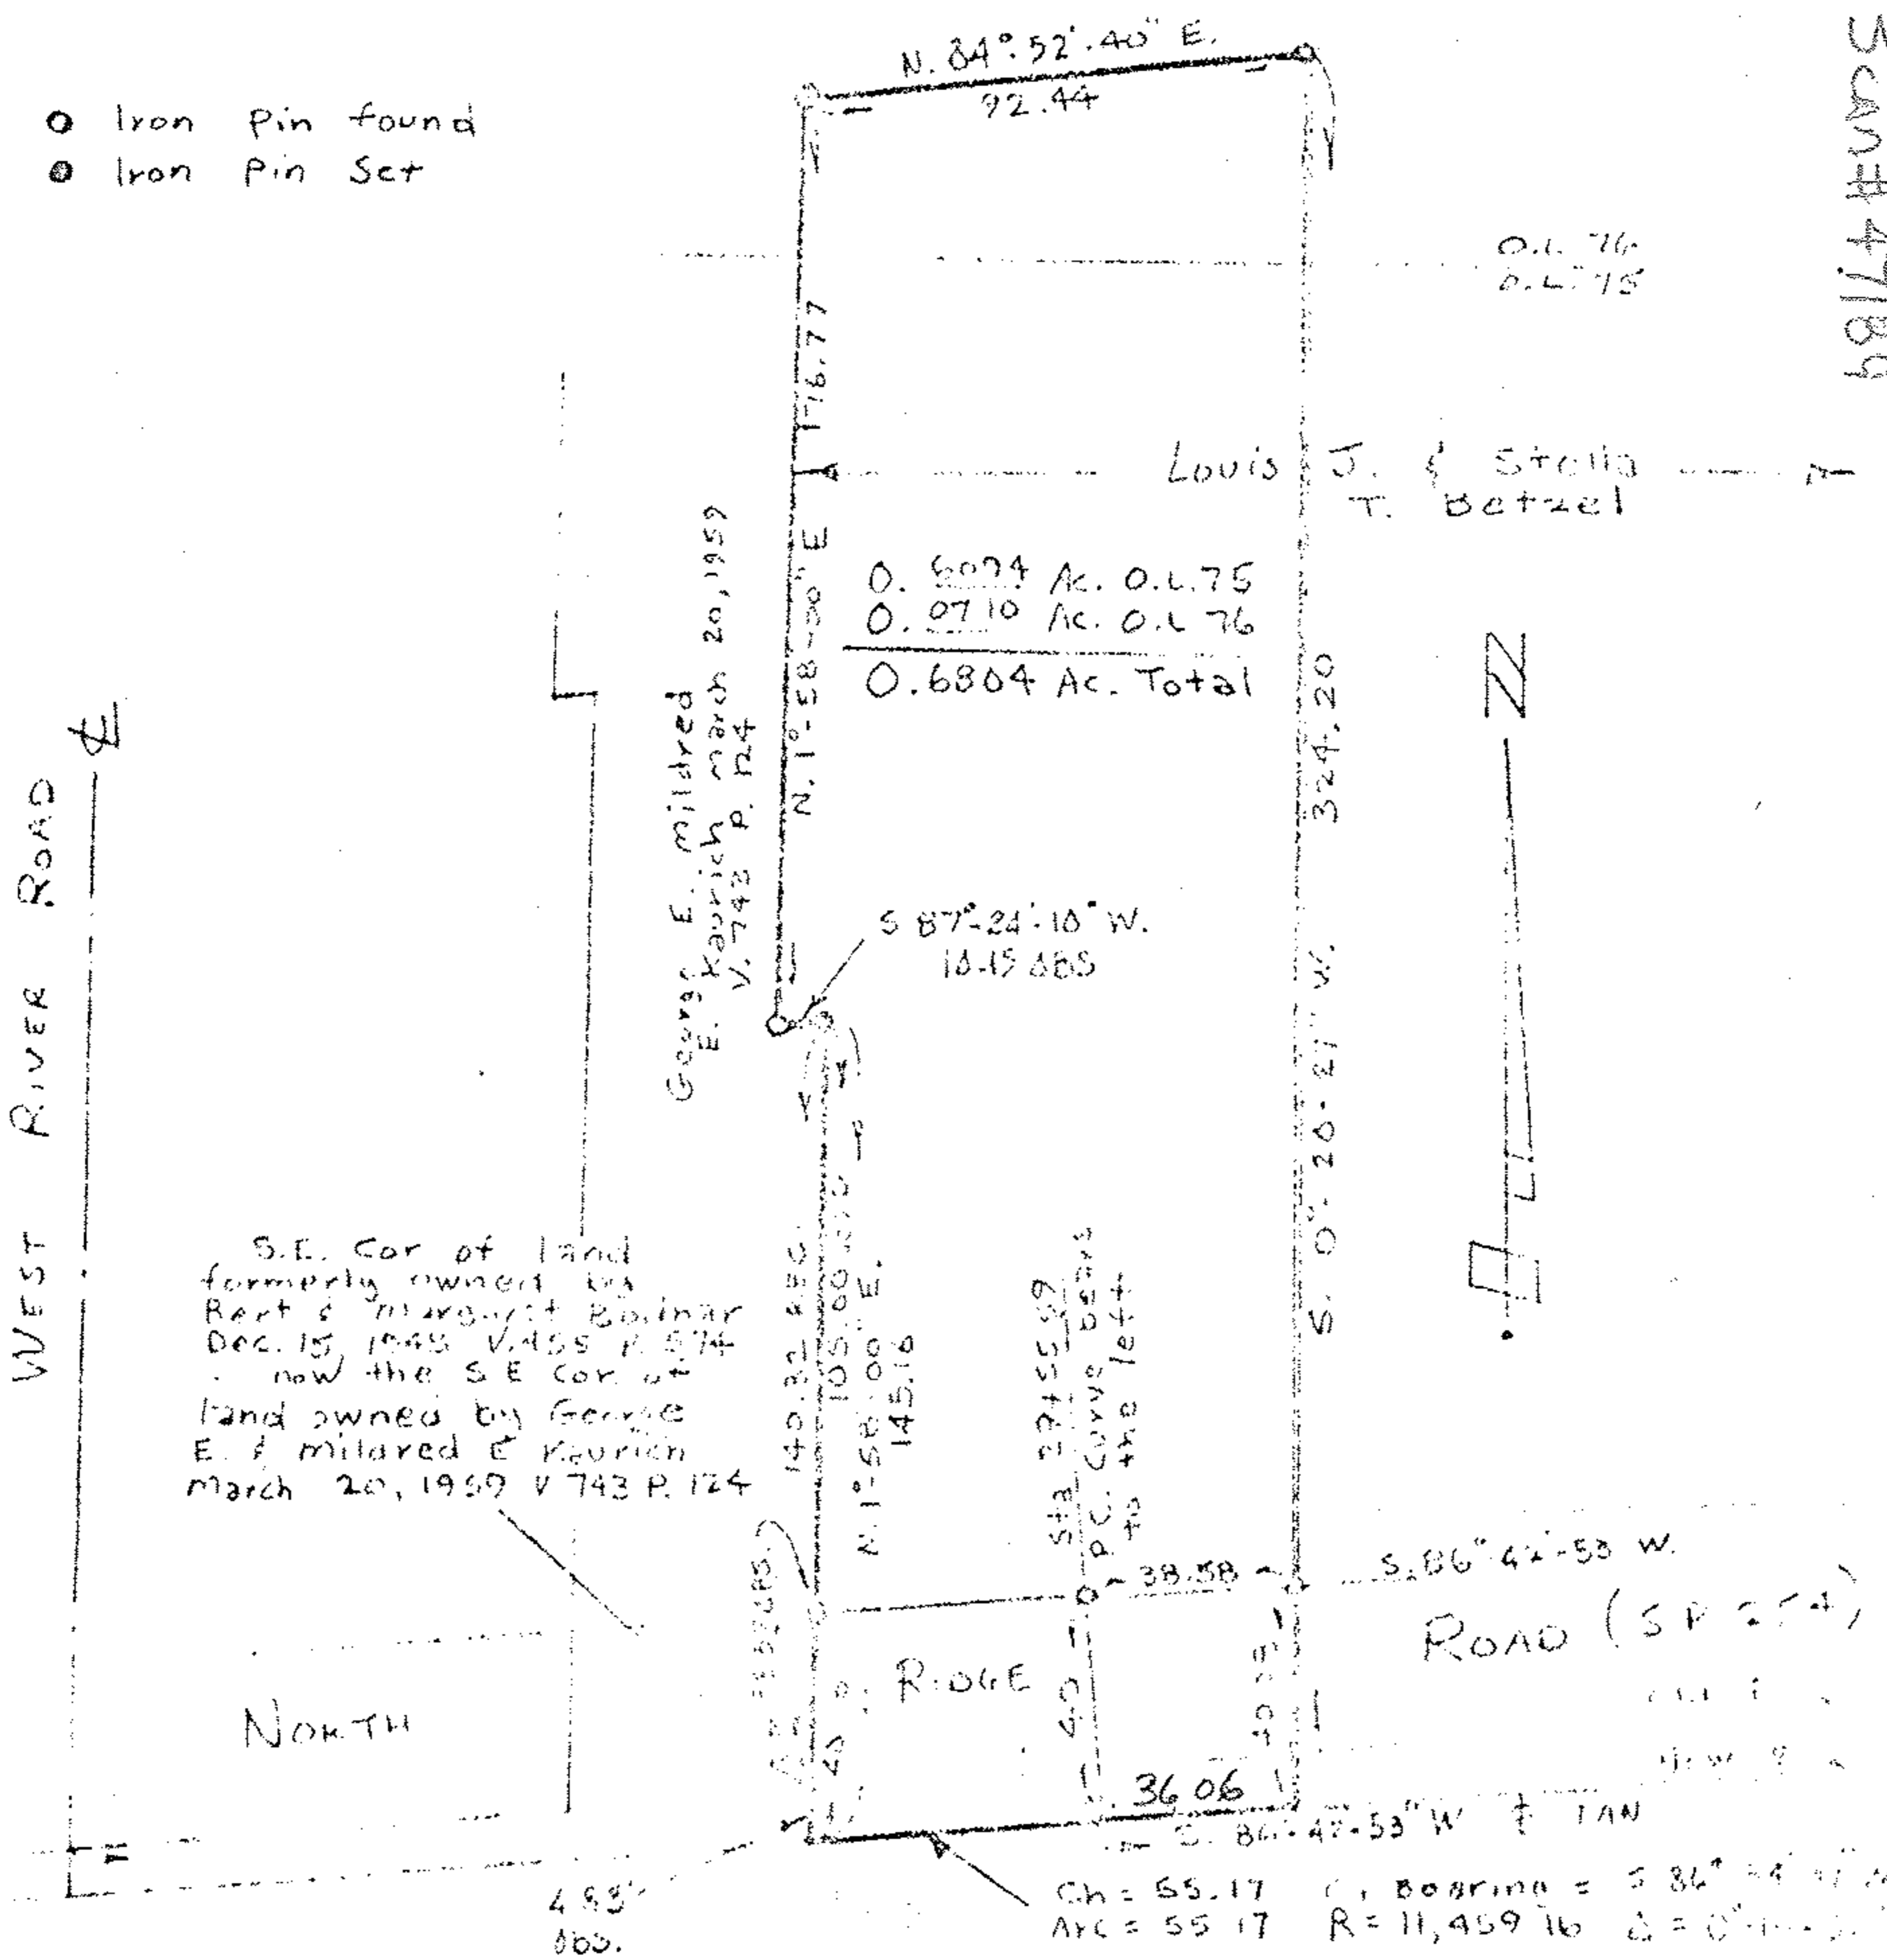

ORIGINAL LOT _____ DATE _____
 TOWNSHIP _____ SCALE _____
 CITY OF _____ FIELD BOOK _____
 COUNTY OF _____ DRAWN BY _____
 STATE OF _____ CHECKED BY _____
 W. O. _____ FILE NO. _____