


06-24-167-000
 V-83
 SCAN# 47197

→ NORTH
 1" = 100'

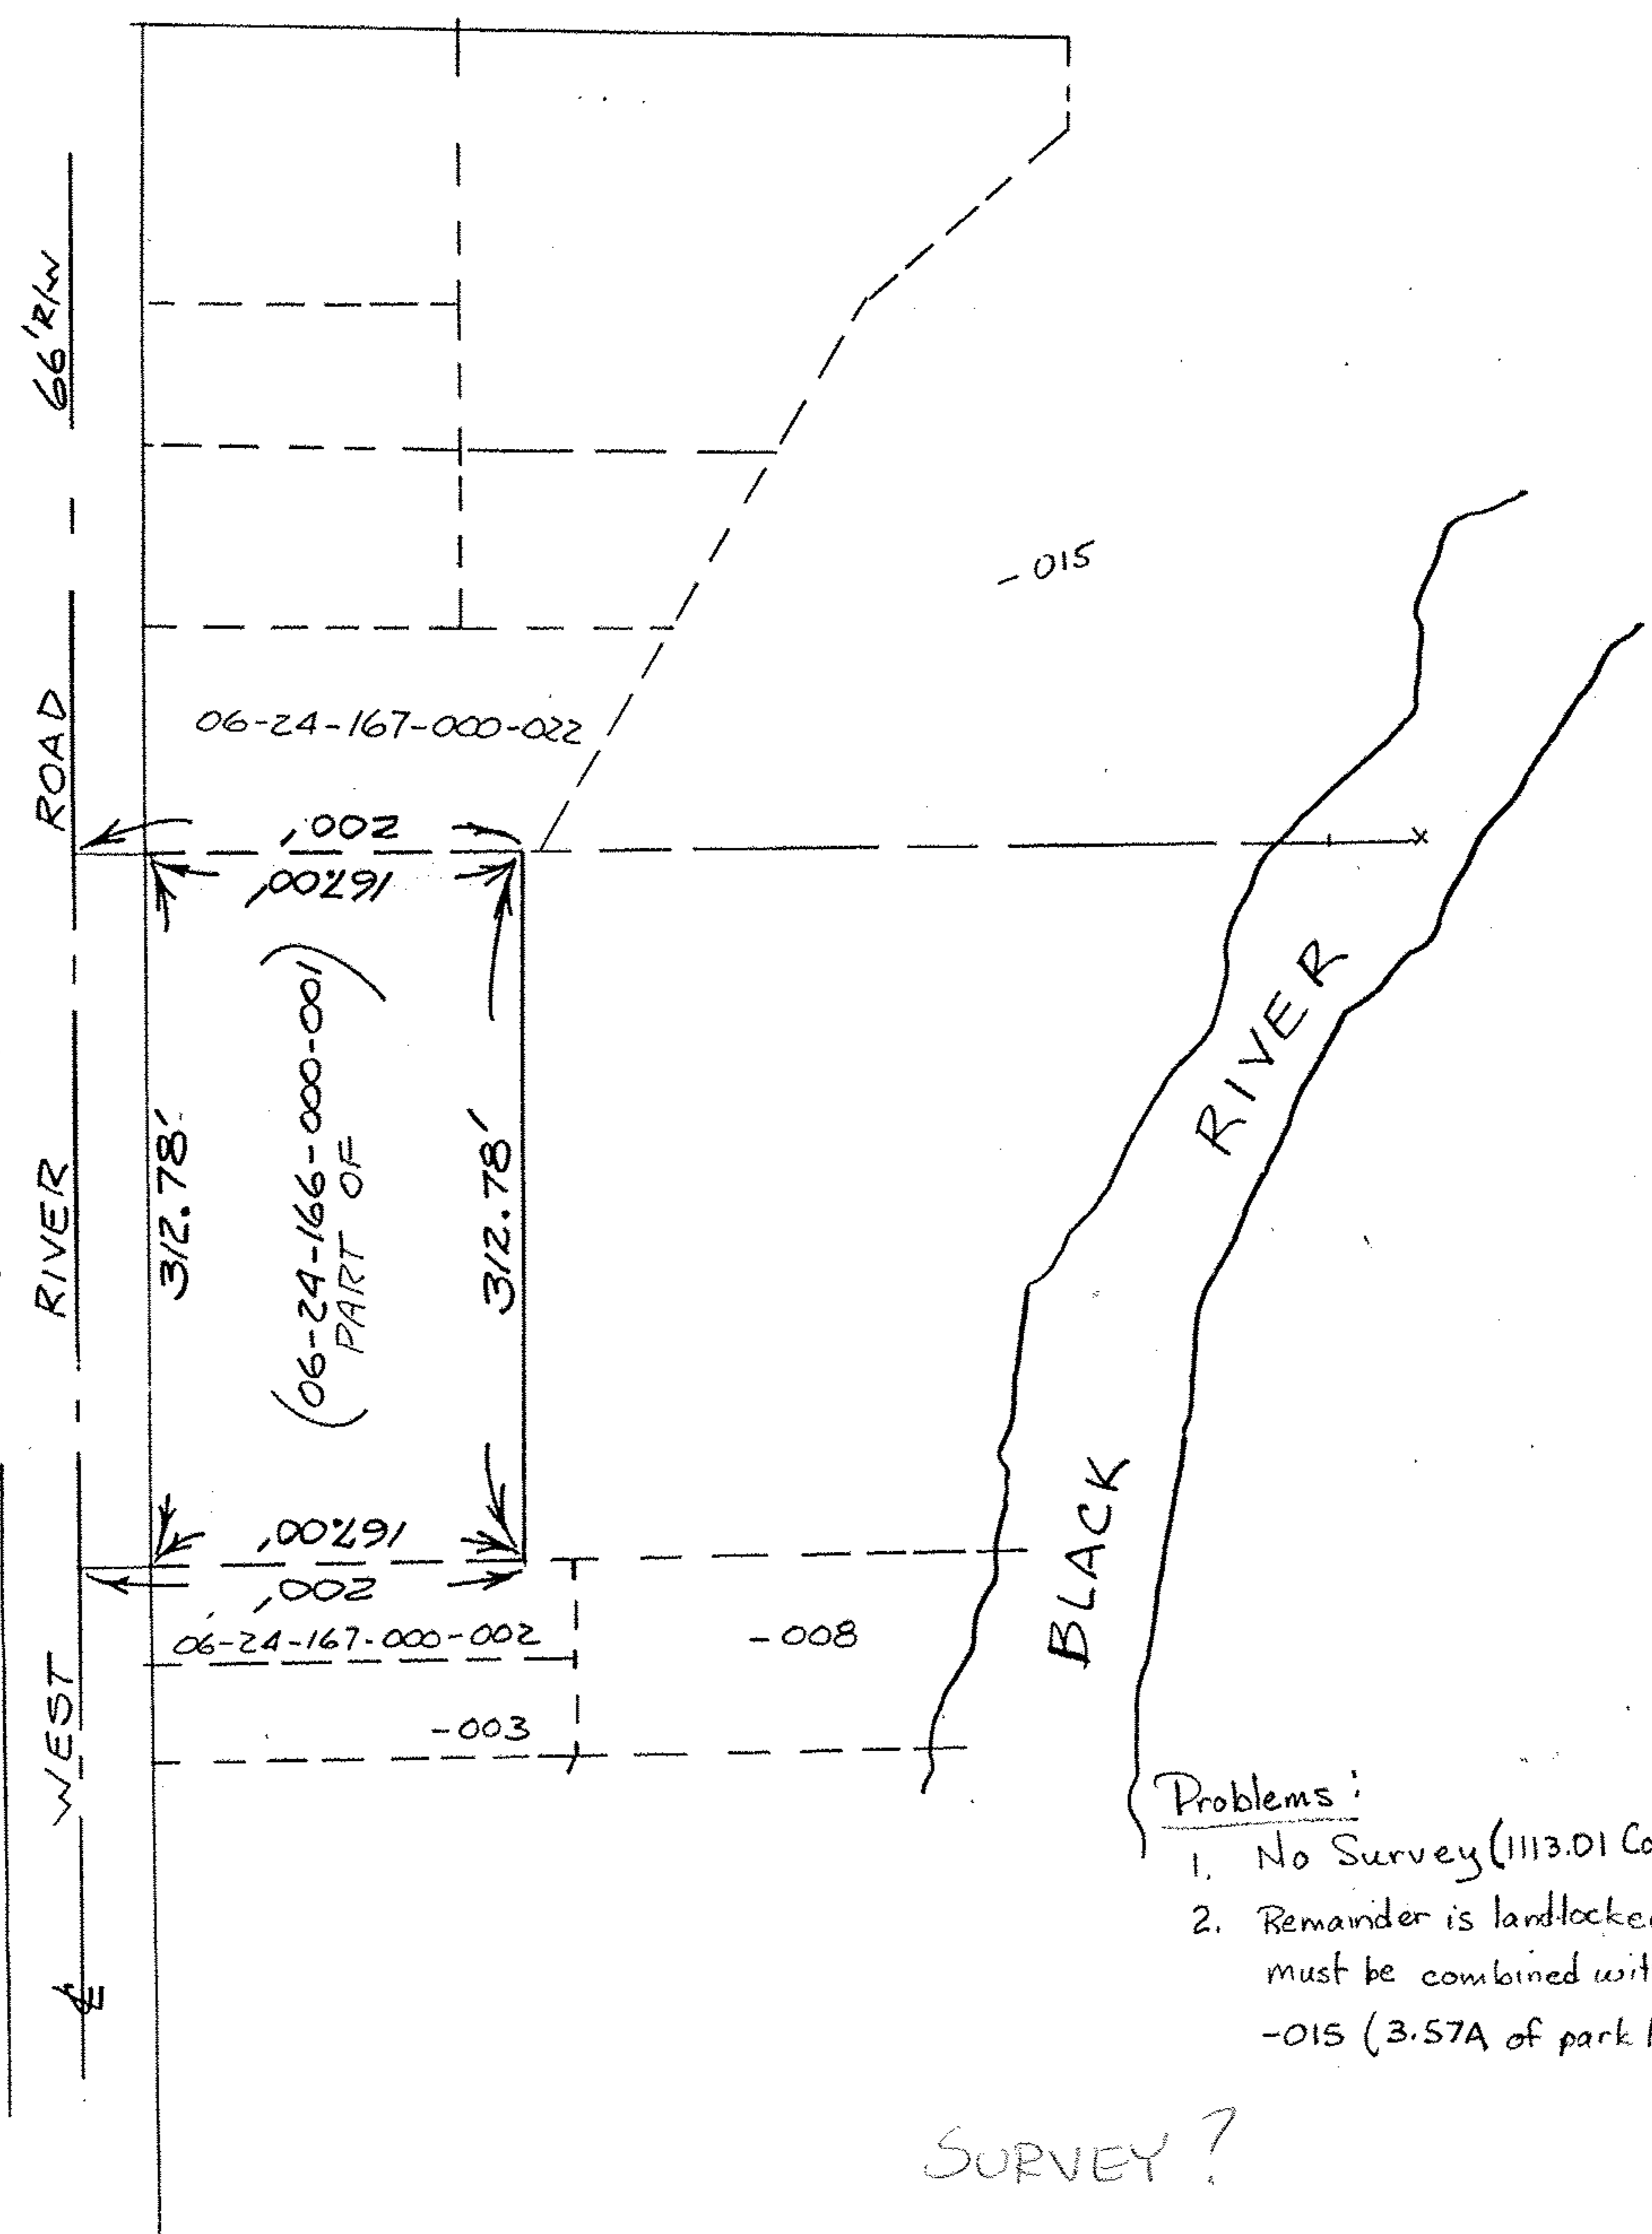

- Problems:
1. No Survey (1113.01 Cod. Or)
 2. Remainder is land-locked - must be combined with -015 (3.57A of park land)

SURVEY?