


#10305

04-00-014-105-055
04-00-014-F
1" = 40' SCAN #47207

APR 15 1977

1. PFD
2. 3.9"

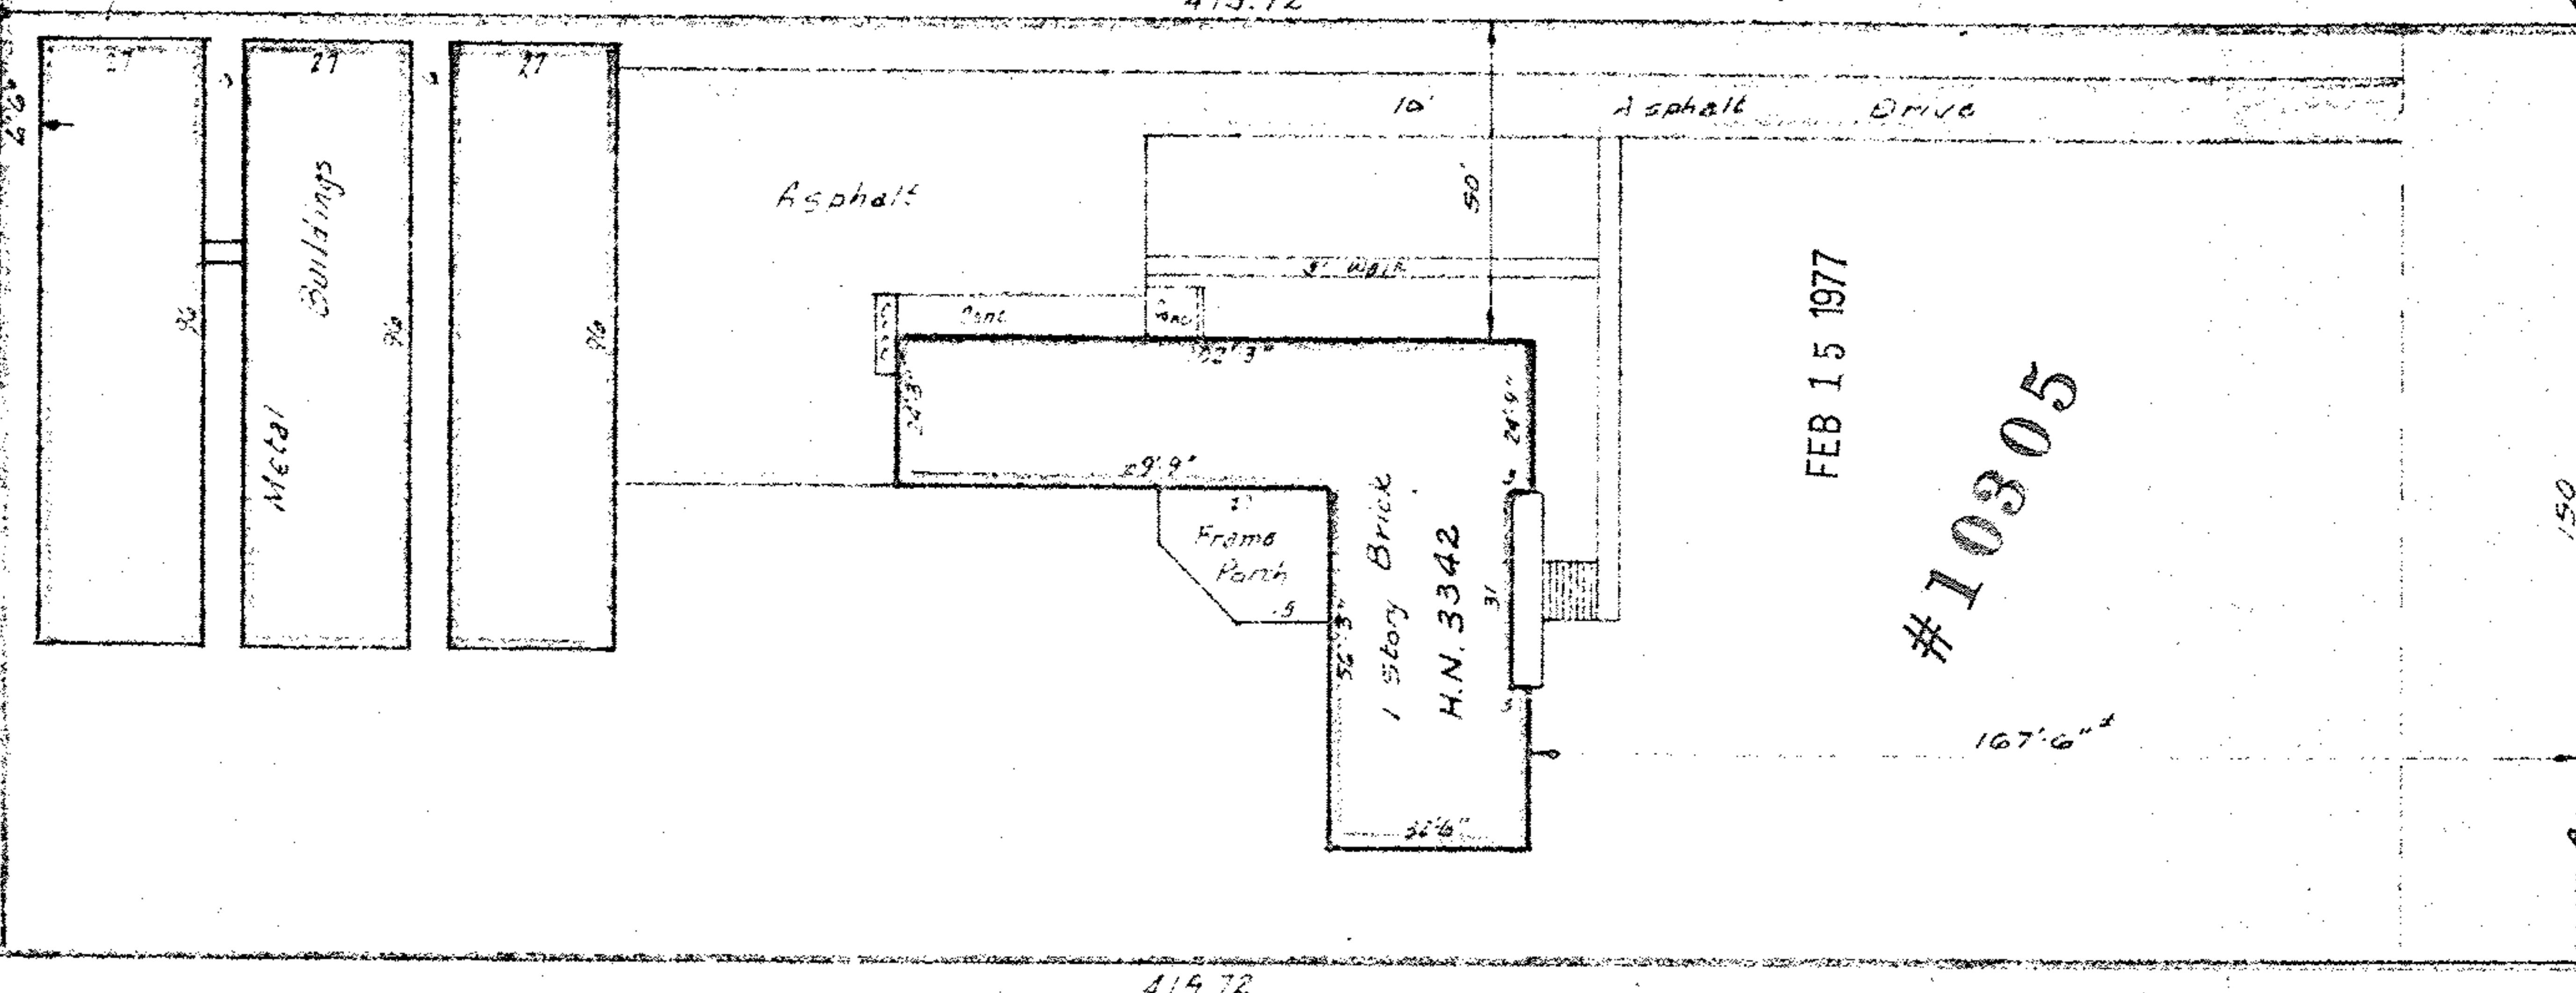

FEB 15 1977

#10305

CENTER ROAD aka S.R. 83

PART of ORIG. AVON TWP. SECTION 14
NOW in CITY of AVON, OHIO

McGLINCHY & ASSOCIATES
FEB. 2, 1977 #771579

ST # L 7804