



# BOUNDARY SURVEY

AT THE REQUEST OF  
MARK A. & SARAH M. ELLIOTT

25777 AKINS ROAD COLUMBIA STATION, OHIO  
KNOWN AS BEING PART OF ORIGINAL COLUMBIA  
TOWNSHIP LOT 52. PARCEL # 12-00-052-000-003  
DEED FILE # 2000-0696541 LORIAN COUNTY RECORDS

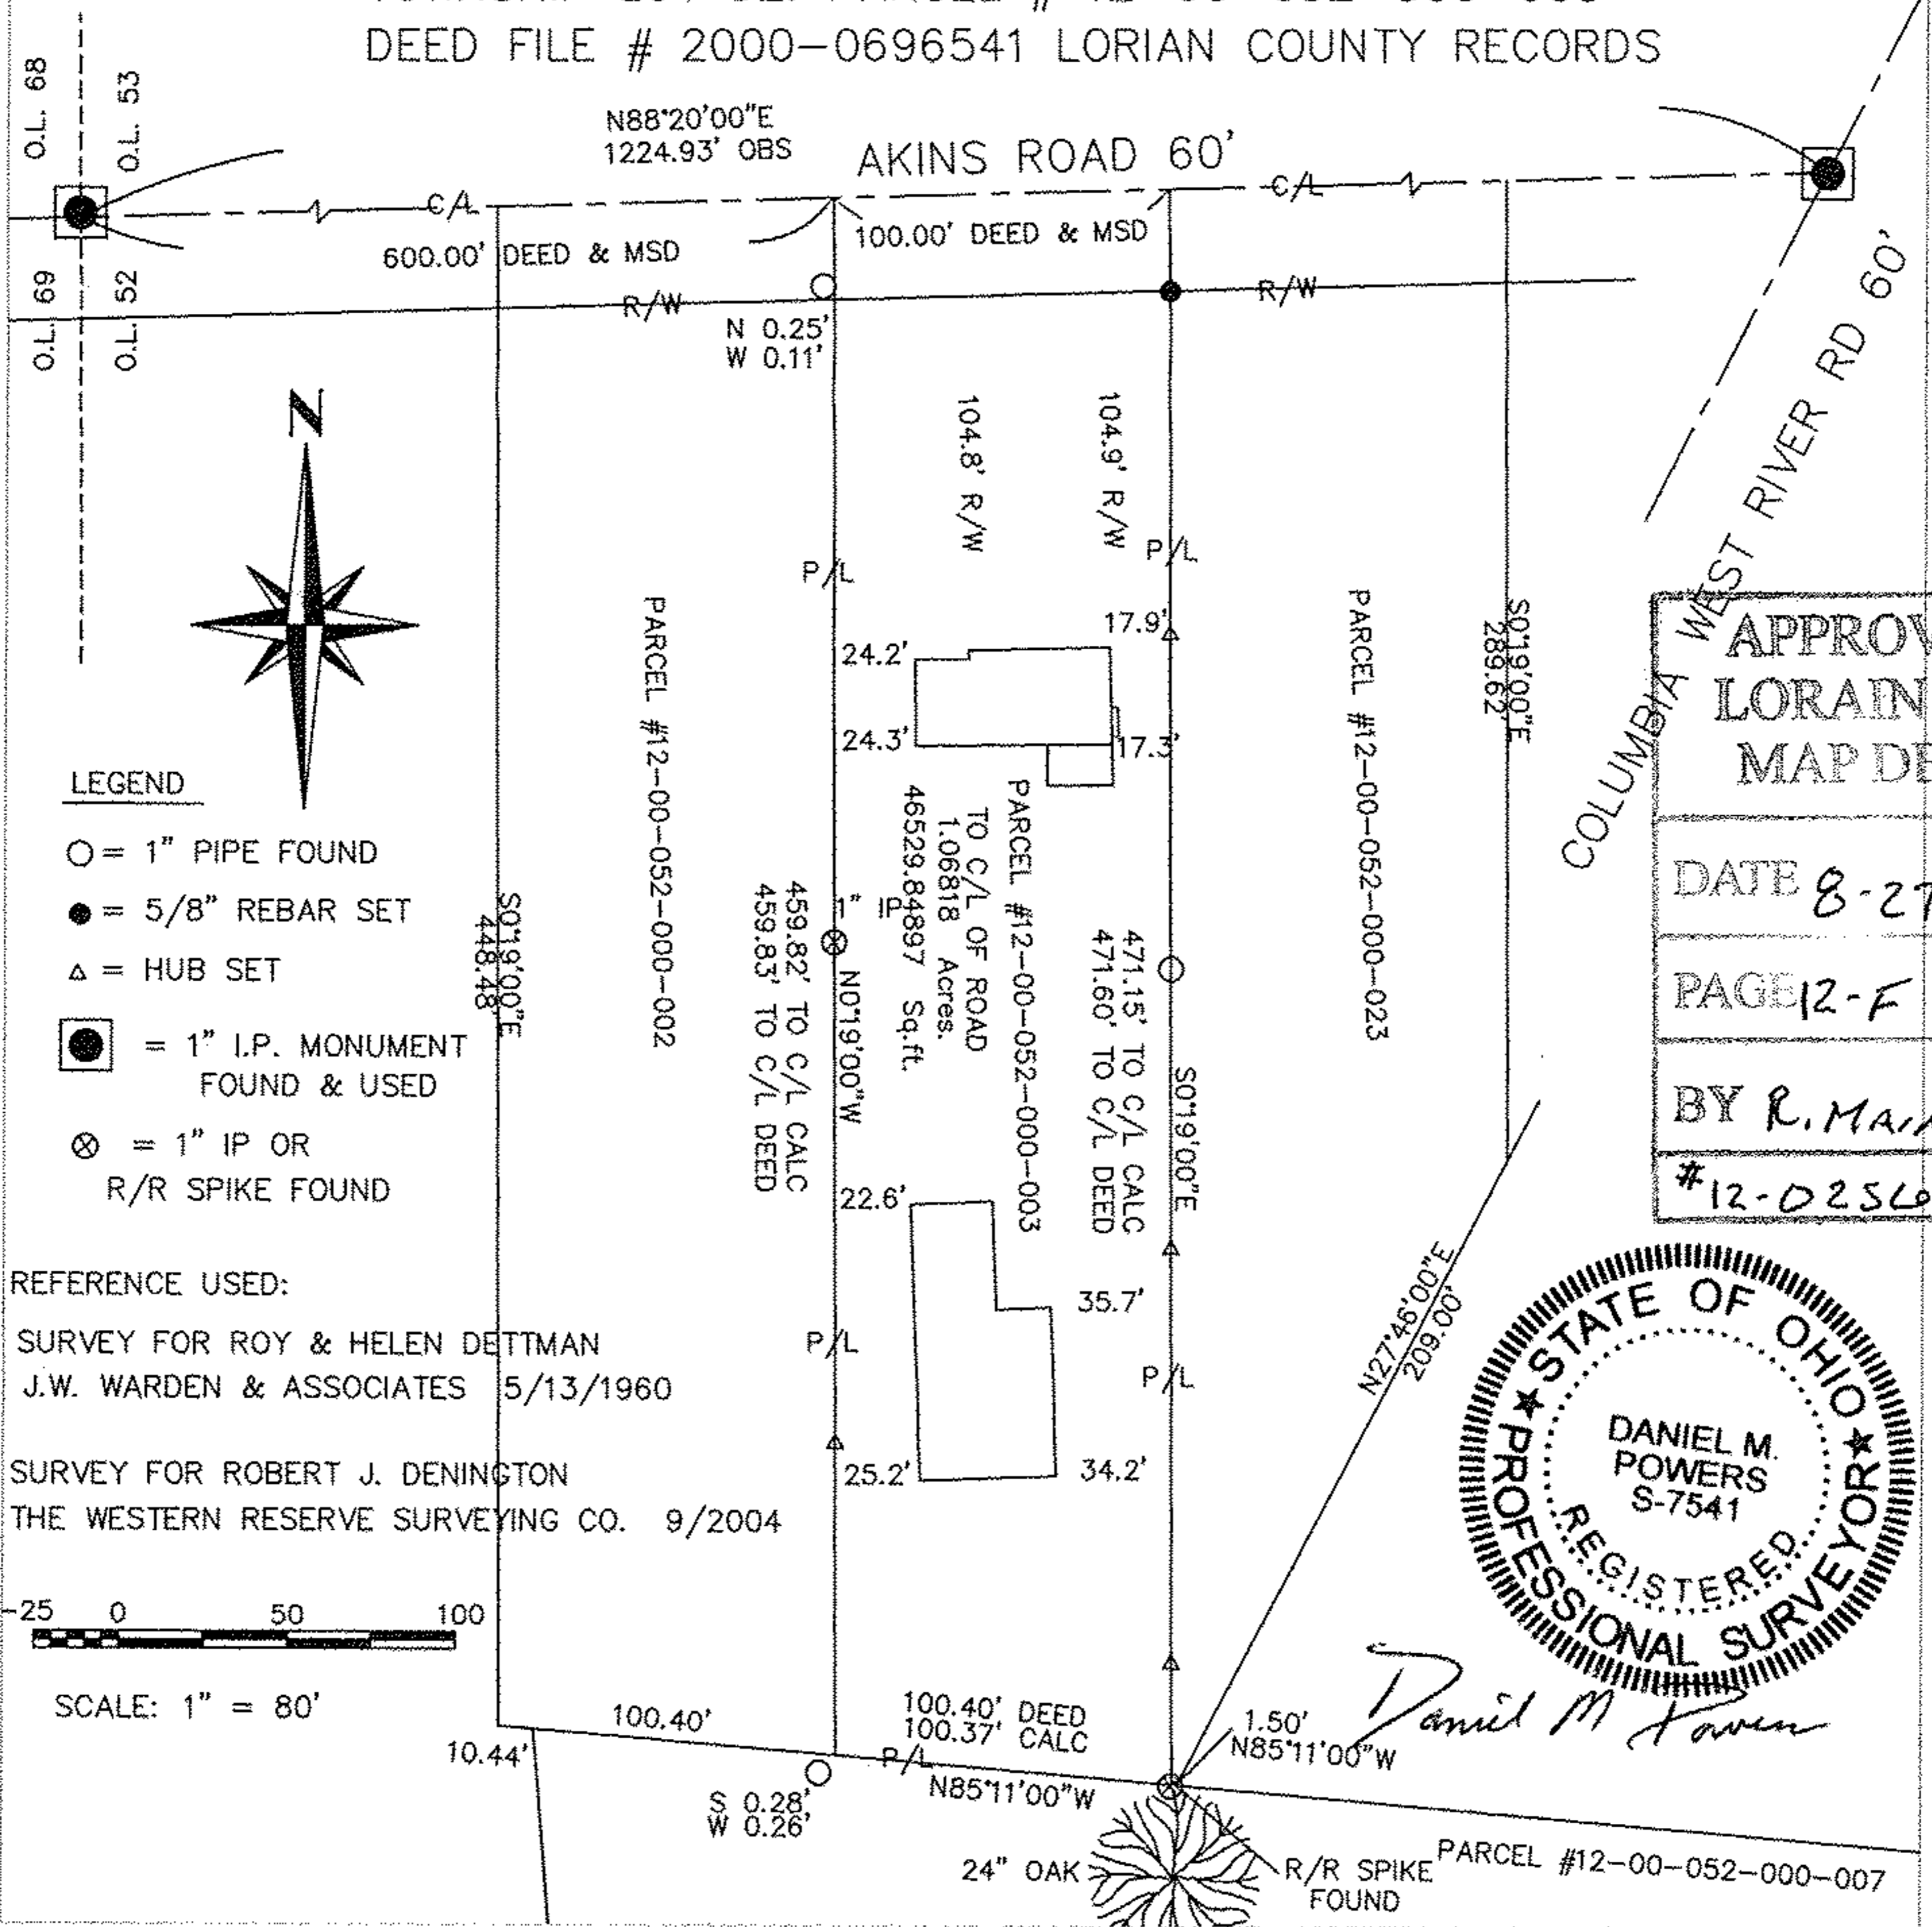

|                                    |
|------------------------------------|
| APPROVED<br>LORAIN CO.<br>MAP DEPT |
| DATE 8-27-12                       |
| PAGE 12-F                          |
| BY R. MAINES                       |
| #12-02562-D                        |

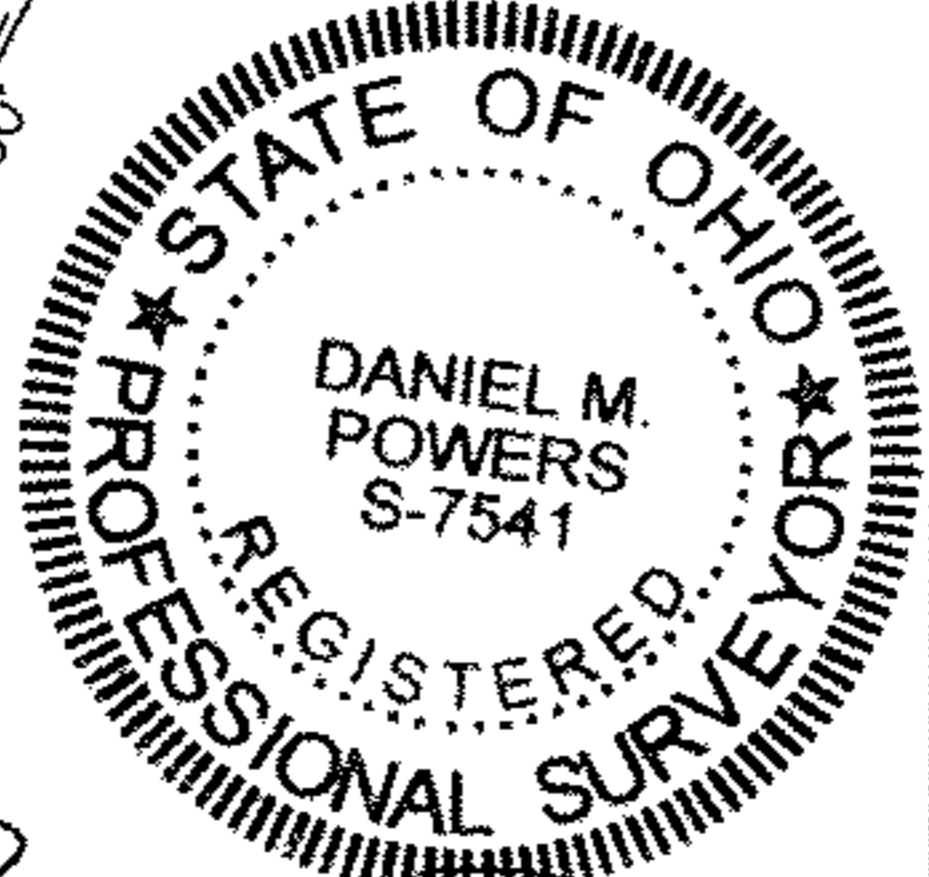

*Daniel M. Powers*

SCAN # 47270  
200-000-250-00-21

EAGLE EYE SURVEYING  
791 TWILIGHT DRIVE  
SEVEN HILLS, OHIO 44131  
PHONE: 216-328-1935

REV DATE: 7/24/12  
DATE: 7/20/12  
SCALE: 1" = 80'

SURVEYOR'S DECLARATION  
MONUMENTS WERE FOUND OR SET AS SHOWN HEREON.  
DIMENSIONS ARE EXPRESSED IN FEET AND DECIMAL  
PARTS THEREOF. BEARINGS ARE TO AN ASSUMED  
MERIDIAN AND ARE USED TO DENOTE ANGLES ONLY  
ALL OF WHICH I CERTIFY TO BE CORRECT TO THE BEST  
OF MY KNOWLEDGE AND BELIEF.