


04-00-016-101-
Scan # 41405

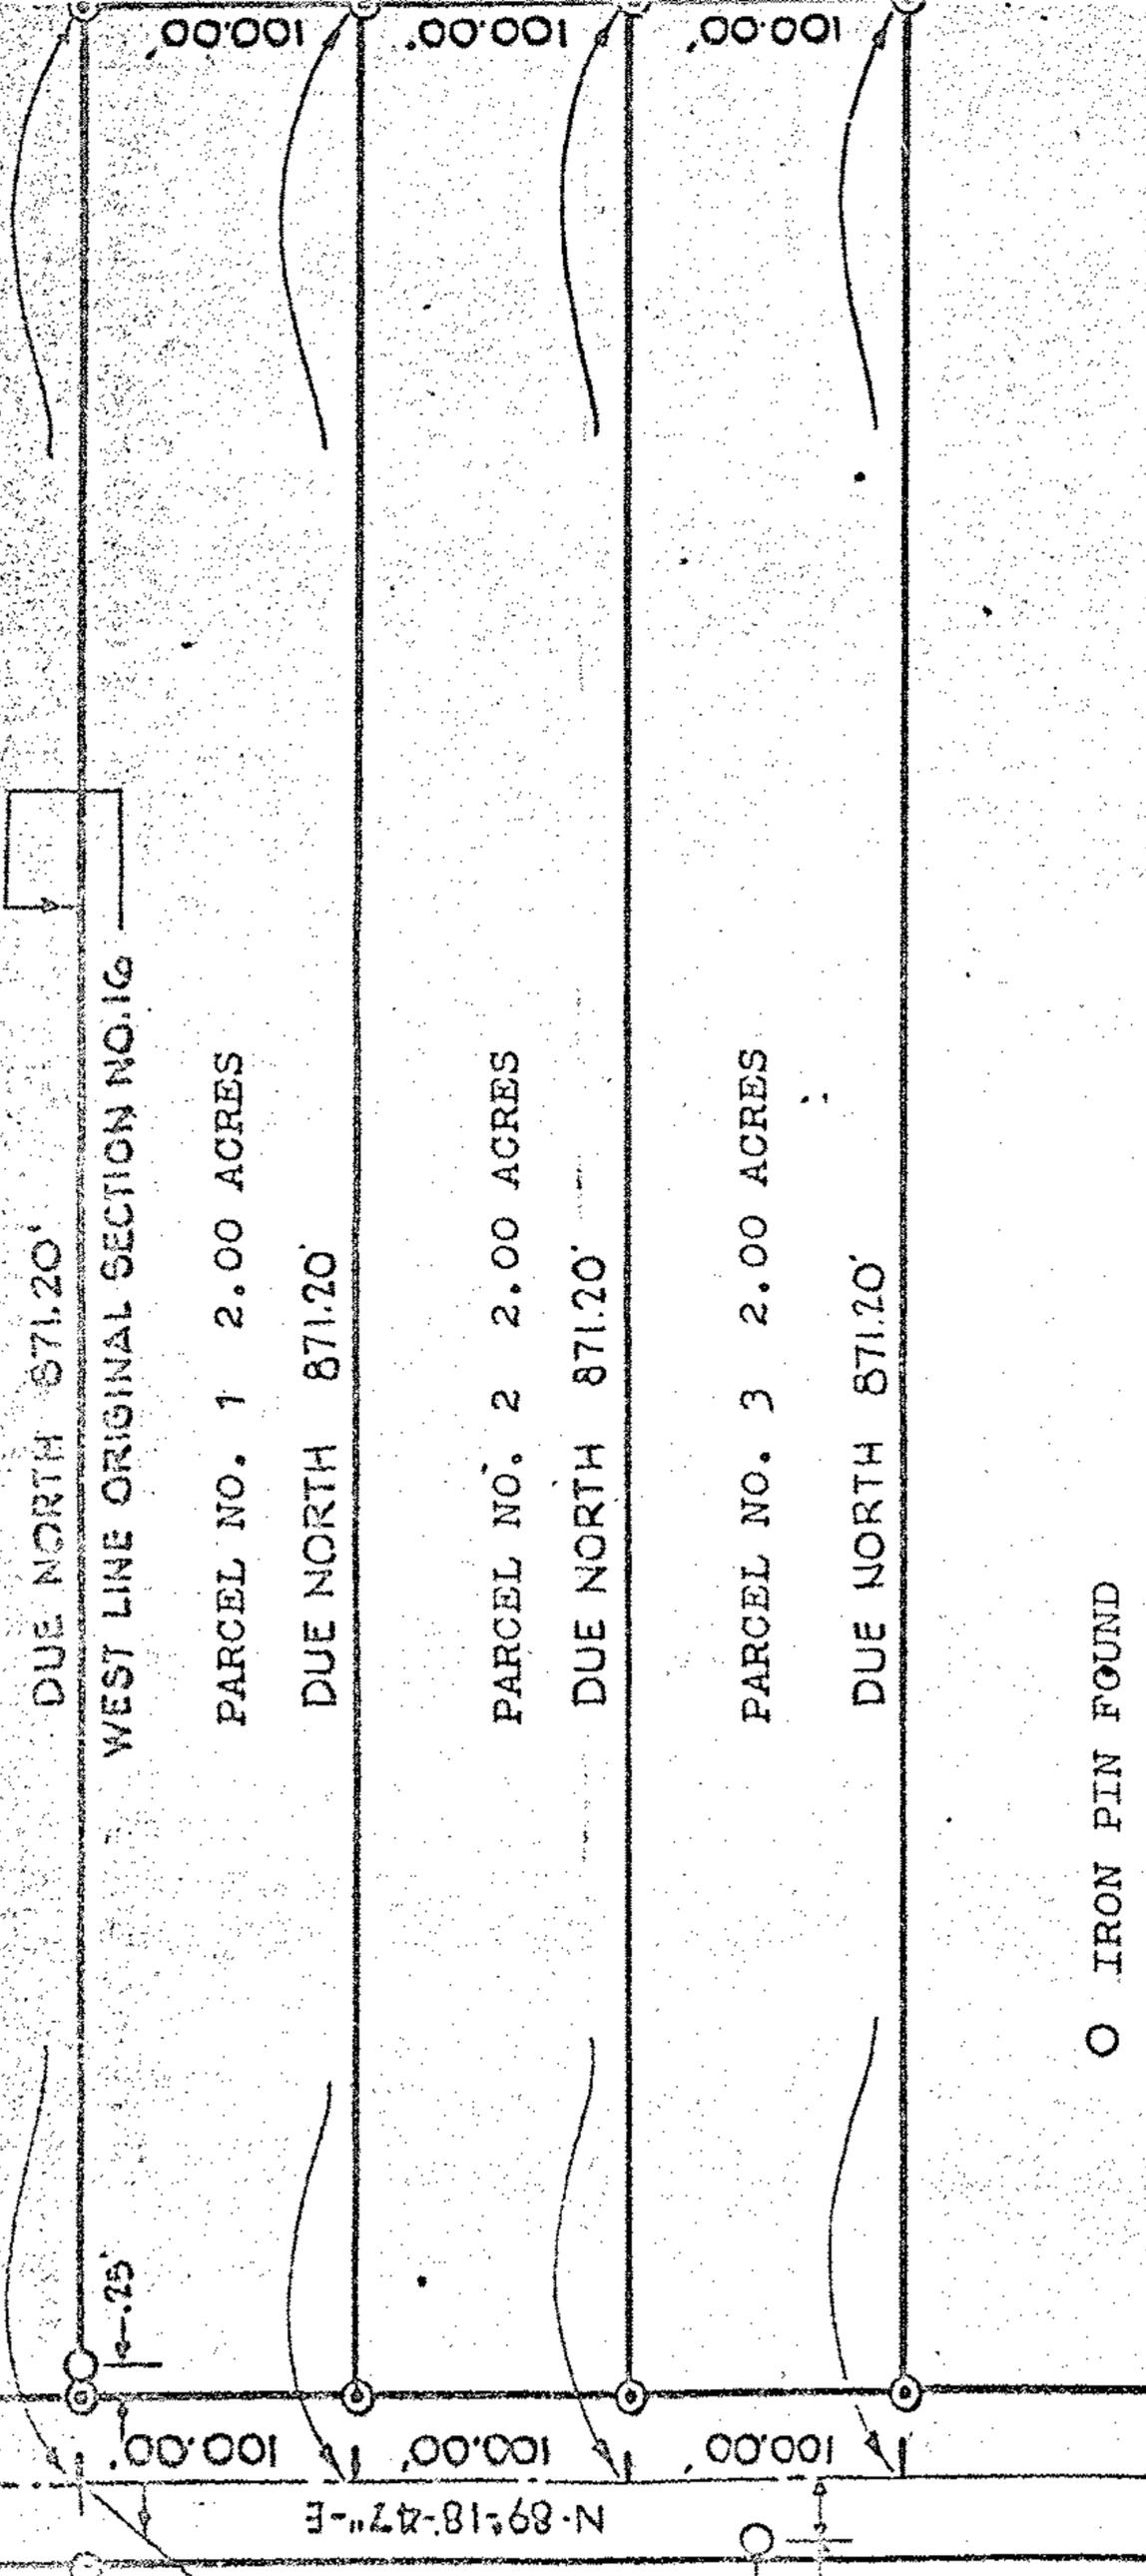

PARCEL NO. 1 2.00 ACRES

PARCEL NO. 2 2.00 ACRES

PARCEL NO. 3 2.00 ACRES

- IRON PIN FOUND
- ⊙ IRON PIN SET

SURVEY OF PART OF ORIGINAL SECTION NO. 16
 AVON TOWNSHIP, NOW WITHIN THE CORPORATE
 LIMITS OF THE CITY OF AVON
 LORAIN COUNTY, OHIO
 SCALE 1"=100

MAR 19 1976

NORMAN R. HURA, Registered surveyor

JULY 10, 1975

9484
4-00-016E