



# KLEINOEDER · SCHMIDT and ASSOCIATES

ENGINEERS — SURVEYORS — CONSULTANTS in LAND PLANNING

ELYRIA · NORWALK · MEDINA

OHIO

## SURVEY

Sublot(s) \_\_\_\_\_

Subd'n \_\_\_\_\_

Township COLUMBIA

Tract \_\_\_\_\_


Orig. Lot(s) 89

Sec. \_\_\_\_\_

County of LORAIN

State of Ohio

Corporation \_\_\_\_\_

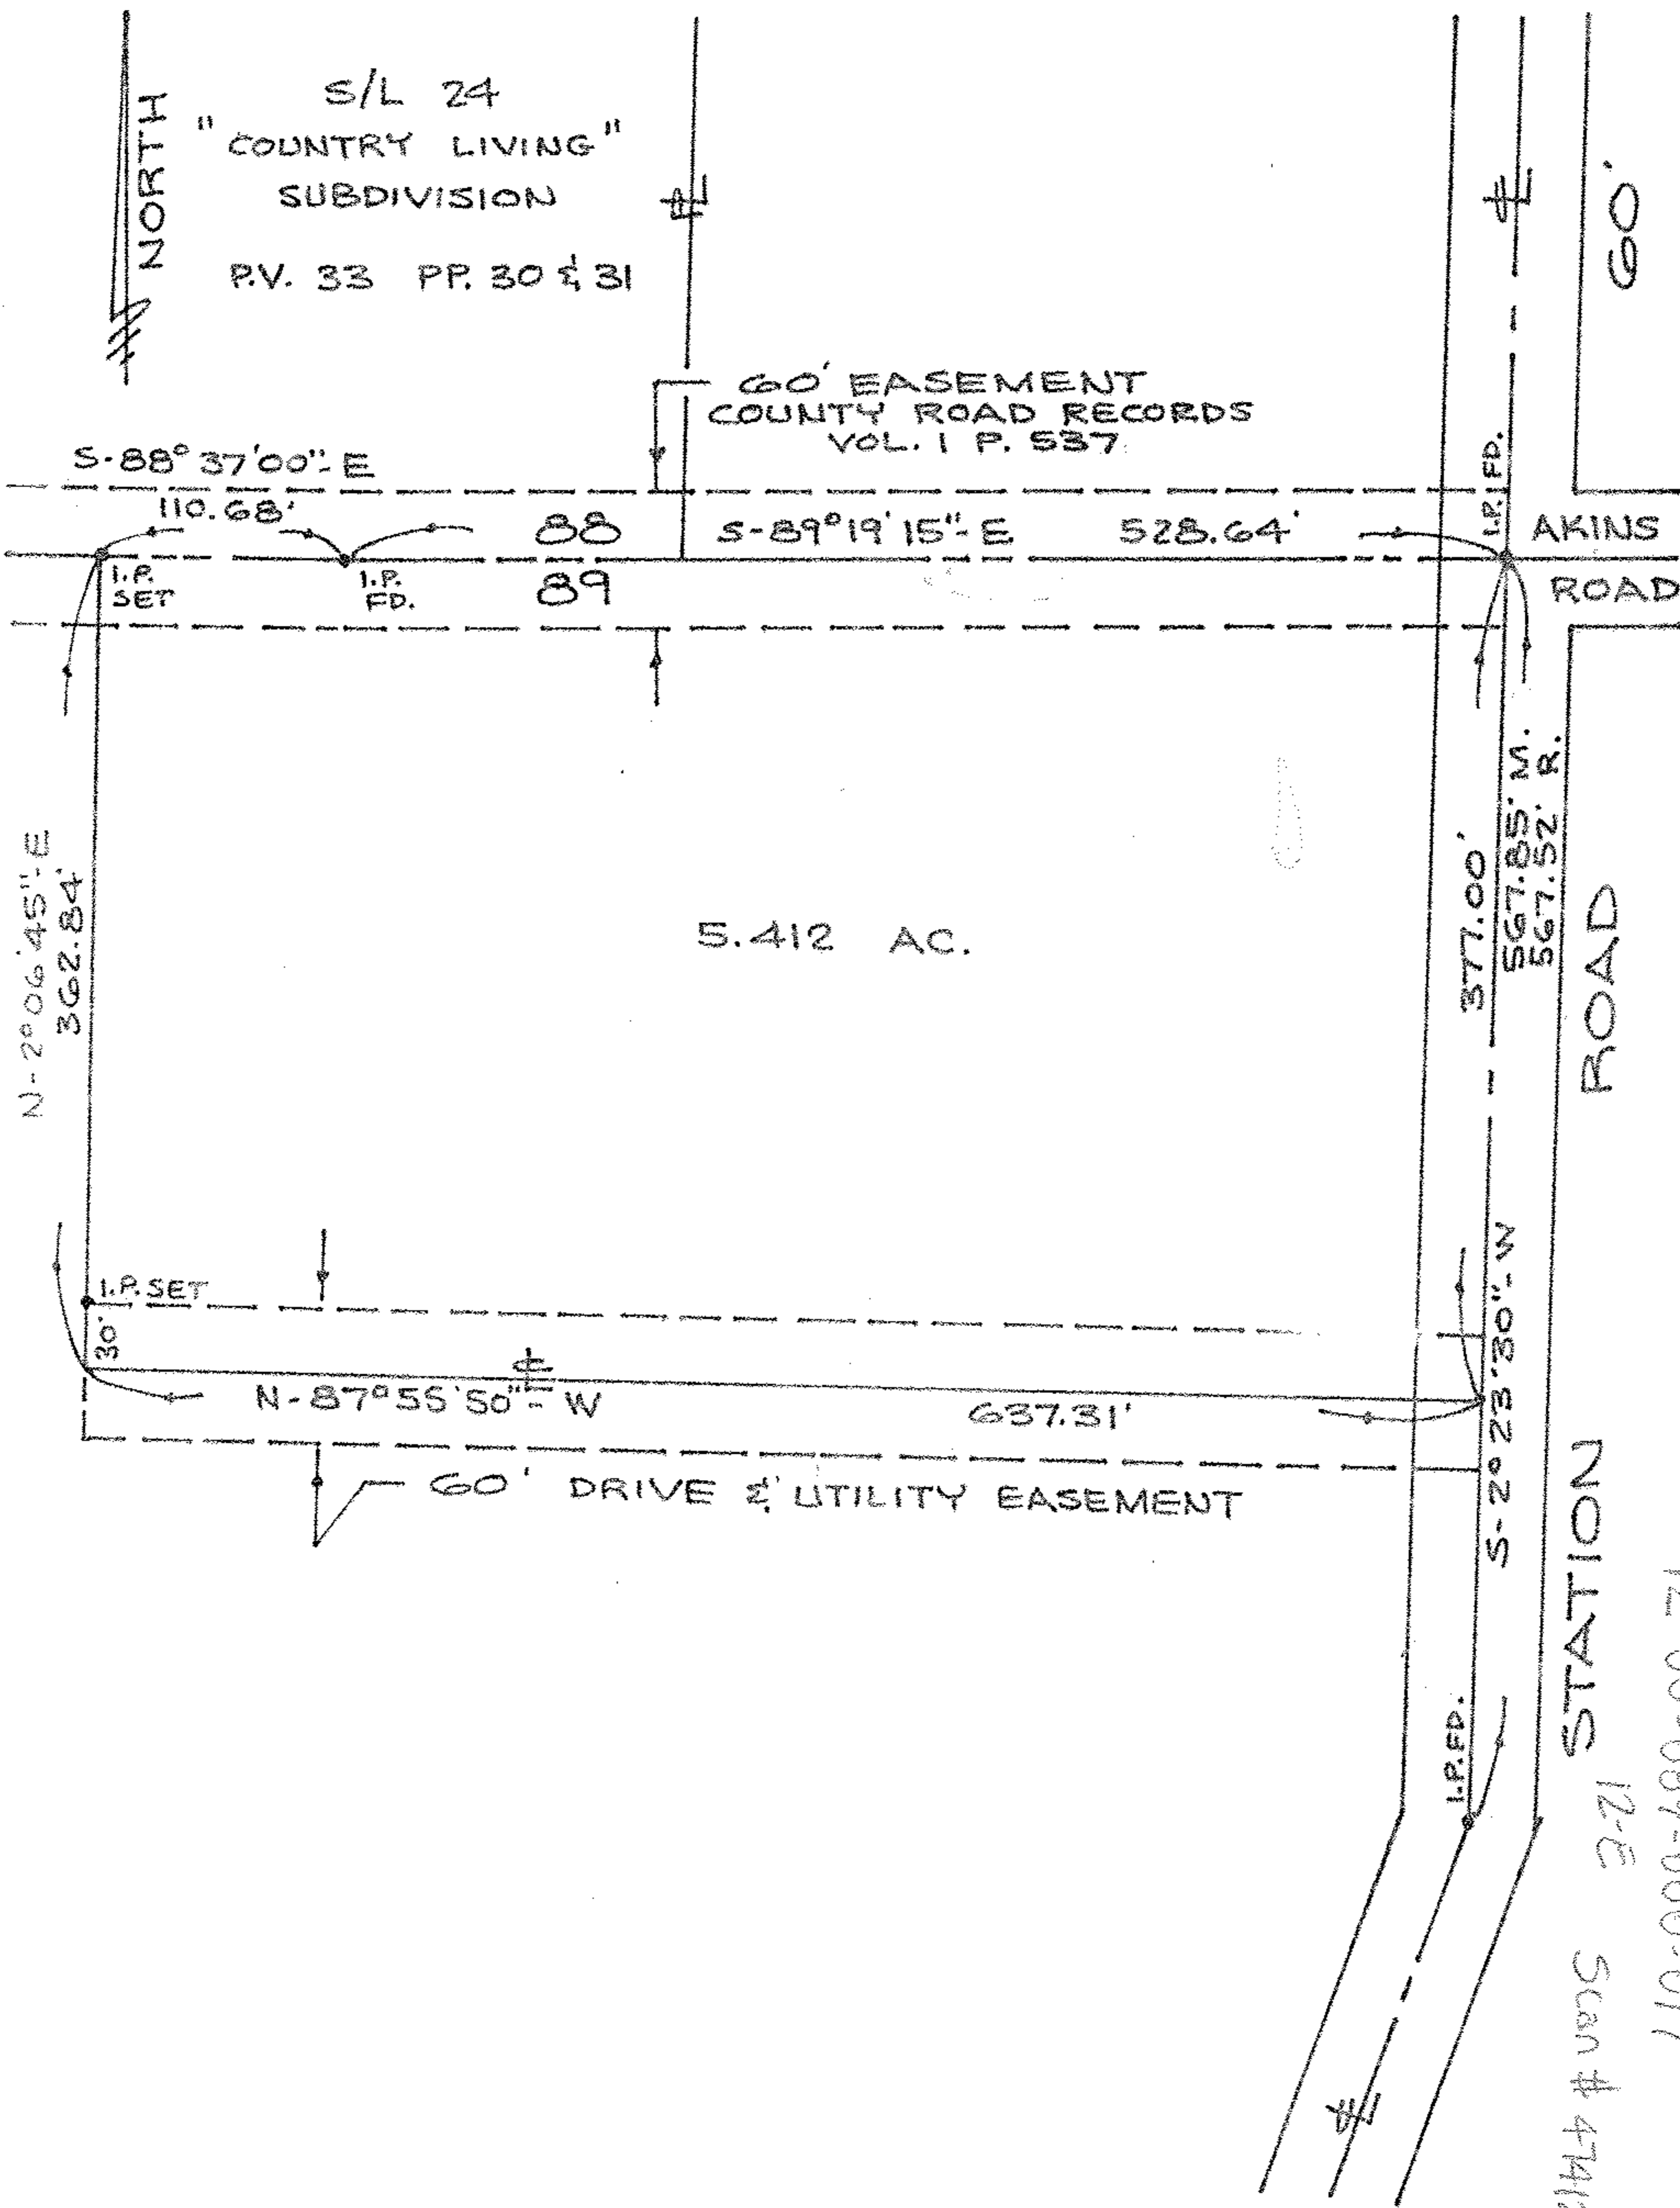

12-00-089-000-017

12-E Scan # 47412

Prepared for: **JOHN LONTOR**

Scale: 1" = 100'

Date: 4-19-79

Dr. by: *JS*

Job No: 77-294