


13-08-003-000-006

Scan # 47415

#13310

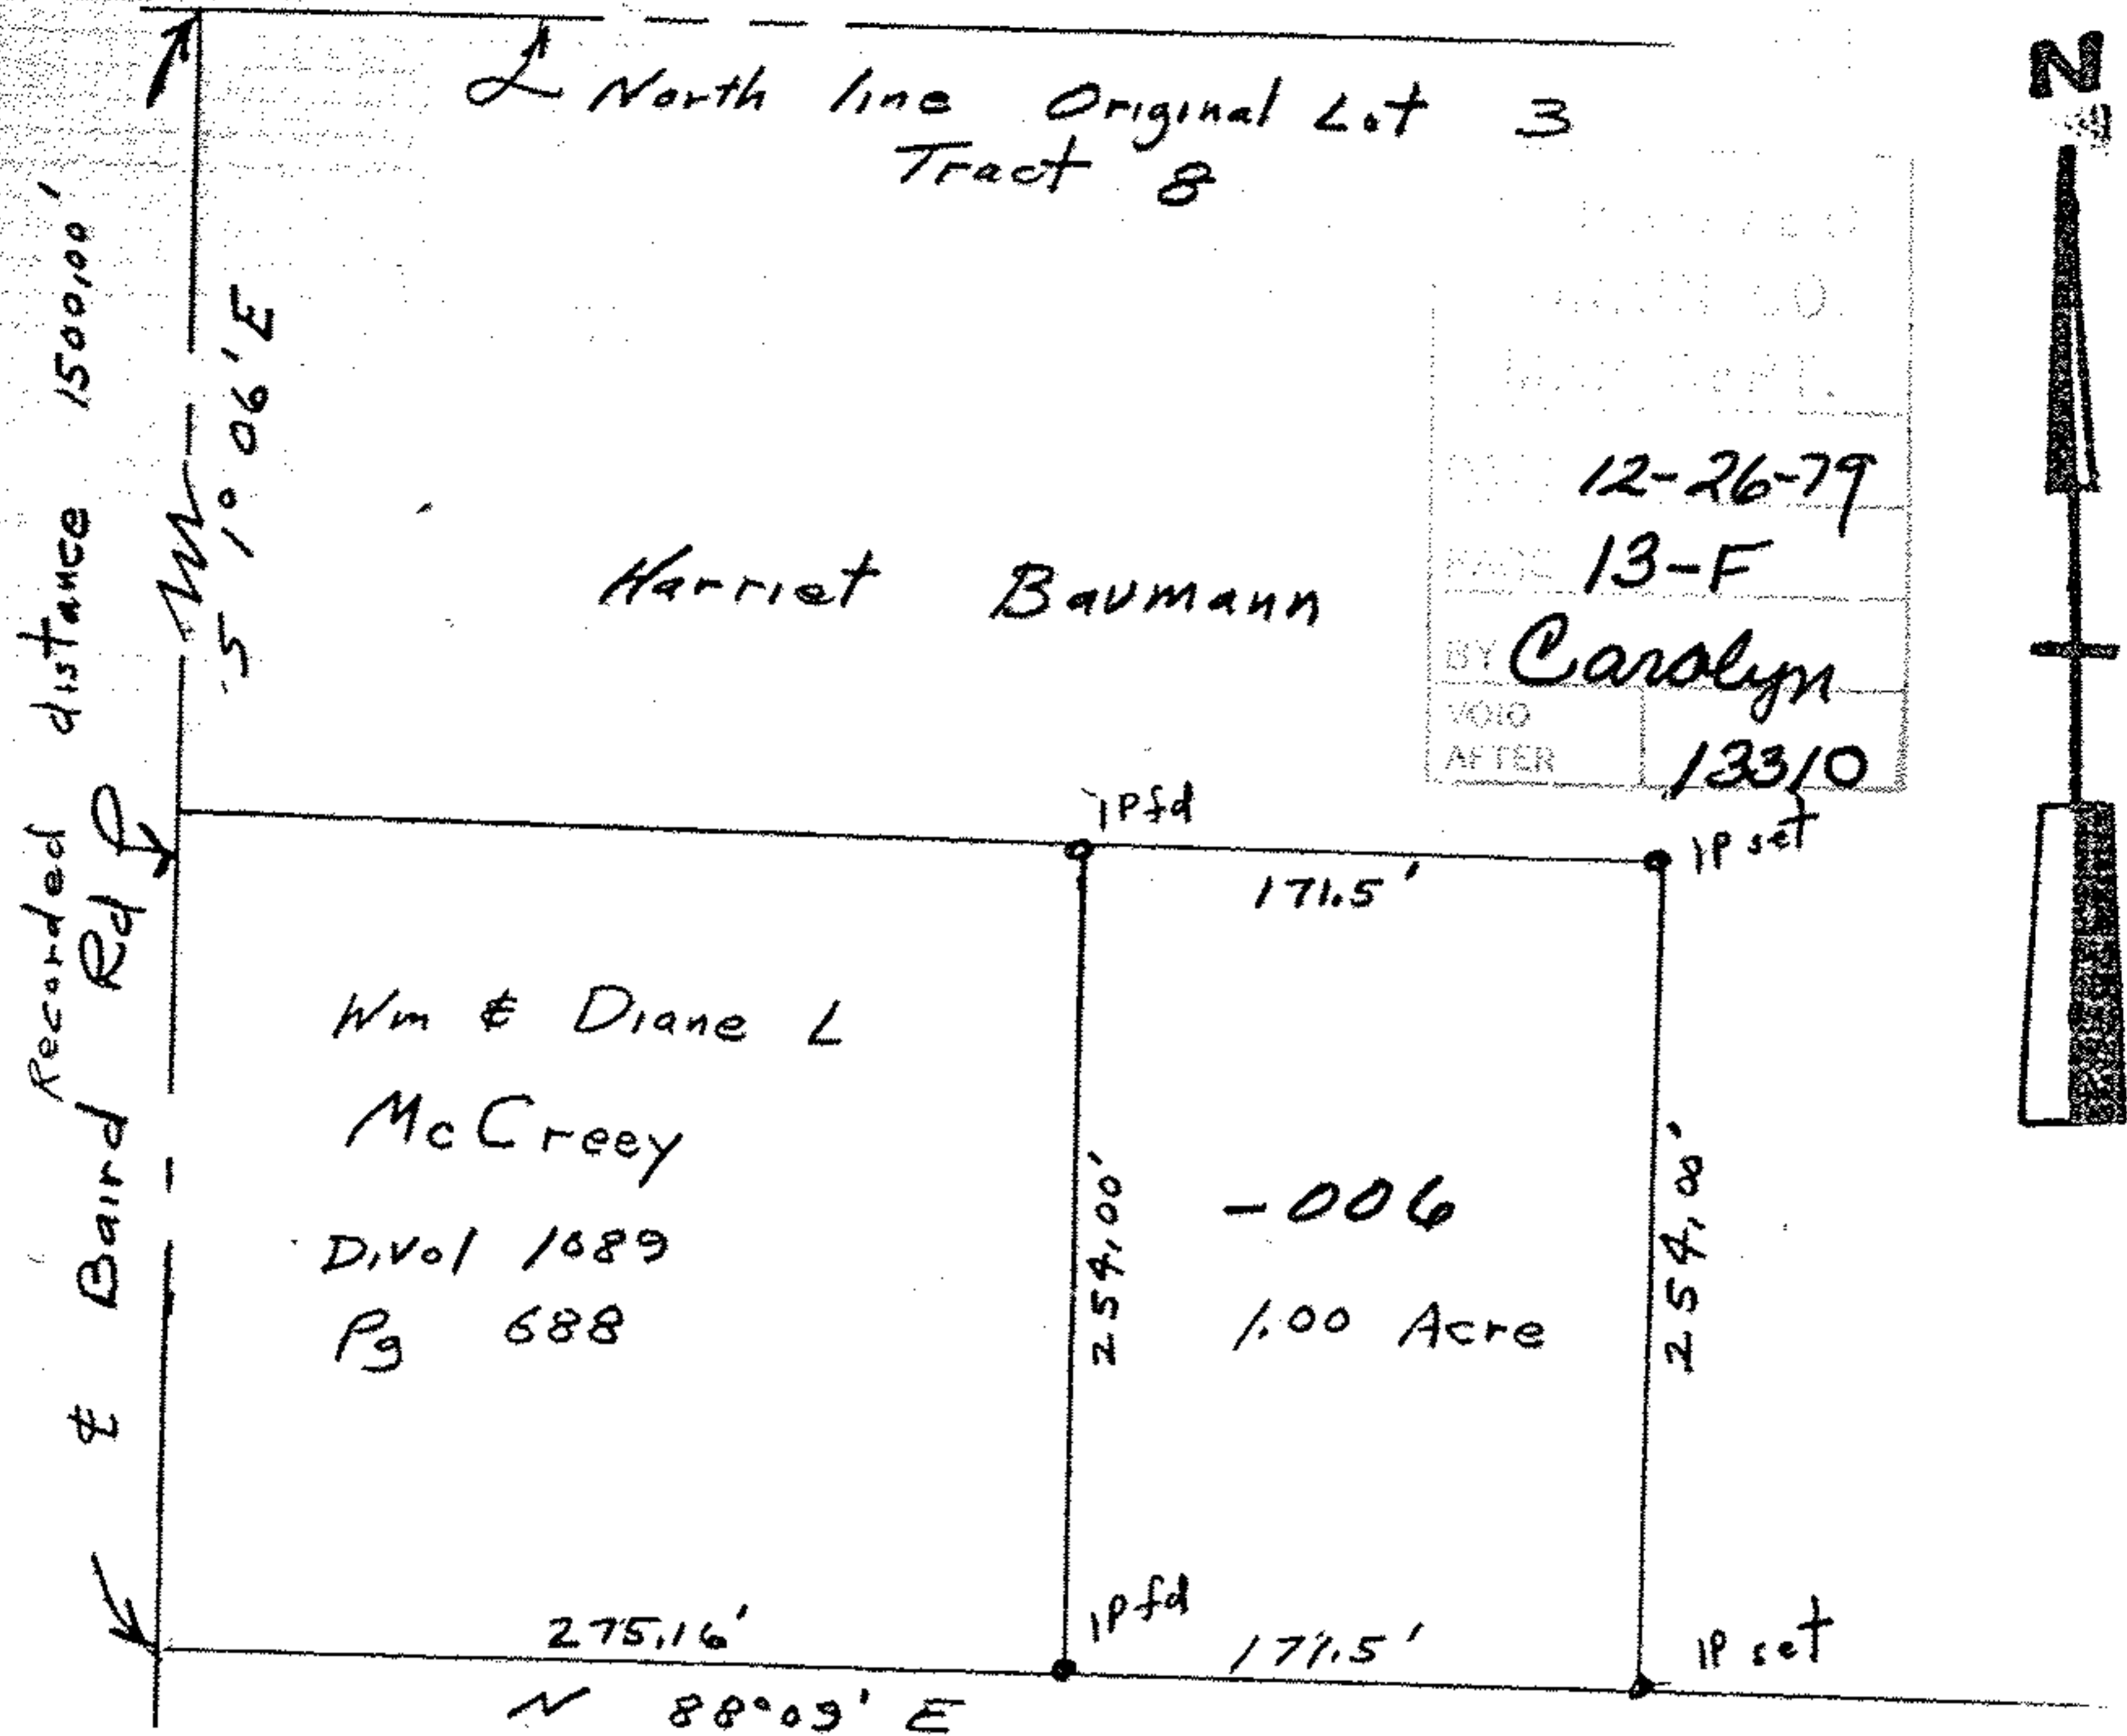

North line Original Lot 3  
Tract 8

Harriet Baumann

Wm & Diane L  
McCreey  
Divol 1089  
Pg 688

-006  
1.00 Acre

275.16'  
N 88°09' E

Robert W & Doris J. Pitts

DATE	12-26-79
PAGE	13-F
BY	Carolyn
VOID AFTER	13310

Recorded distance 1500.00'  
Baird Rd

510.06' E

1Pfd

1P set

254.00'

254.00'

1Pfd

1P set

John Poznywal  
Reg Surveyor  
# 5292

Survey for  
Wm McCreey  
Part of Original Lot 3  
Tract 8 Camden Twp  
Lorain County Ohio  
scale 1" = 100' May 1979