

ENGINEERS
504 MIDDLE AVE.

SURVEYORS
ELYRIA, OHIO 4035


JAN 3 1980

FOR: OBERLIN SERVICE INC. % ATTY. MICHAEL M. BOYLAN

OWNSHIP RUSSIA
ORIG. LOT or SEC. 86
CITY OBERLIN

VILLAGE
COUNTY LORAIN
STATE OHIO

DATE JAN. 3, 1980
SCALE 1"=30
JOB NO. 79-937 F.B. —

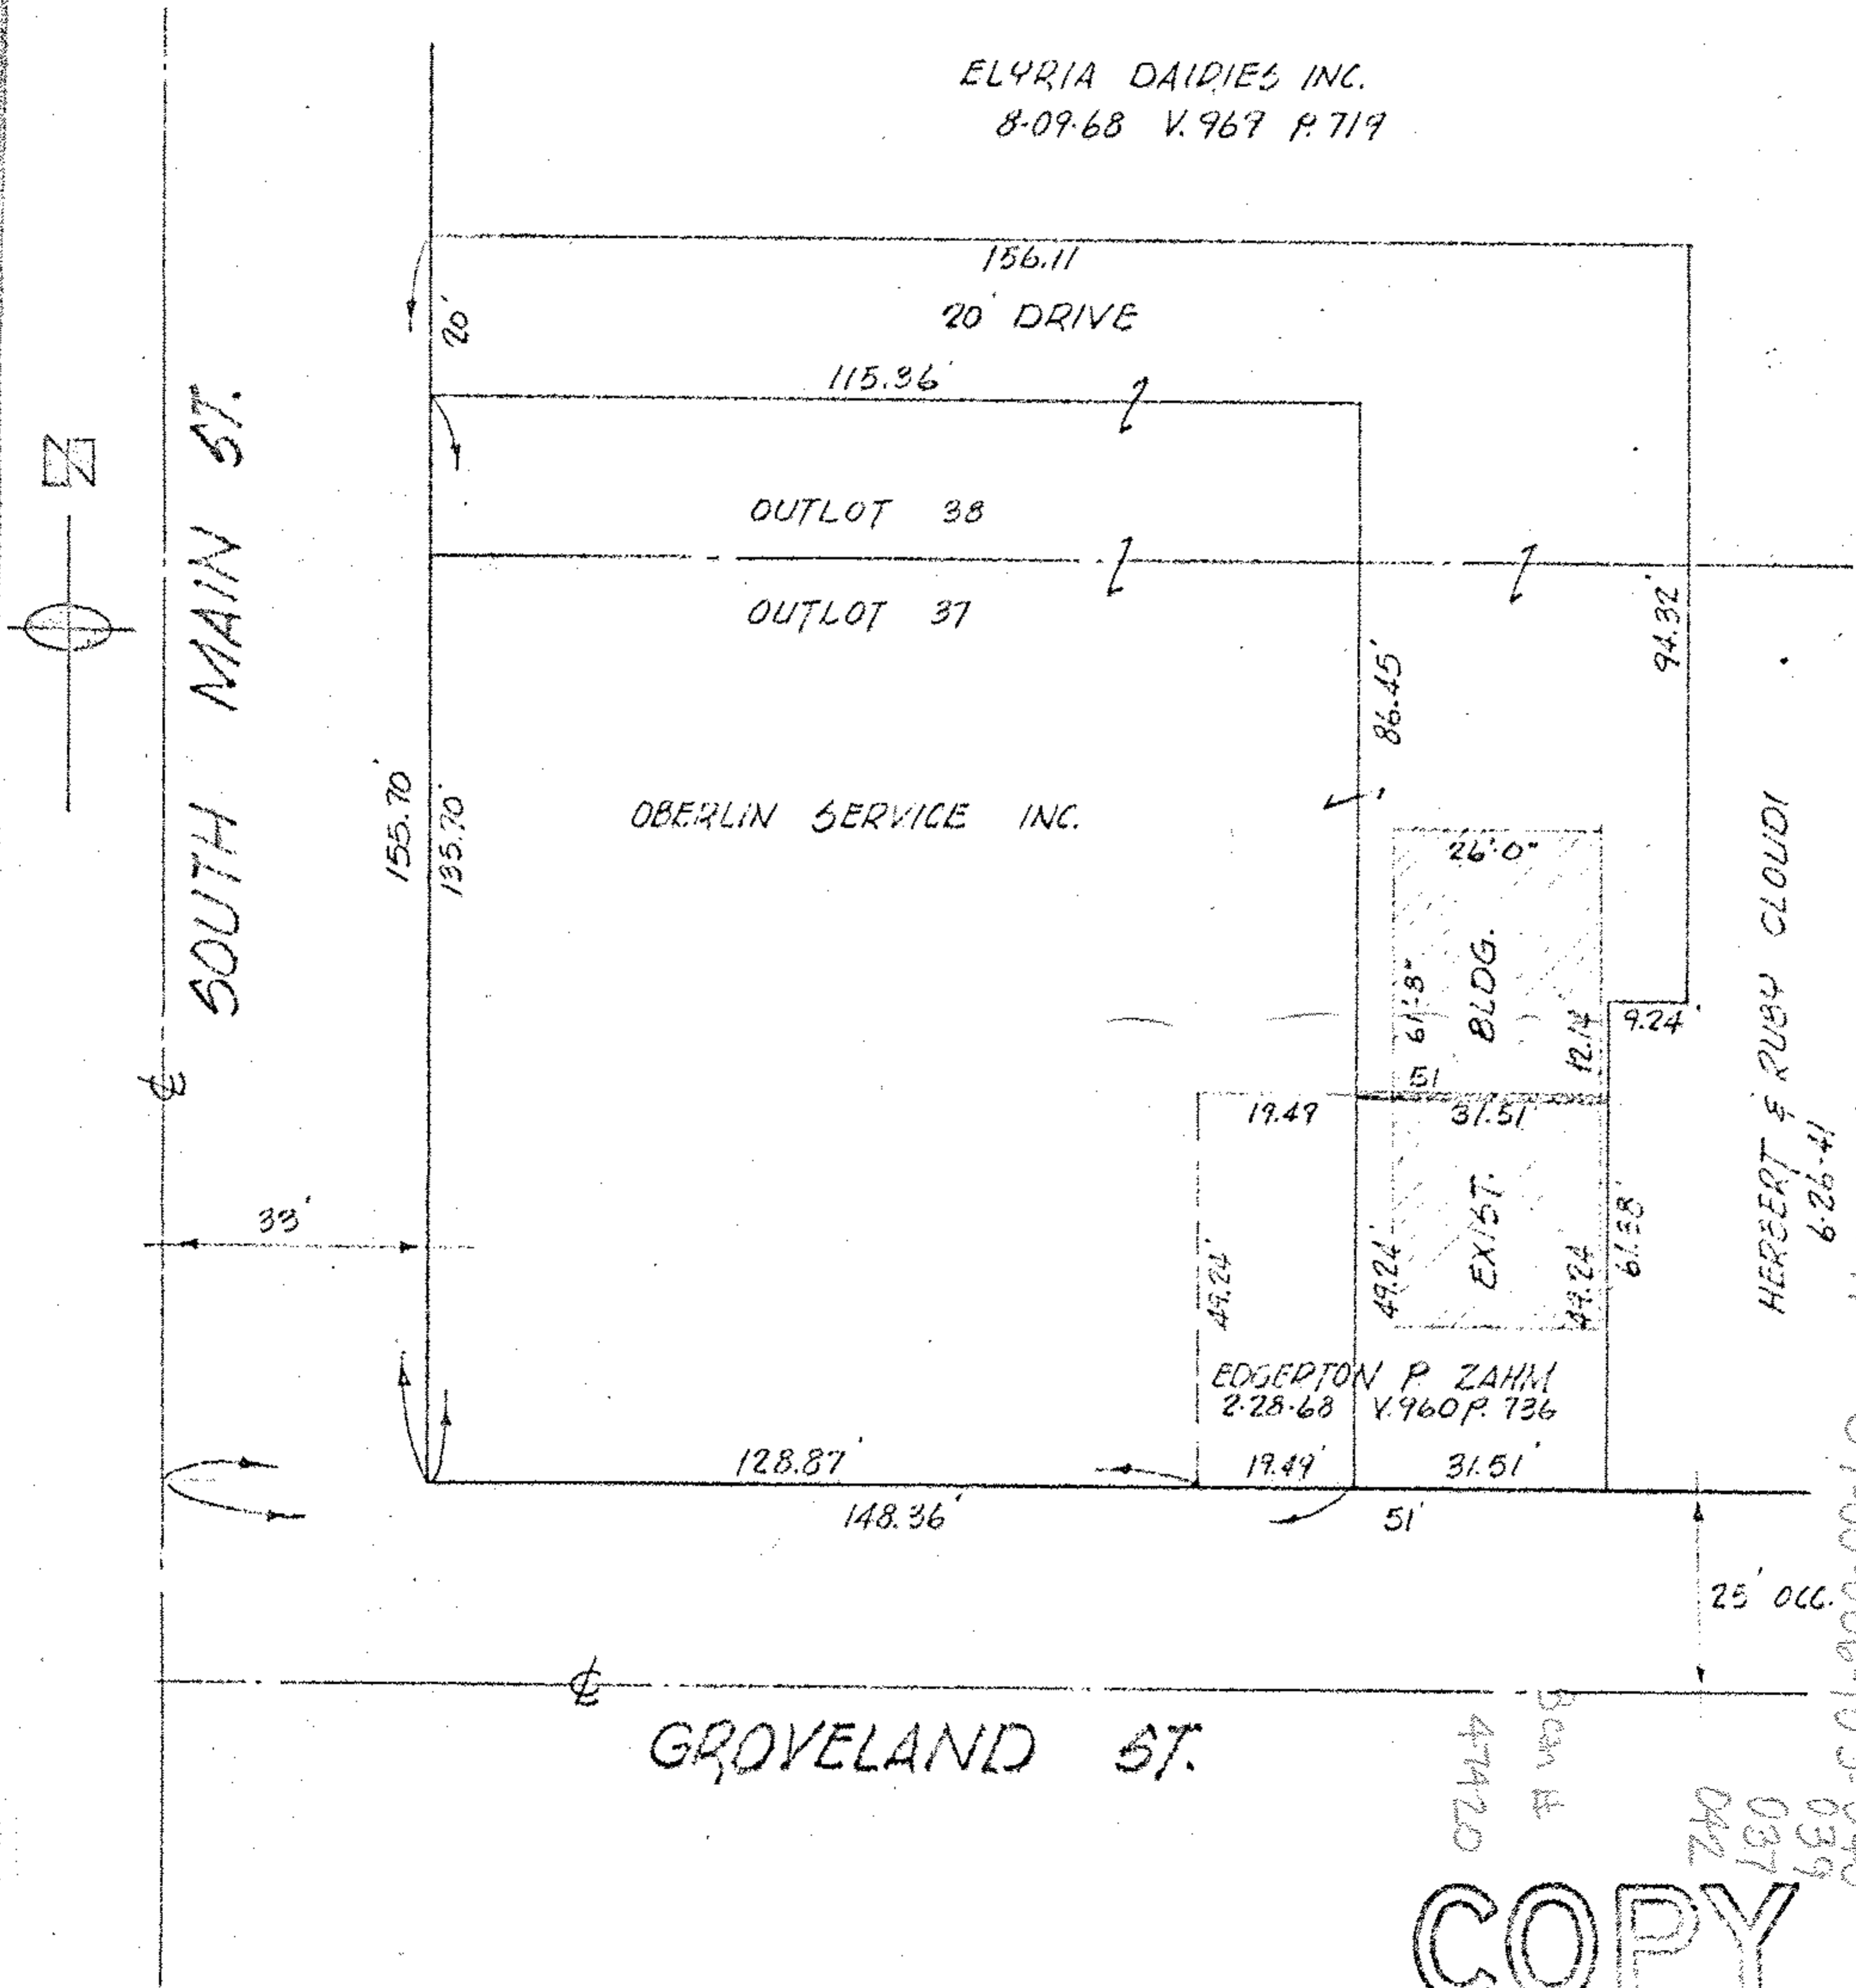

HERBERT & RUBY CLOUD
4-9-29
6-26-41

EDGERTON P. ZAHM
2-28-68 V.960 P.736

ELYRIA DAIRIES INC.
8-09-68 V.969 P.719

OBERLIN SERVICE INC.

GROVELAND ST.

SOUTH MAIN ST.

COPY

09-00-086-7A
09-00-086-103-040

47420
B.C.M. &
D.A.L.

037
039