


12-00-048-000-021
Scan # 47432

BOUNDARY SURVEY
JERRY STEADMAN
COLUMBIA TOWNSHIP



MAY 26, 1994
SCALE: 1" = 100'

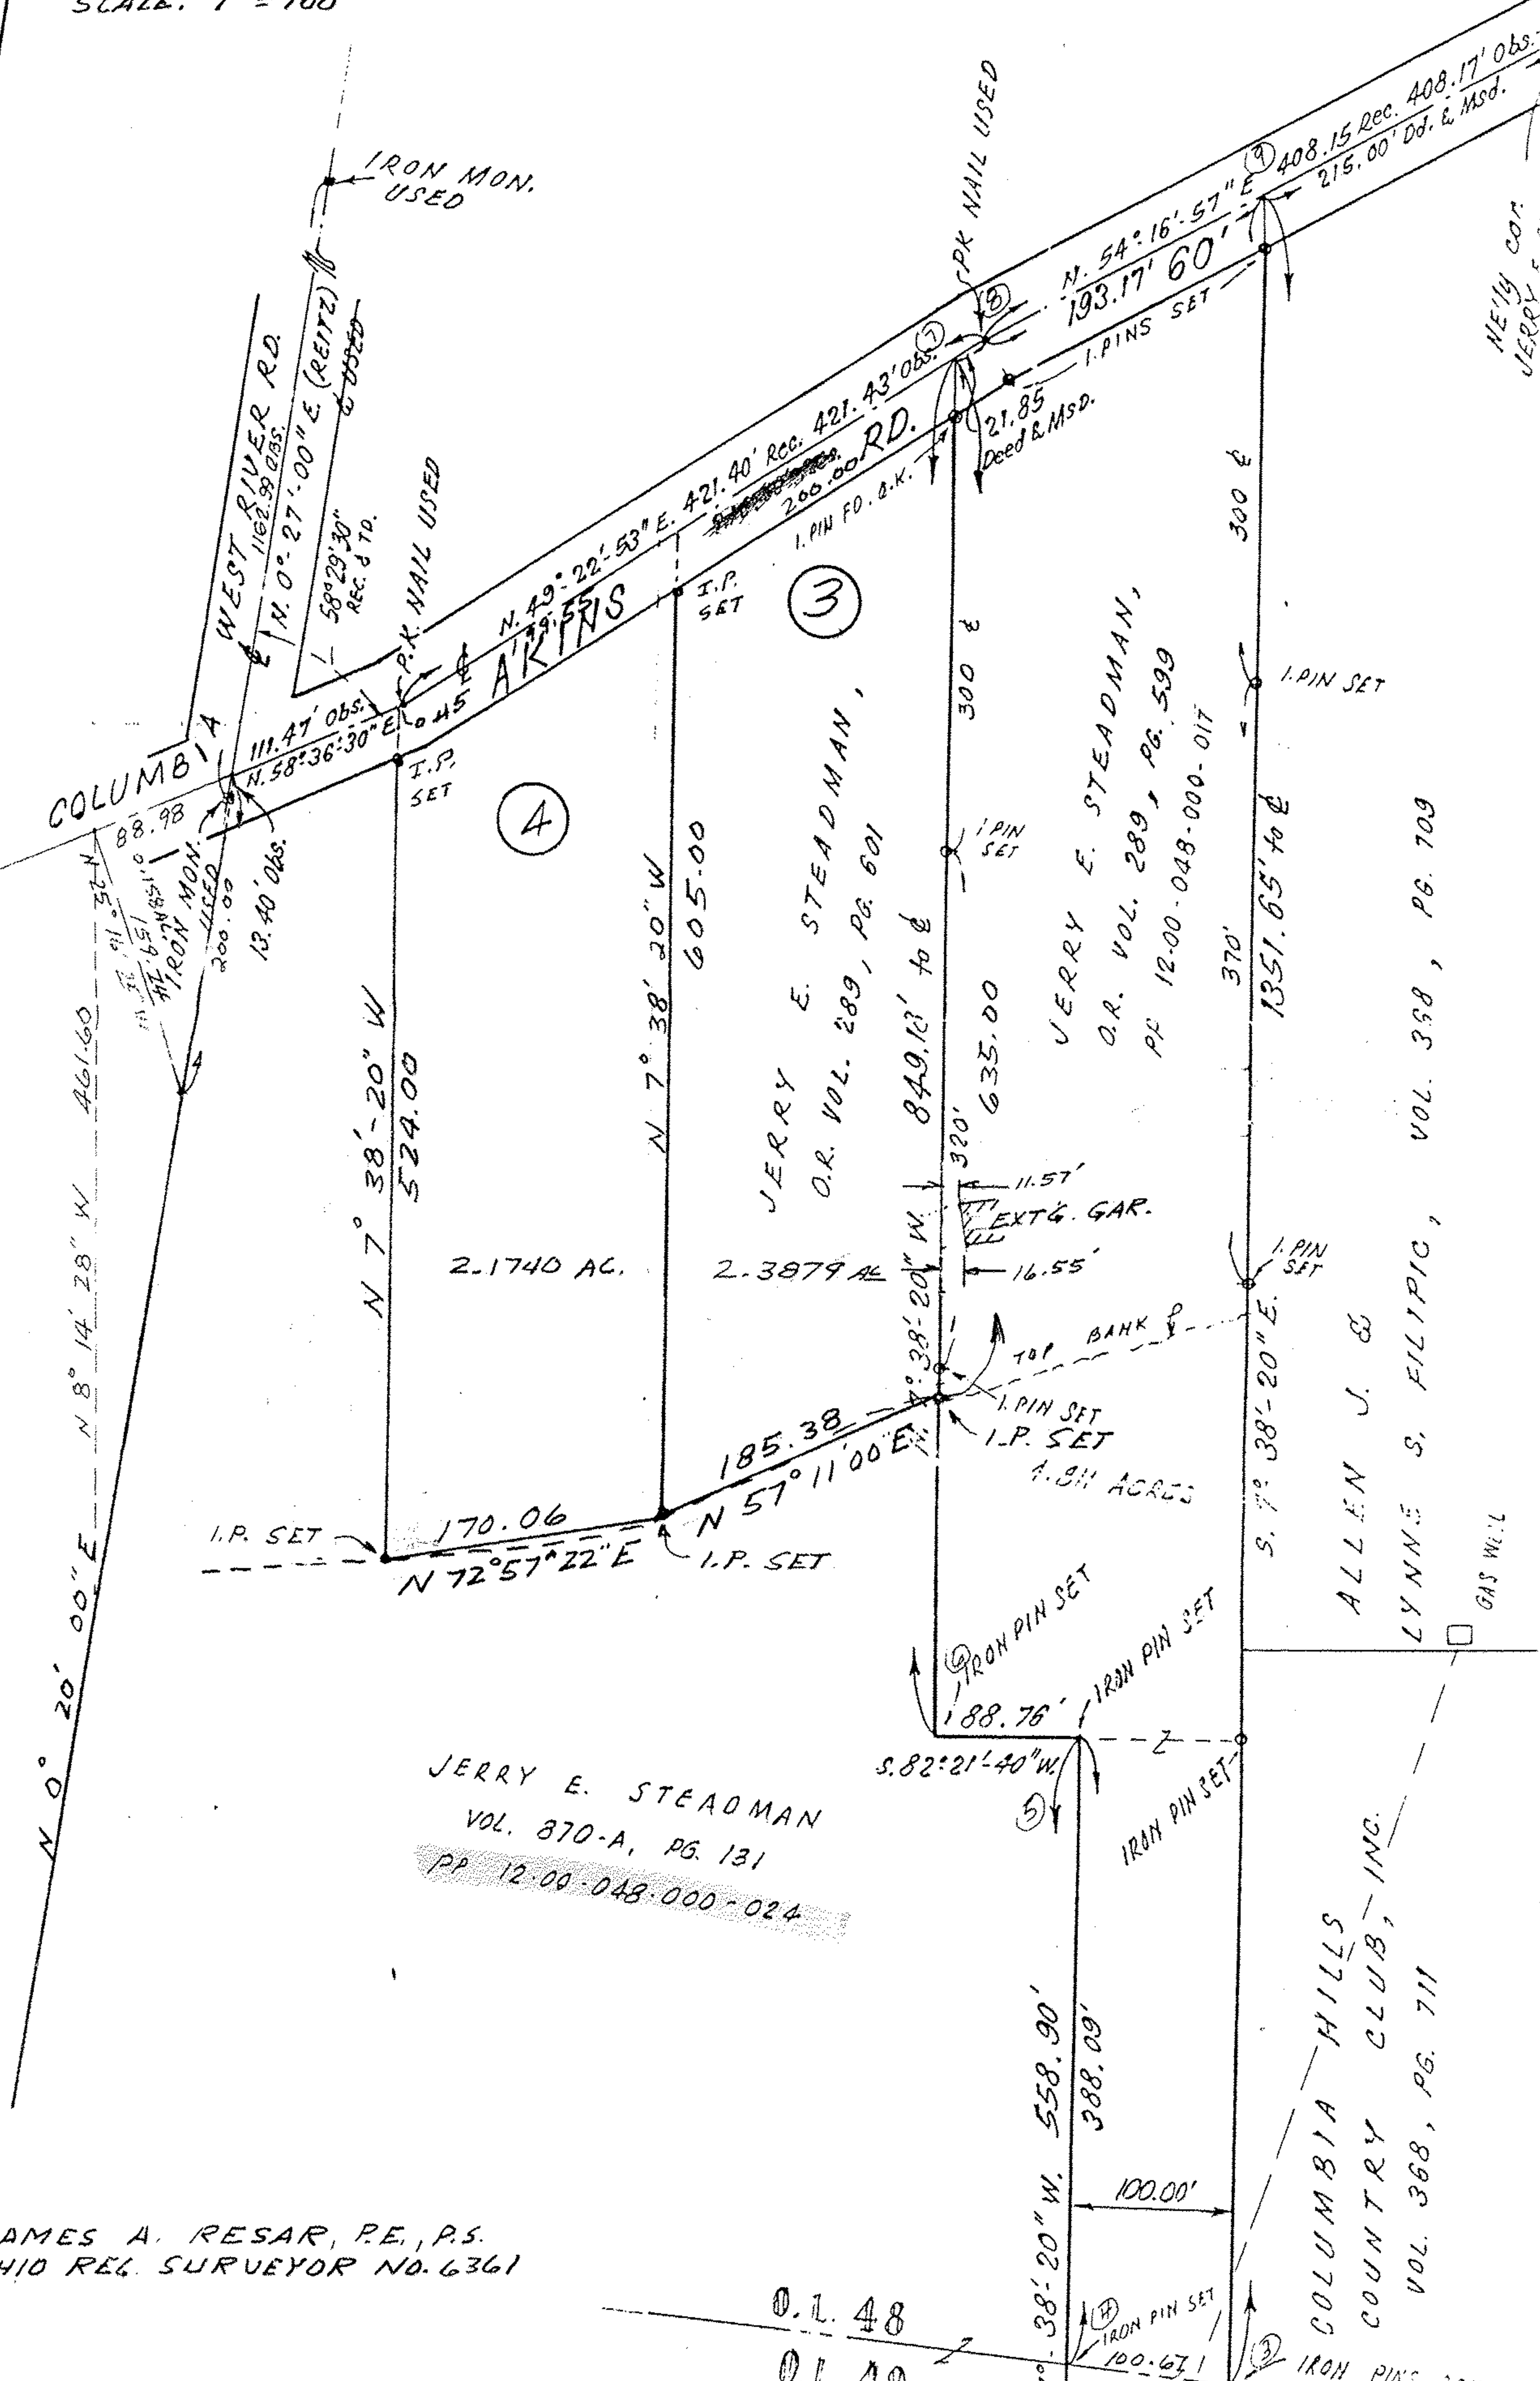

JAMES A. RESAR, P.E., P.S.
OHIO REG. SURVEYOR NO. 6361

0.1.48
0.1.40

COLUMBIA HILLS
COUNTRY CLUB, INC.
VOL. 368, PG. 711