


05-00-024-120-024

MAP PL: 5-00-024-B

Scan #47449


NORTH

SCALE
1" = 20'

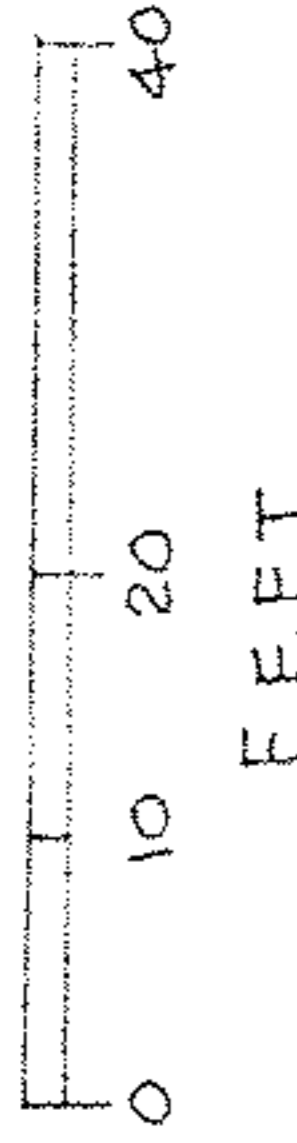

All iron rods and pipes found are 1" diam.

Columbia Gas Co. Inc.
V.868, P.691

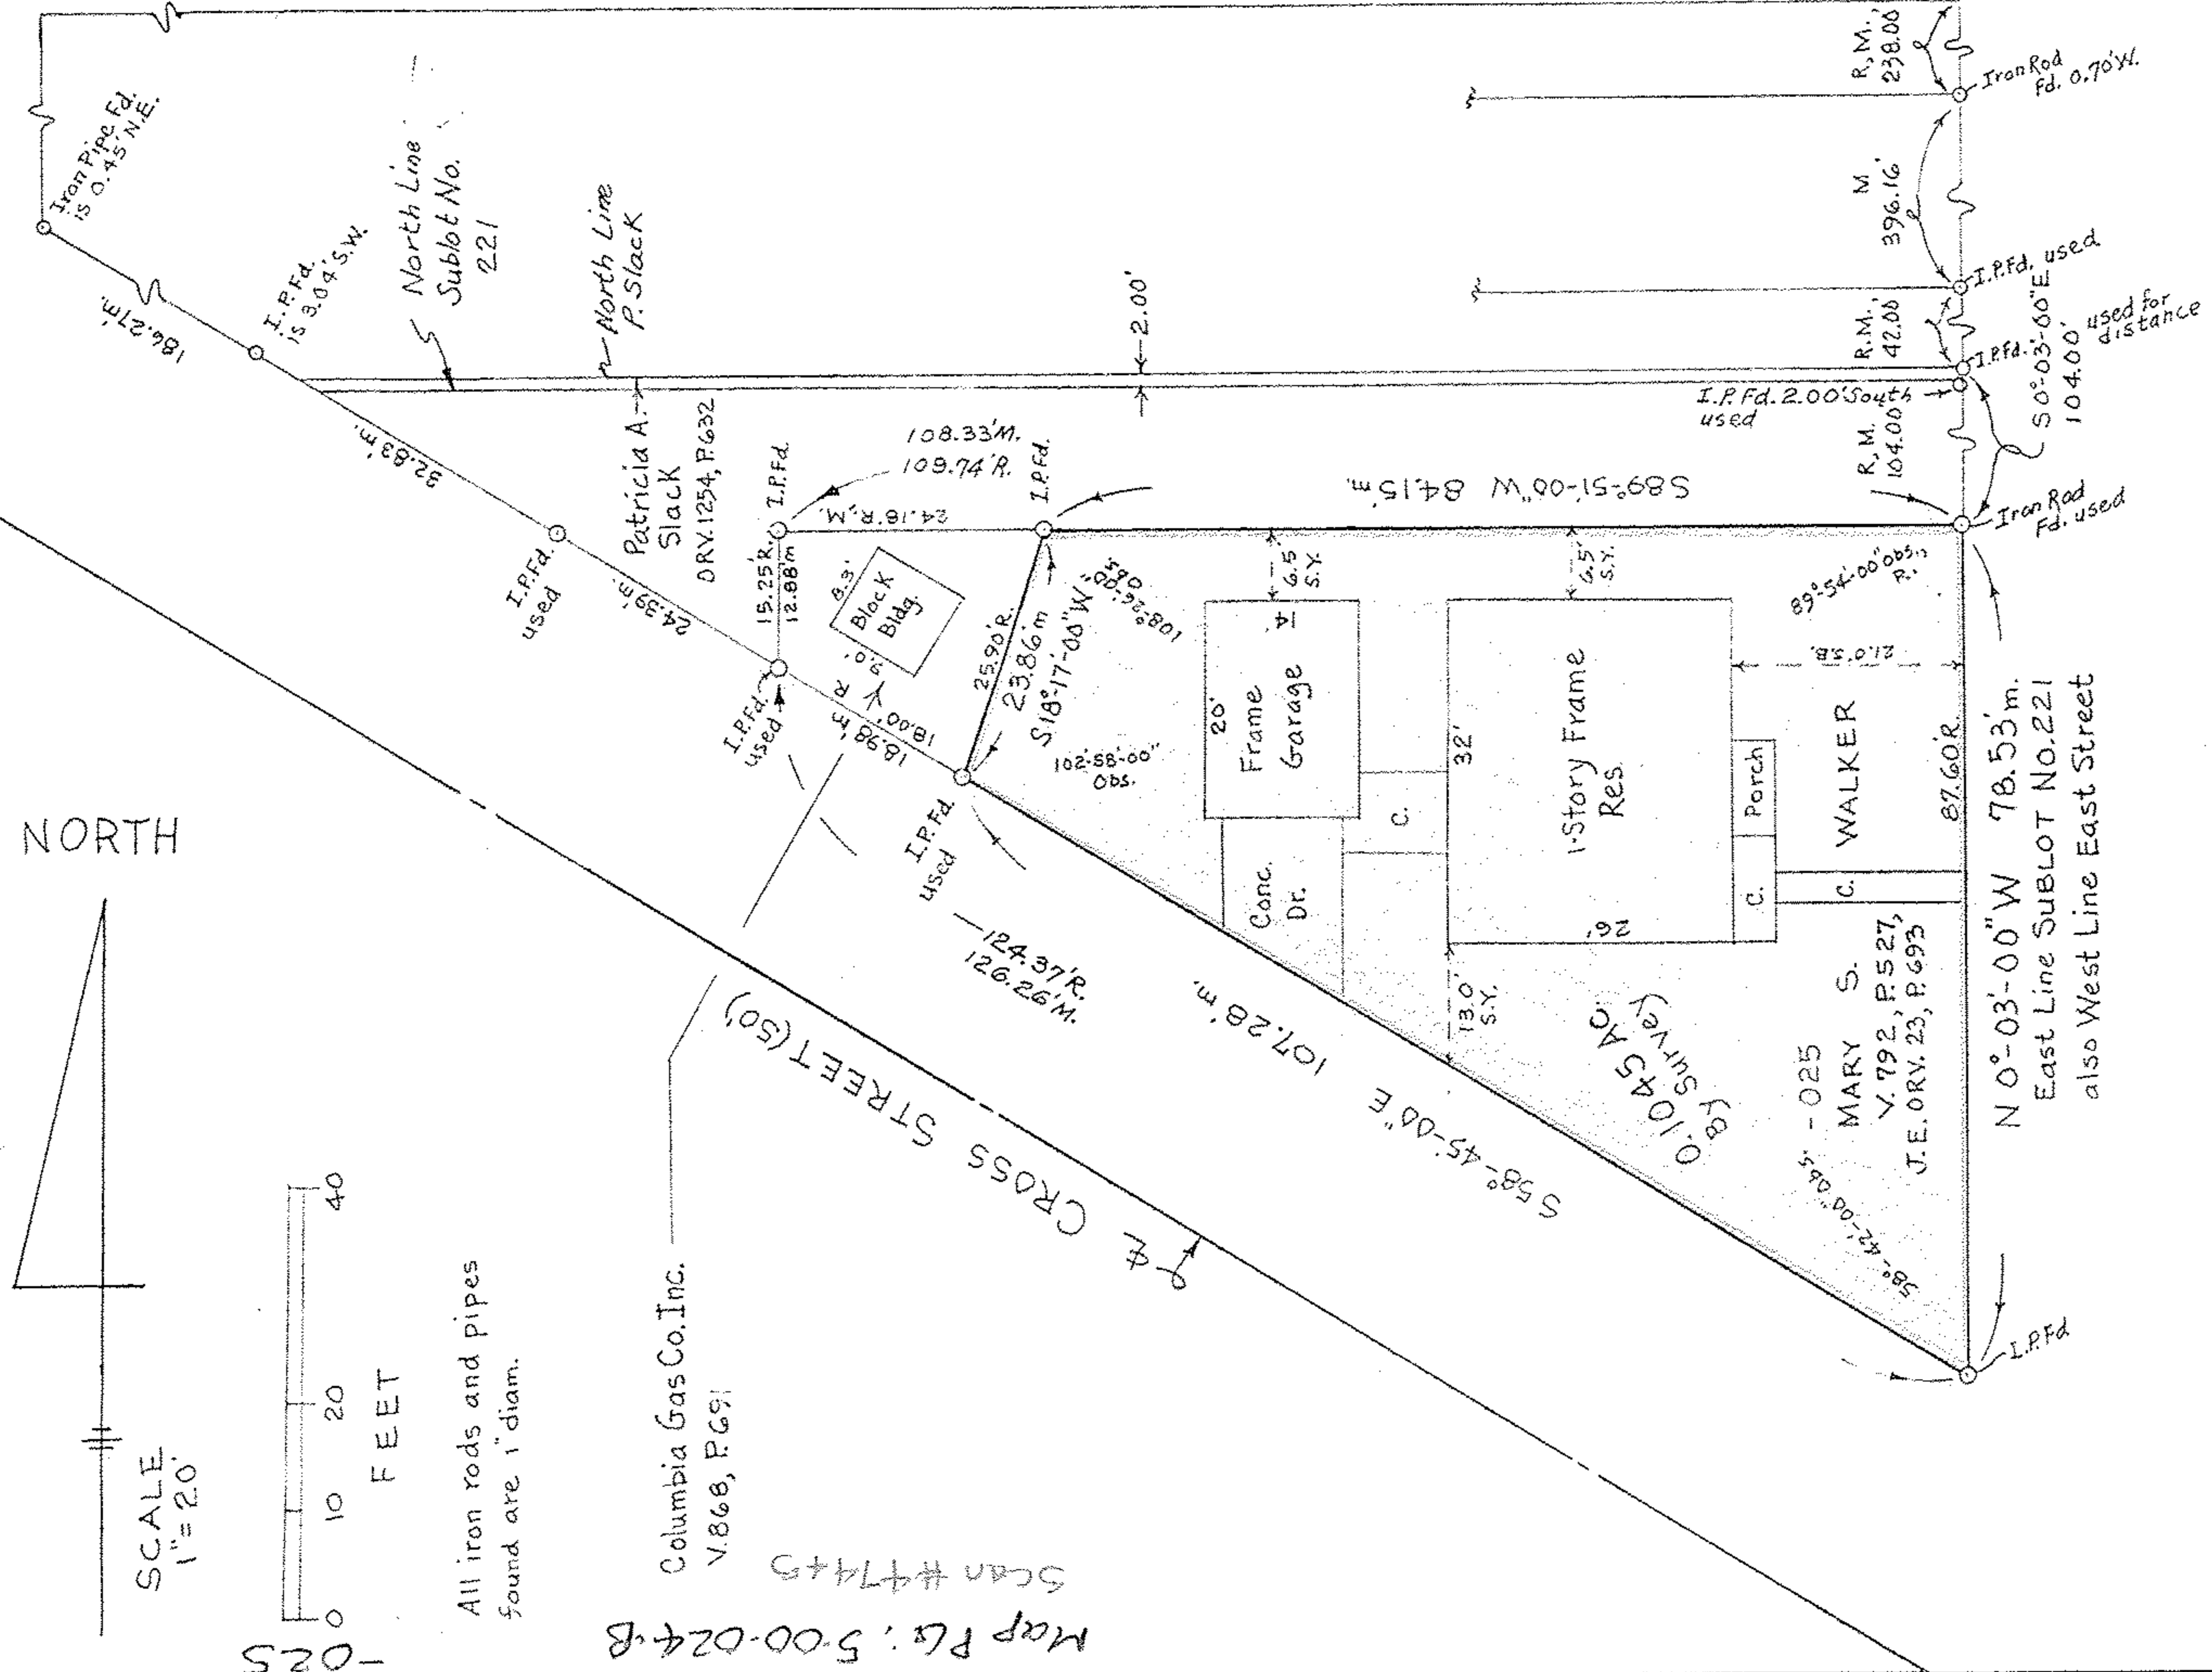

Prior Deed Reference:
D. Vol. 792, P. 527 and
Judgement Entry V. 23, P. 693

Perm. Par. No. 05-00-024-120-025

Charles P. Warkyu

CHARLES P. WARKYU, REGISTERED
SURVEYOR NO. 5029

Reference: Survey Map by C. E. Richards, Reg. Surveyor,
July, 1961, used.

JE EAST STREET (50')

MAP OF SURVEY MADE
PART OF SUBLT NO. 221, JOSIAH HARRIS
HEIRS ADDITION, PART OF ORIG. AMHERST
TWP. LOT NO. 24, PLAT VOLUME 2, PAGES 3,
AMHERST CITY, LORAIN CO., OHIO
for Mary S. Walker
November 1996.