



DIMENSIONS SHOWN ON THIS PLAT ARE EXPRESSED IN FEET AND DECIMAL PARTS THEREOF, ALL BEARINGS ARE TO AN ASSUMED MERIDIAN AND ARE USED TO INDICATE ANGLES ONLY. PERMANENT MONUMENTS WERE FOUND OR SET AT ALL POINTS INDICATED HEREON, ALL OF WHICH I CERTIFY TO BE CORRECT.

Thomas A. Simon
 THOMAS A. SIMON
 REG. PROFESSIONAL SURVEYOR
 NO. 9-7773

BASIS OF BEARINGS IS THE SOUTHEASTERLY RIGHT-OF-WAY LINE OF OVERLOOK DRIVE (NORTH 53°21'04" EAST). IRON PINS SET ARE 5/8" DIAMETER, 30" LONG WITH PLASTIC CAPS "T. SIMON, 9-7773".


APPROVED
 10-00-006-126-047
 5-15-13
 10-00-006-126-047
 R. MAINES
 #13-02730-D

10-00-006-126-047

PLAT OF BOUNDARY SURVEY
 FOR
 JAMES & BETHELENE SETSER

BEING KNOWN AS PART OF ORIGINAL
 CARLISLE TOWNSHIP SECTION NO. 6
 COUNTY OF LORAIN STATE OF OHIO
 MAY, 2013 SCALE: 1" = 60'

CURVE	RADIUS	TANGENT	LENGTH	DELTA	DEGREE	CHORD	CHL BEARING
C-1	1146.28'	203.78'	403.36'	20°09'41"	4°59'54"	401.28'	S 34°09'28"E
C-2	1146.28'	40.01'	60.00'	3°59'55"	4°59'54"	79.88'	N 22°04'40"W

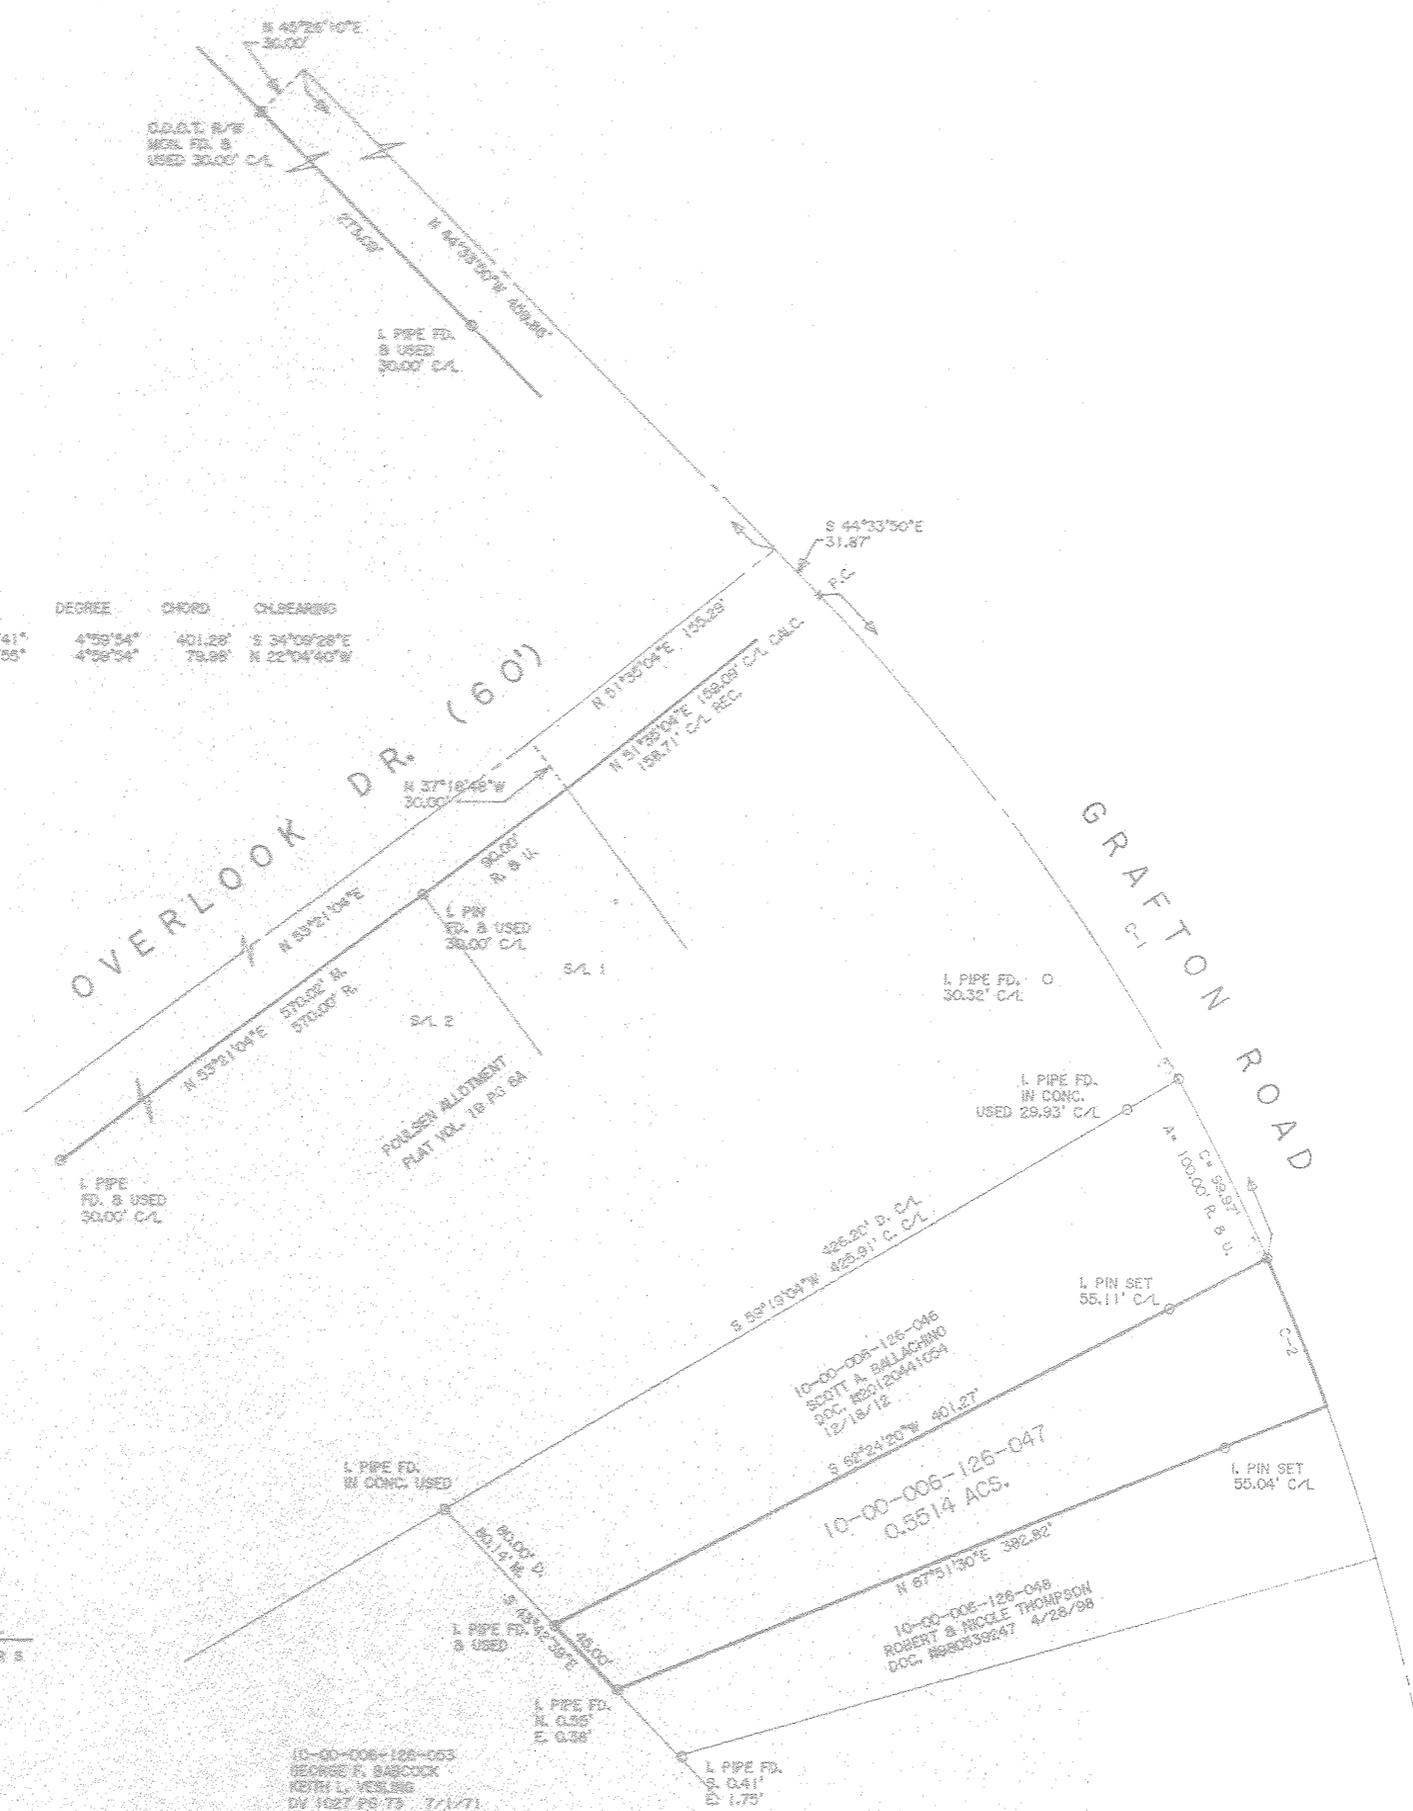

THOMAS SIMON & ASSOCIATES, INC.
 PROFESSIONAL LAND SURVEYORS

150 SOUTH OLIVE STREET
 ELYRIA, OHIO 44039

(440) 327-2925
 FAX 327-2964

10-00-006-126-055
 GEORGE F. BARCOCK
 KEVIN L. YESLING
 DV 1027 PS TS 7/1/71

10-00-006-126-046
 SCOTT A. BALLACHINO
 DOC. #20120441054
 12/18/12

10-00-006-126-047
 0.5514 ACS.

10-00-006-126-048
 ROBERT & NICOLE THOMPSON
 DOC. #880339247 4/28/98