


Scale 1" = 80'
May 25, 2013

Note: Bearings shown are to an assumed Meridian and are used to describe angles only.

Being known as Part of Original Lot 6, Fract 2 of Black River Township, Now in the City of Lorain, County of Lorain and the State of Ohio.

- POINTS DESCR
- 1
- 2
- 3
- 4
- 5
- 7
- 8
- 9
- 11
- 12
- 59 DRILL HOLE SET
- 44 IRON P.I.N. FOUND
- 45 IRON P.I.N. FOUND
- 46 IRON P.I.N. FOUND
- 47 IRON P.I.N. FOUND
- 48 IRON P.I.N. FOUND
- 60 REBAR SET
- 61 REBAR SET
- 62 REBAR SET
- 50 Point
- 52 Point
- 54 Point
- 55 Point
- 56 Point
- 57 Point
- 58 Point

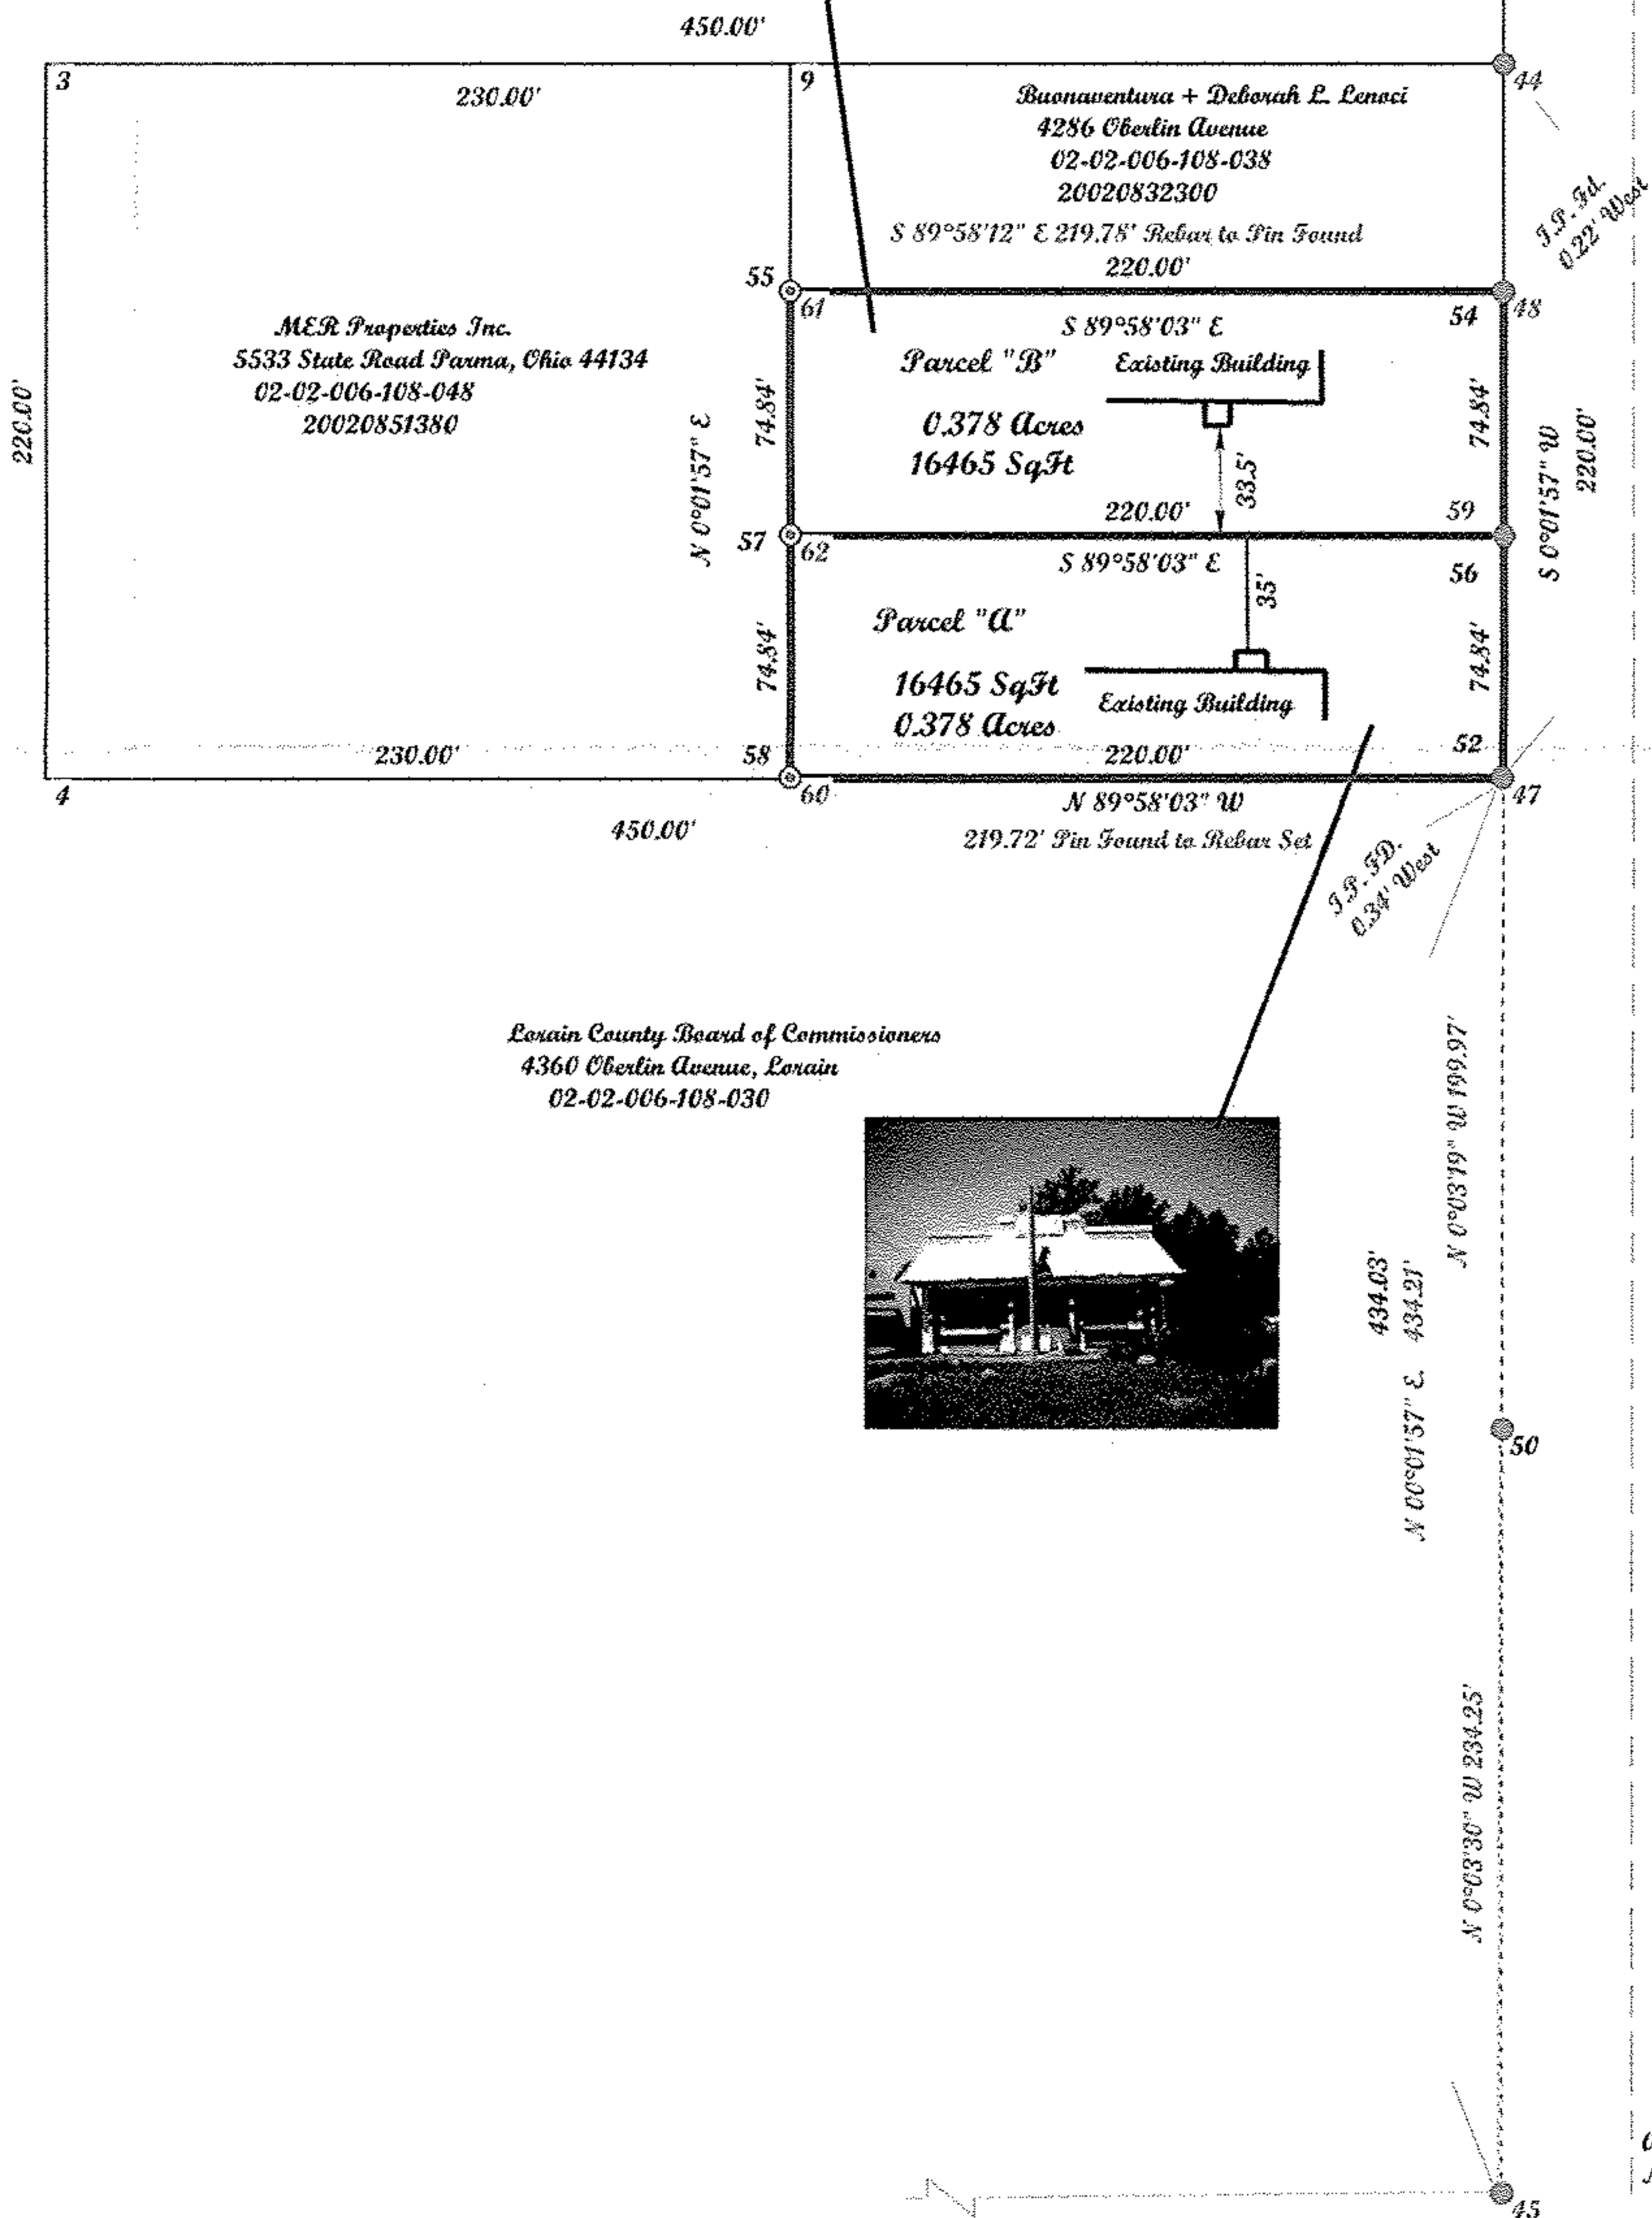

LEGEND	
⊙	Rebar Set
●	IRON P.I.N. FOUND
⊙	Drill Hole Set

02-02-006-108-052
053
SCAN # 47513

Note: Only copies signed with Red ink shall be considered Valid.
Patrick A. McGannon
Patrick A. McGannon P.S. 7154

APPROVED BY THE LORAIN CITY PLANNING COMMISSION... NO PLAN REQUIRED
Shelby
SECRETARY LORAIN CITY PLANNING COMMISSION

23169 1

APPROVED
LORAIN CO.
MAY 29 2013

DATE 7-29-13

PAGE 02-02-006-B

BY J. Hatfield
#13-03169

APPROVED
AS TO DESCRIPTION ONLY
Date 7/29/13
City of Lorain
Per *Patrick A. McGannon*
Engineering Dept.



Note: Dimensions shown in Blue are record values and those shown in red are field observed values.
KJGLESJRU S.N.

McGannon Surveying, LLC
Boundary Survey
Patrick A. McGannon
Registered Professional Surveyor
1731 Gettysburg Drive, Lorain, Ohio 44053 (440) 282-2712
www.mcannonssurveying.com

Prepared for: Room Alfala Realty, Inc. of
4450 Oberlin Avenue, Lorain, Ohio 44053.