

SURVEY OF PART OF ORIGINAL EATON TWP. LOT 8 COUNTY OF LORAIN STATE OF OHIO

JOACHIM P. KIESEL INST. 1994-0271414

EDWARD SYALASZEWSKI INST. 2002-0845666

S 89° 01' 26" E 1449.33 ± CALC 1449.26 ± REC.

COMBINATION OF 11-00-008-000-065 ± -066 = 10.759 AC.


N 88° 26' 57" W 1455.55 ± CALC 1455.50 ± REC.

GILBERT F. STARR INST. 2012-0421981

ROGER ARLEN WINTERS INST. 2007-0195590

PREPARED BY: BARBOSA & ASSOC. LLC. 5604 CASE RD. N. RIDGEVILLE, OH 44039 440 327 4776

11-00-008-000-069
APPROVED
LOCAL GOV.
MAY 1ST
DATE 9-10-13
PAGE 11-00-008-B
BY R. MAINES
#13-02794-C

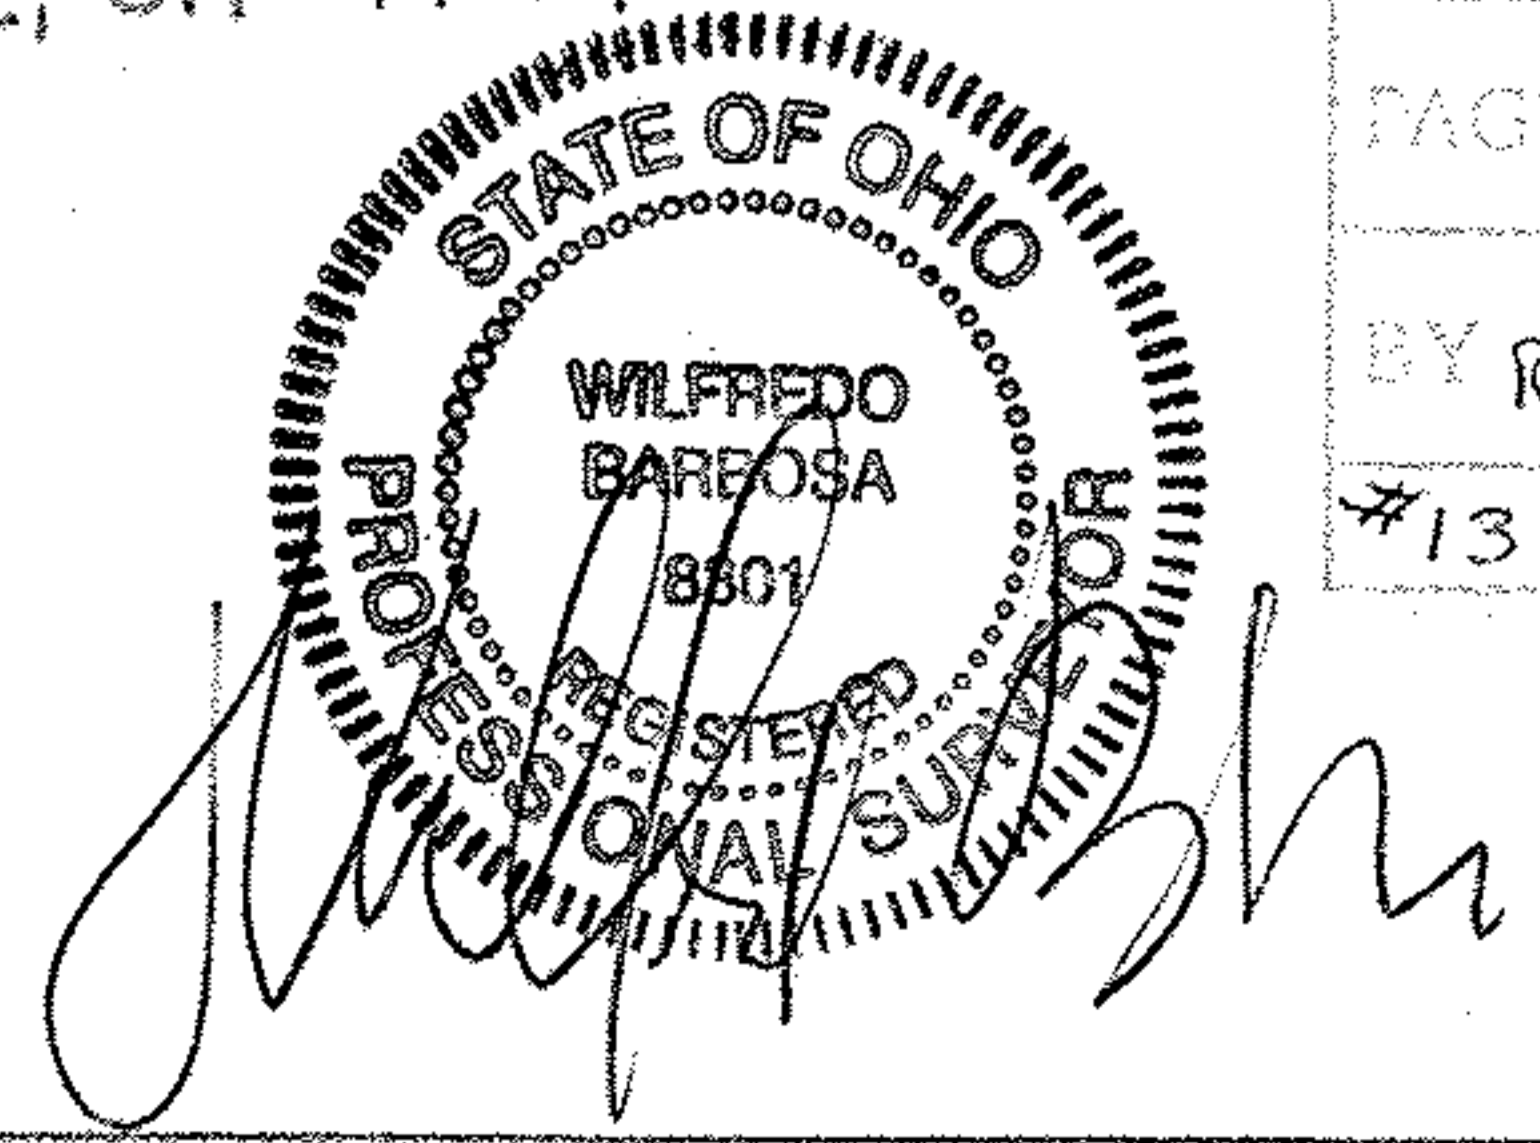

DATE: AUG, 2013
SCALE: 1" = 100'



SHIRLEY A. HONELL INST. 1996-088617

315.40' R 90°
41° 33' 21" E
382.80' R 90°

100.17 OBS
100.00 R.
180.00 R 90°
330.00 R 90°
732.80' CALC.
HAWKE RD. 60'

PIPE FND. & U. FOR LINE 2.60' SOUTH

PIPE FND

PIPE FND & U.

I.P. SET

I.P. SET

I.P. SET

PIPE FND & USED

PIPE FND & USED

COOLEY ROAD 60'

I.P. FND.