

Plat of Survey & Combination

Bob & Linda Cassese


Grafton Twp. (T4N, R16W)
Lorain Co.

O.L. 41
Ohio

Carlson Surveys

September 2013

Job: 1602-06F

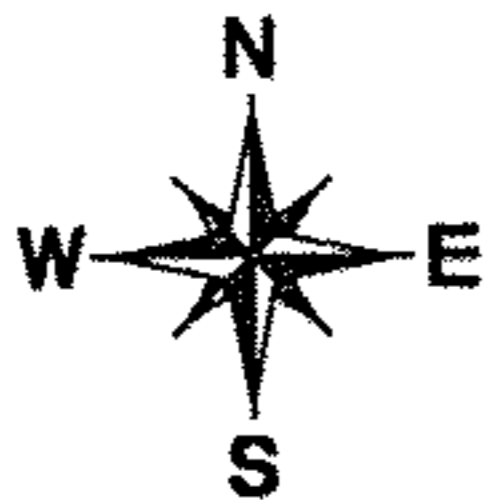

16-00-041-000-040

SCAN # 47583


Buckingham Allot.

V. 17 P. 18

O.L. 39


O.L. 41

Chamberlain Rd. 60'

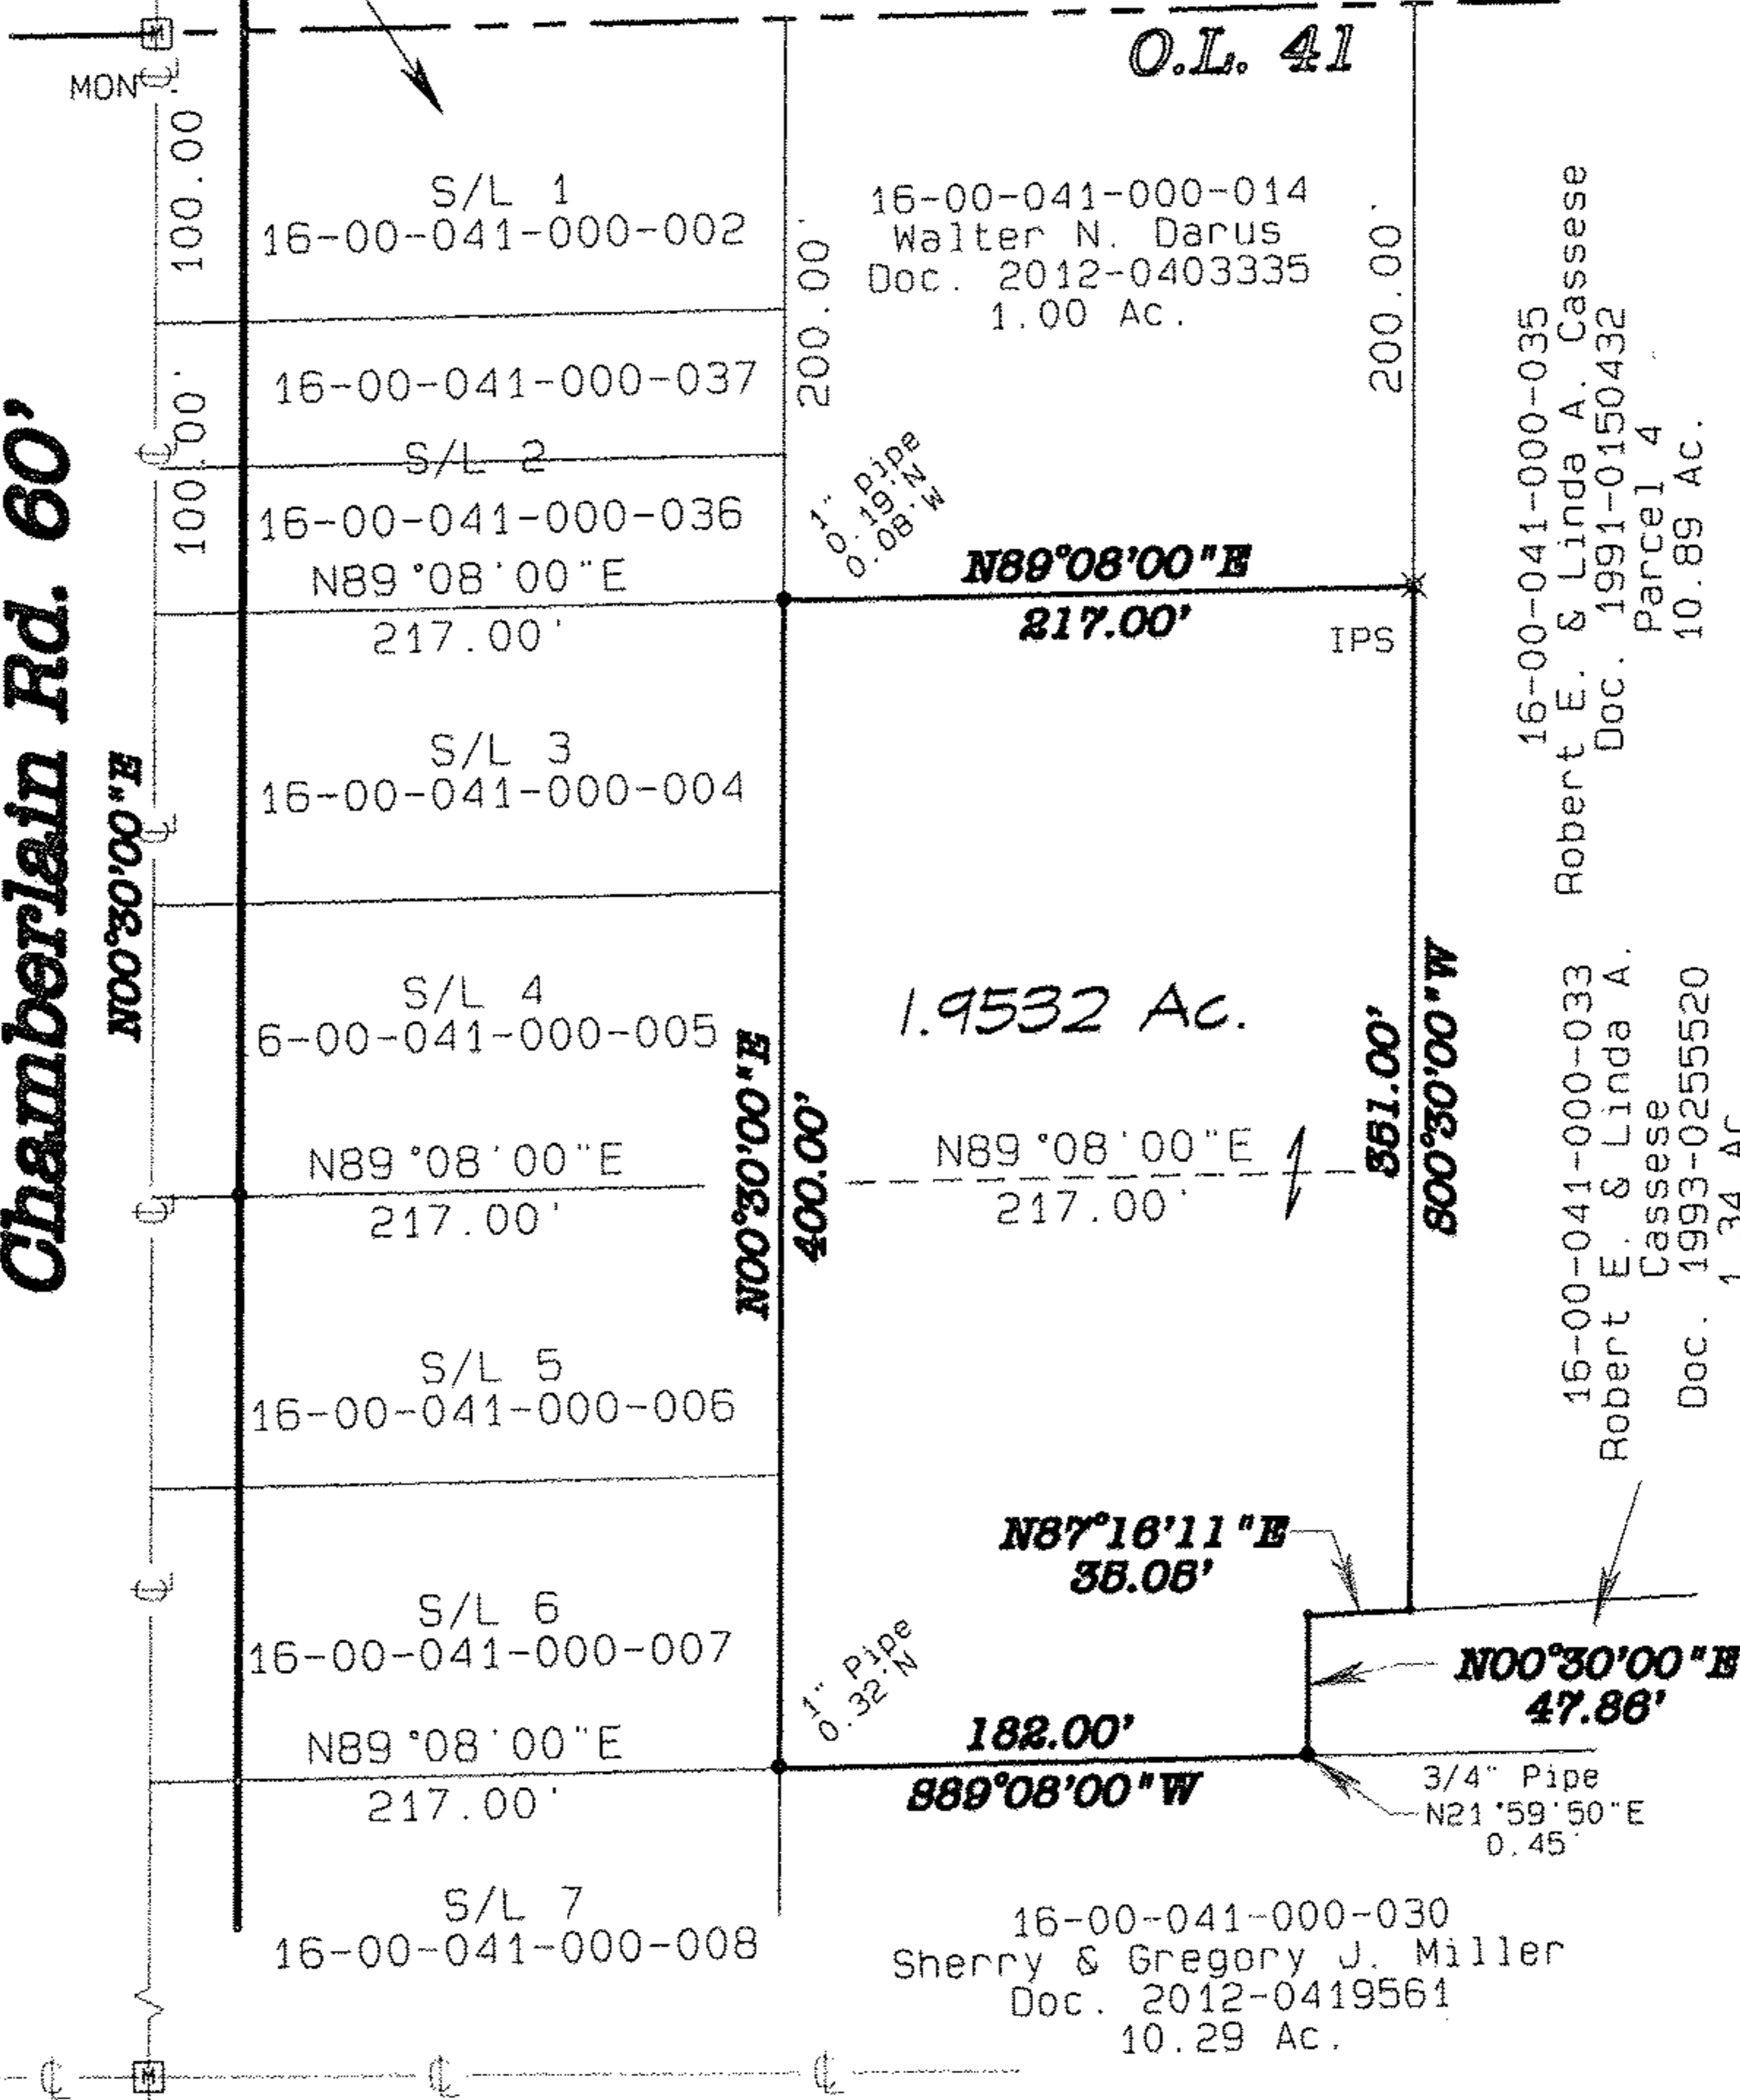

03198

S.R. 303

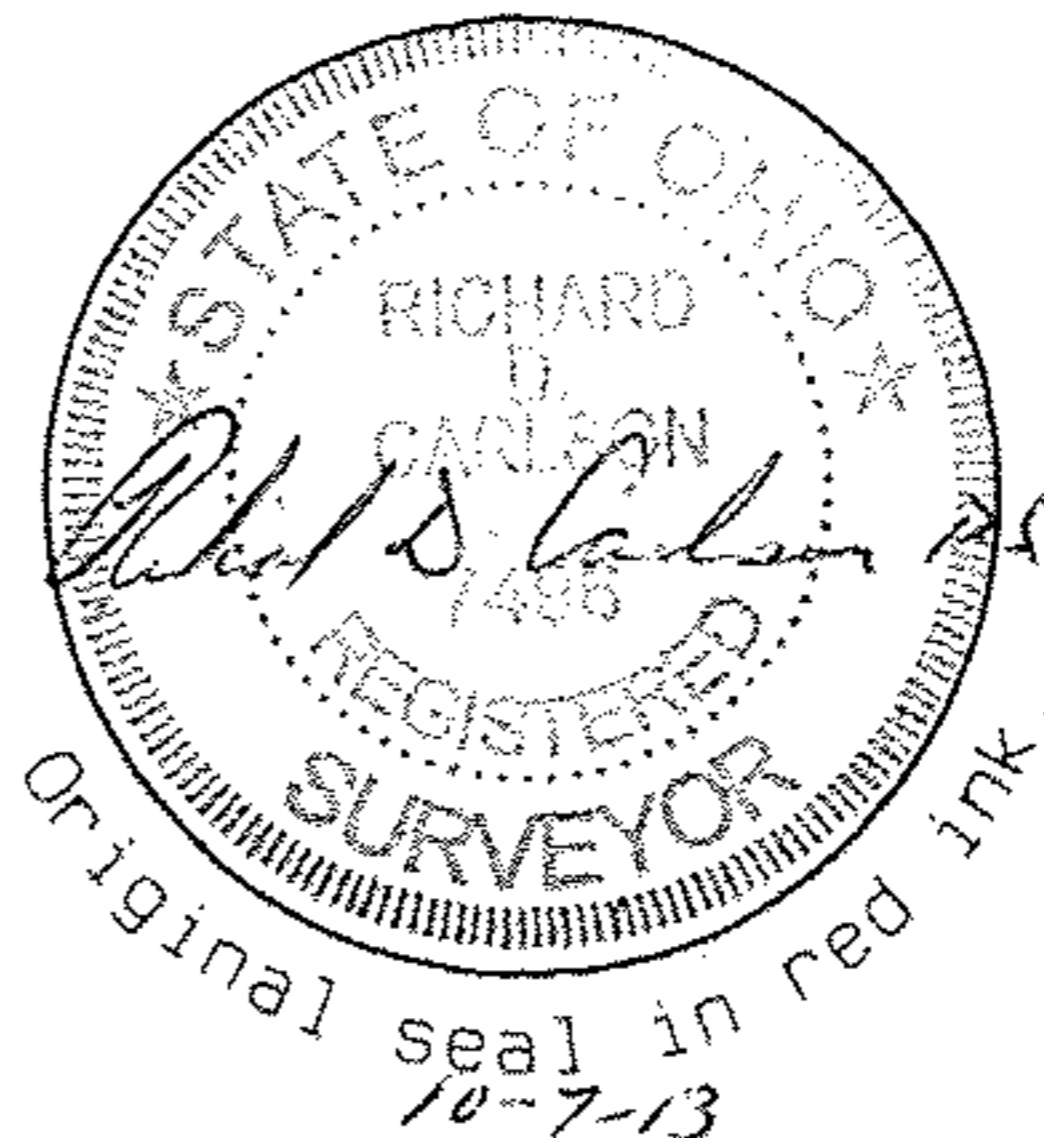

APPROVED LORAIN CO. MANAGER
DATE 10-30-13
PAGE 16-A
BY JHATFIELD
#13-03198

GRAPHIC SCALE

1"=100'

