

BOUNDARY SURVEY MAP

LORAIN METROPOLITAN HOUSING AUTHORITY

SITUATED IN THE CITY OF OBERLIN, COUNTY OF LORAIN, STATE OF OHIO, AND KNOWN AS BEING A PART OF ORIGINAL RUSSIA TOWNSHIP LOT NUMBER 86.

CHRISTOPHER J. DEMPSEY
PROFESSIONAL SURVEYOR NO. 6914
DATE OF SURVEY: JANUARY 27, 2012

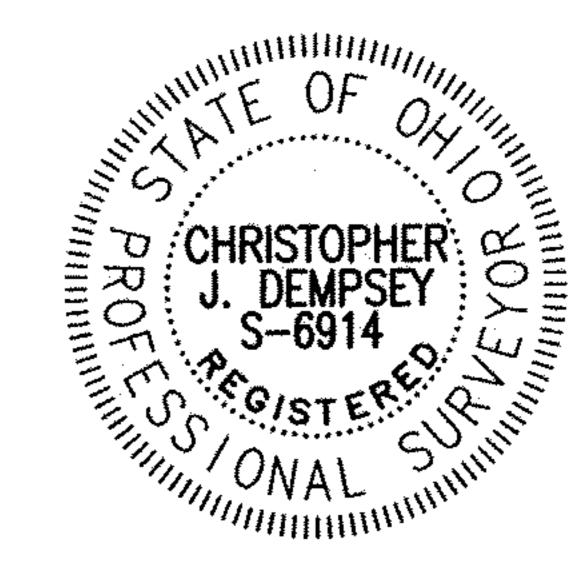

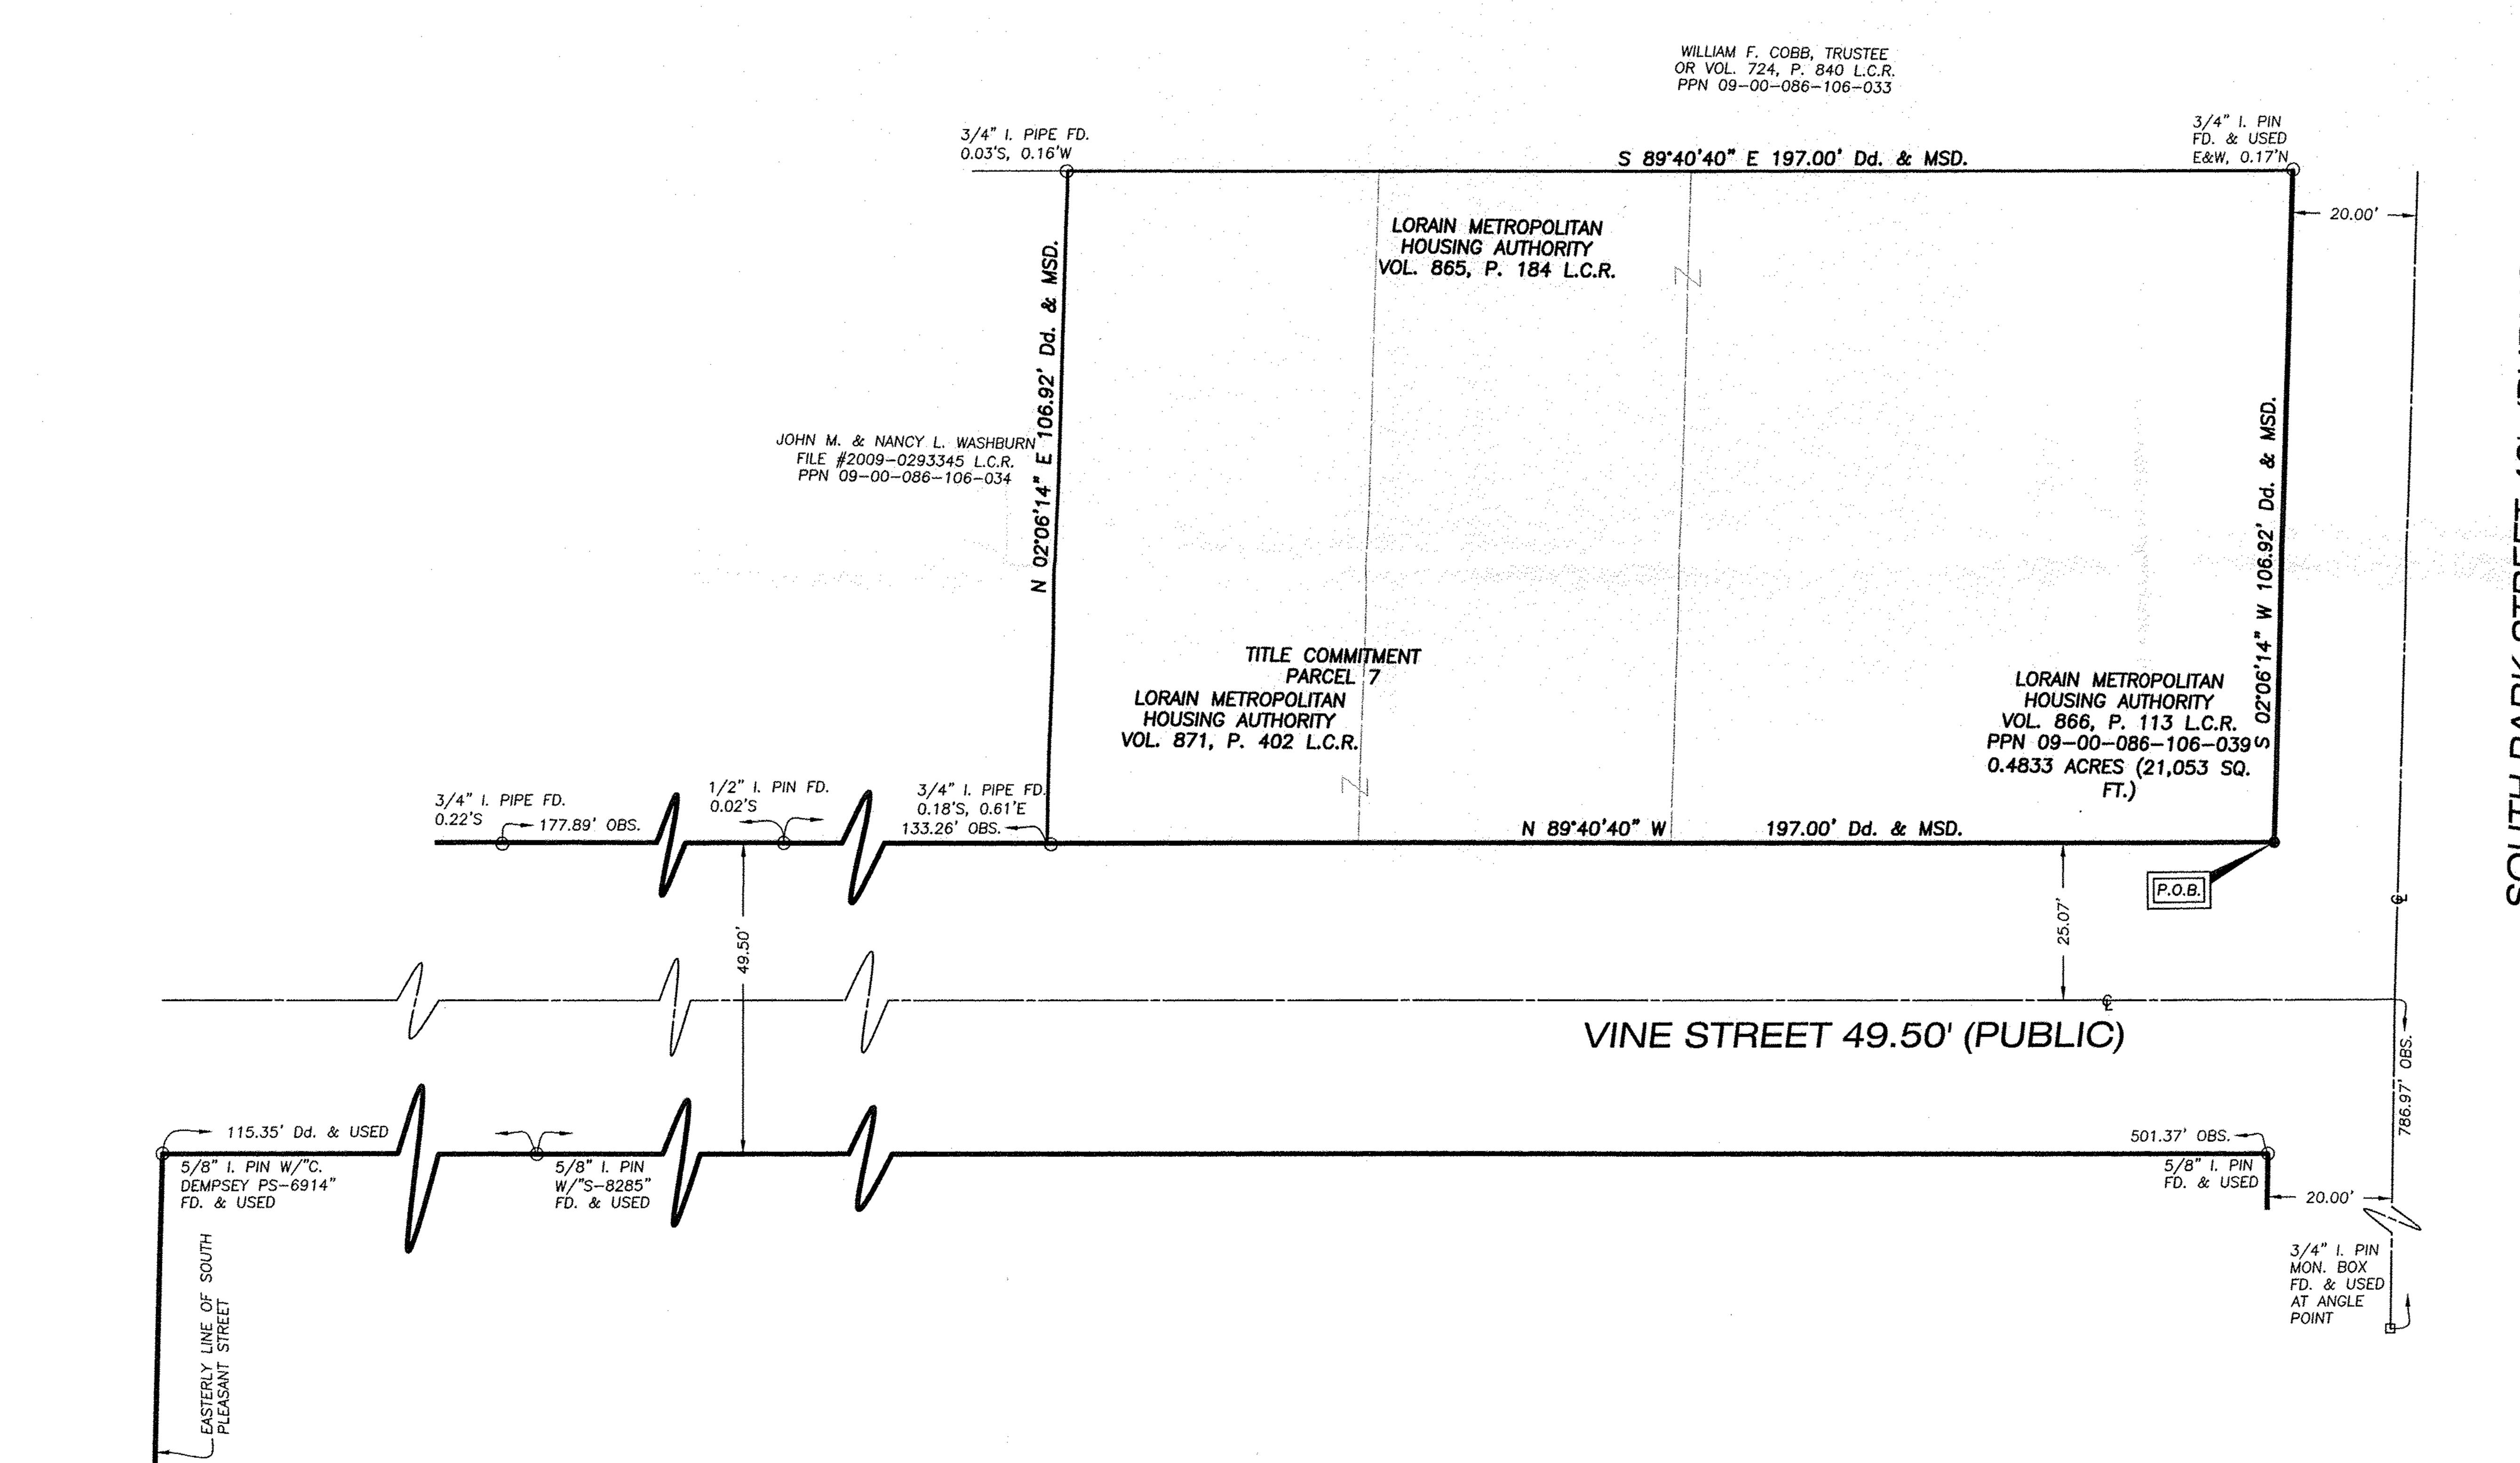

BEGINNING AT A 5/8 INCH IRON PIN SET AT THE INTERSECTION OF THE NORTH LINE OF VINE STREET (49.50 FEET WIDE) AND THE WEST LINE OF SOUTH PARK STREET, FORMERLY KNOWN AS SOUTH WATER STREET, (40 FEET WIDE), SAID POINT BEING THE PRINCIPAL PLACE OF BEGINNING OF THE PARCEL DESCRIBED HEREIN;

COURSE 2. THENCE NORTH 02 DEGREES 06 MINUTES 14 SECONDS EAST, A DISTANCE OF 106.92 FEET TO A POINT WITNESSED

COURSE 1. THENCE ALONG THE NORTH LINE OF VINE STREET, NORTH 89 DEGREES 40 MINUTES 40 SECONDS WEST, A

DISTANCE OF 197.00 FEET TO A POINT WITNESSED BY A 3/4 INCH IRON PIPE FOUND 0.18 FEET SOUTH, 0.61 FEET EAST THEREFROM;

PINS SET ARE 30" LONG. 5/8" DIAMETER REBAR WITH A YELLOW CAP STAMPED "DEMPSEY 6914."

BY A 3/4 INCH IRON PIPE FOUND 0.03 FEET SOUTH, 0.16 FEET WEST THEREFROM;

3/4 INCH IRON PIN FOUND 0.17 FEET NORTH THEREFROM;

BASIS OF BEARINGS: BI ZONE, NAD 83 DATUM.

