



Scale 1" = 30'
10-16-2013

Note: Bearings shown are to an assumed Meridian and are used to describe angles only.

Being known as Part of Sublot 57 of the Greefield Estates Subdivision in the City of Elyria, County of Lorain and the State of Ohio.

03211



APPROVED
LOT IN CO.
M. EPT

DATE 12-18-13

PAGE 6-1

BY J. Hatfield

#15-03211

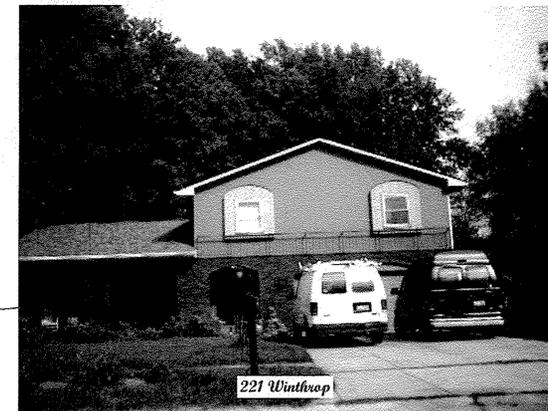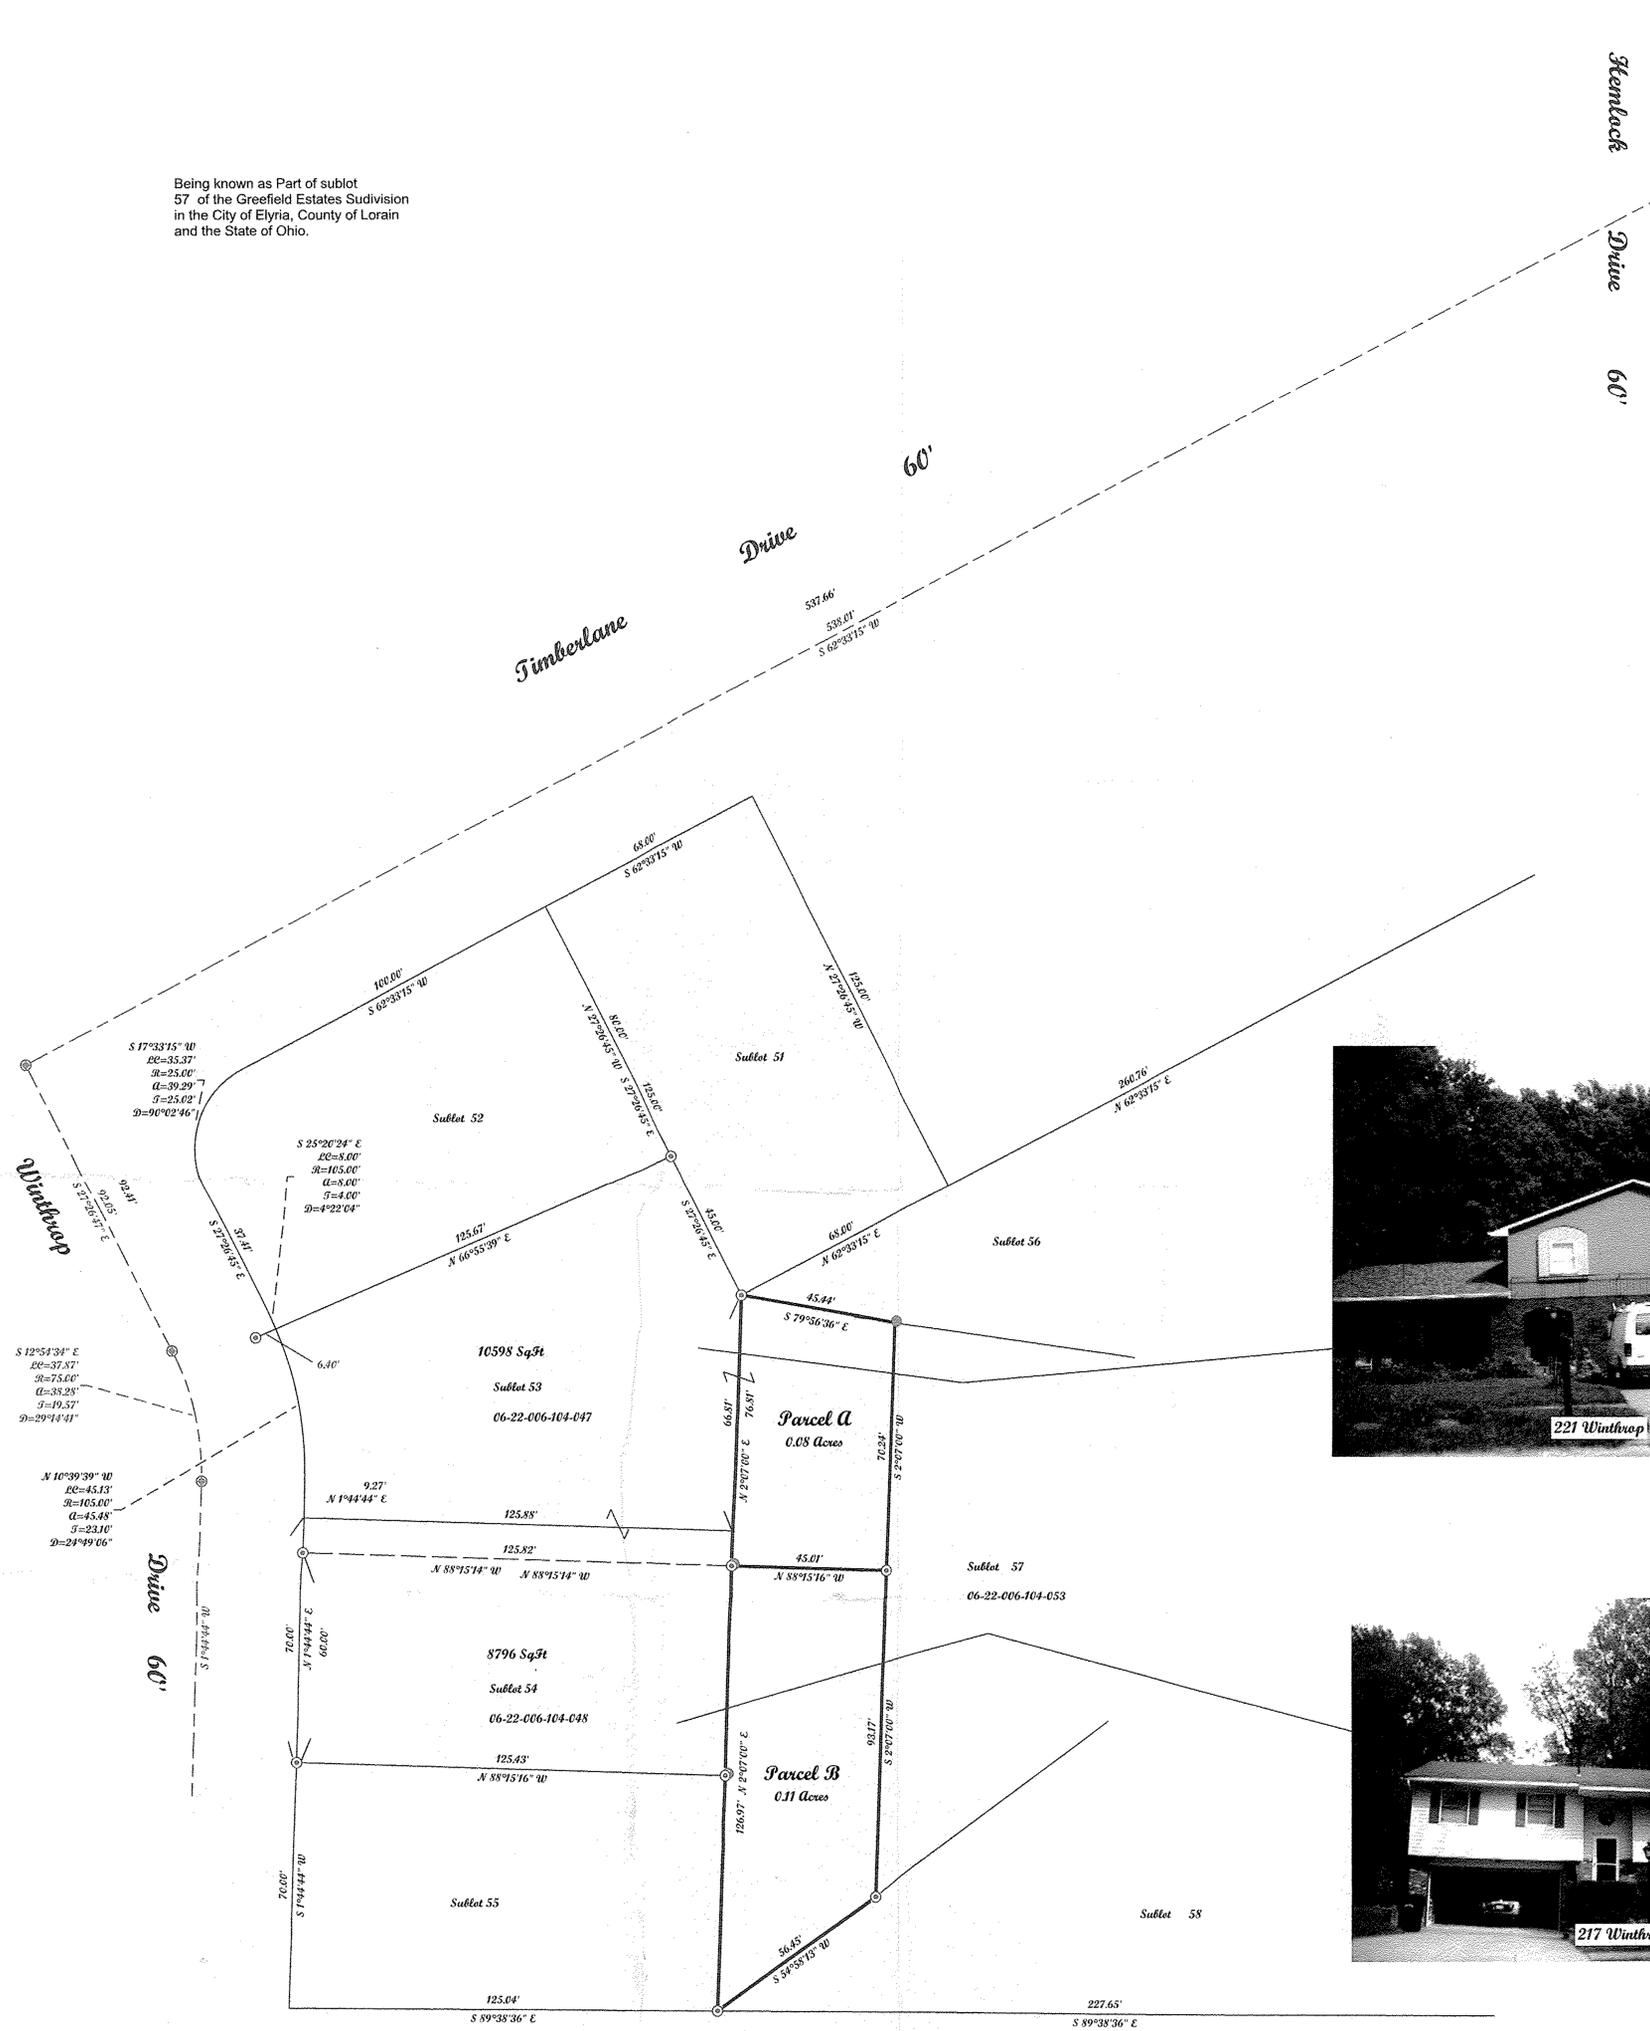

APPROVED BY PLANNING COMMISSION
CITY OF ELYRIA, OH
NO PLAT REQUIRED DATE
Philip M. Laska 12/17/13

LEGEND	
⊙	Rebar Set
⊙	Iron Pin Found in a Monument Box
⊙	IRON PIN FOUND

Note: Only copies signed with Red ink shall be considered Valid.

Patrick A. McGannon
Patrick A. McGannon P.S. 7154

Prepared for Janet J. Hazlett of
221 Winthrop Drive, and Chad M. Dubosa and
Marisa Flores of 217 Winthrop Drive Elyria,
Ohio 44035.



Note: Dimensions shown in Blue are record values and those shown in red are field observed values.

HAZLETT, SRV J.N. SJCB

McGannon Surveying, LLC
Boundary Survey
Patrick A. McGannon
Registered Professional Surveyor
1731 Gettysburg Drive, Lorain, Ohio 44053 (440) 282-2712
www.mcannonssurveying.com