


MAP OF SURVEY

PREPARED FOR: LAWYERS TITLE
 PERM. PCL. NO.: 10-00-015-108-067 AND 068
 STREET ADDRESS: 35 LAKEVIEW DRIVE
 PARTS OF S/L: 124 & 125 IN: BRENTWOOD ALLOTMENT NO.2
 PART OF: ORIGINAL CARLISLE TOWNSHIP SECTION NO.15
 VOL.: 16 PG.: 11
 CITY OF: GARFIELD HEIGHTS
 COUNTY OF: CUYAHOGA STATE OF: OHIO
 DATE: NOVEMBER 6, 2013 SCALE: 1" = 50'
 JOB #: 5455



SCALE: 1"=50'
 DATE OF SURVEY OCTOBER 28, 2013

SPITZER HARDWARE & SUPPLY CO.
 P.P.N.10-00-015-108-066
 V.484 P.124 L.C.D.R.

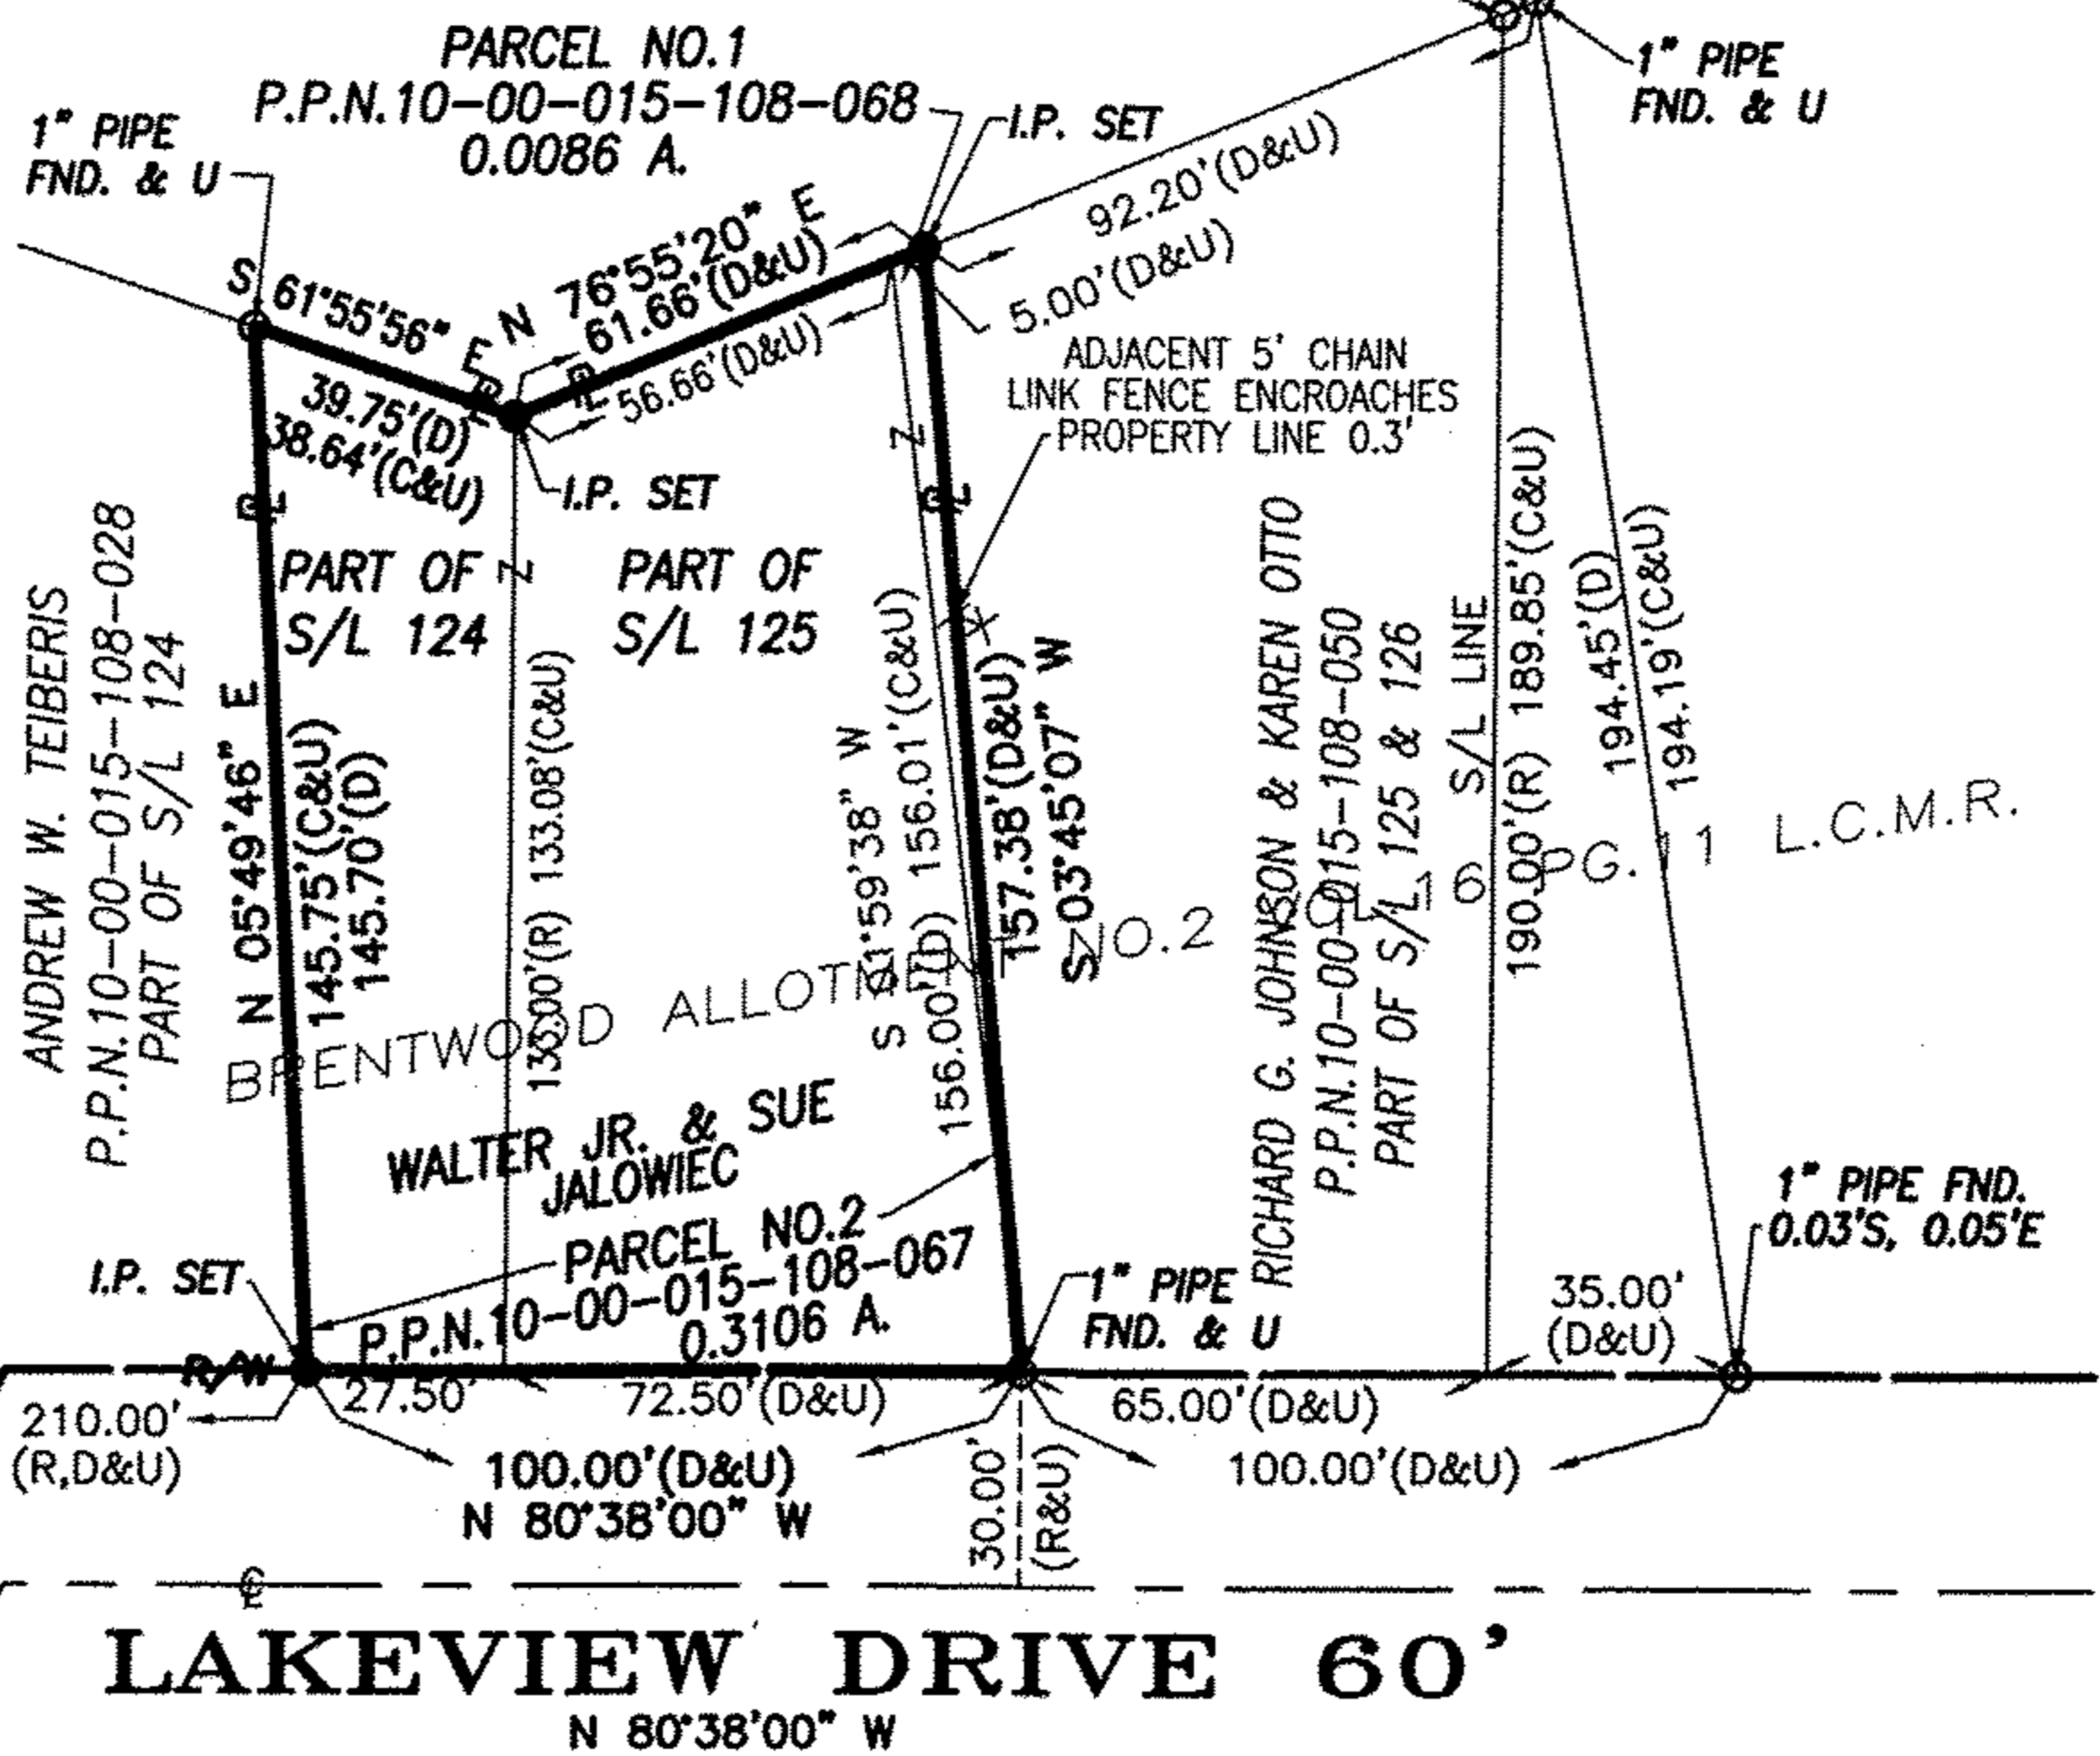

*BASIS OF BEARINGS IS THE CENTERLINE OF LAKEVIEW DRIVE AS N 80°38'00" W AS SHOWN ON THE SUBDIVISION PLAT FOR BRENTWOOD ALLOTMENT NO.2 VOL.16 PG.11 OF L.C.M.R.

APPROVED
 LORAIN CO. MAP # 11-20-13
 DATE 11-20-13
 PAGE 10-00-015-D
 BY R. MAWES
 #12-02850-D

LEGEND	
○ = IRON PIN FOUND	PL = PROPERTY LINE
● I.P. SET = 5/8" DIA. IRON PIN 30" LONG WITH CAP#7344	R = RECORDED
⊗ D.H. = DRILL HOLE	D = DEED
◇ = MONUMENT FOUND	U = USED
R/W = RIGHT-OF-WAY	L.C.D.R. = LORAIN COUNTY DEED RECORDS
Ⓢ = CENTERLINE	L.C.M.R. = LORAIN COUNTY MAP RECORDS
MON = MONUMENT	*- = FENCE
FND. = FOUND	
OBS. = OBSERVED	

MACKAY
 Engineering & Surveying Company
 7017 Pearl Road, Cleveland, Ohio 44130
 (440)886-4500 / (440)886-4590 Fax



DISTANCES ARE EXPRESSED IN FEET AND DECIMAL PARTS THEREOF, MONUMENTS WERE FOUND OR SET AS INDICATED HEREON. ALL OF WHICH I CERTIFY TO BE CORRECT.

Michael Mackay 11/7/13
 REGISTERED OHIO SURVEYOR NO. 7344