
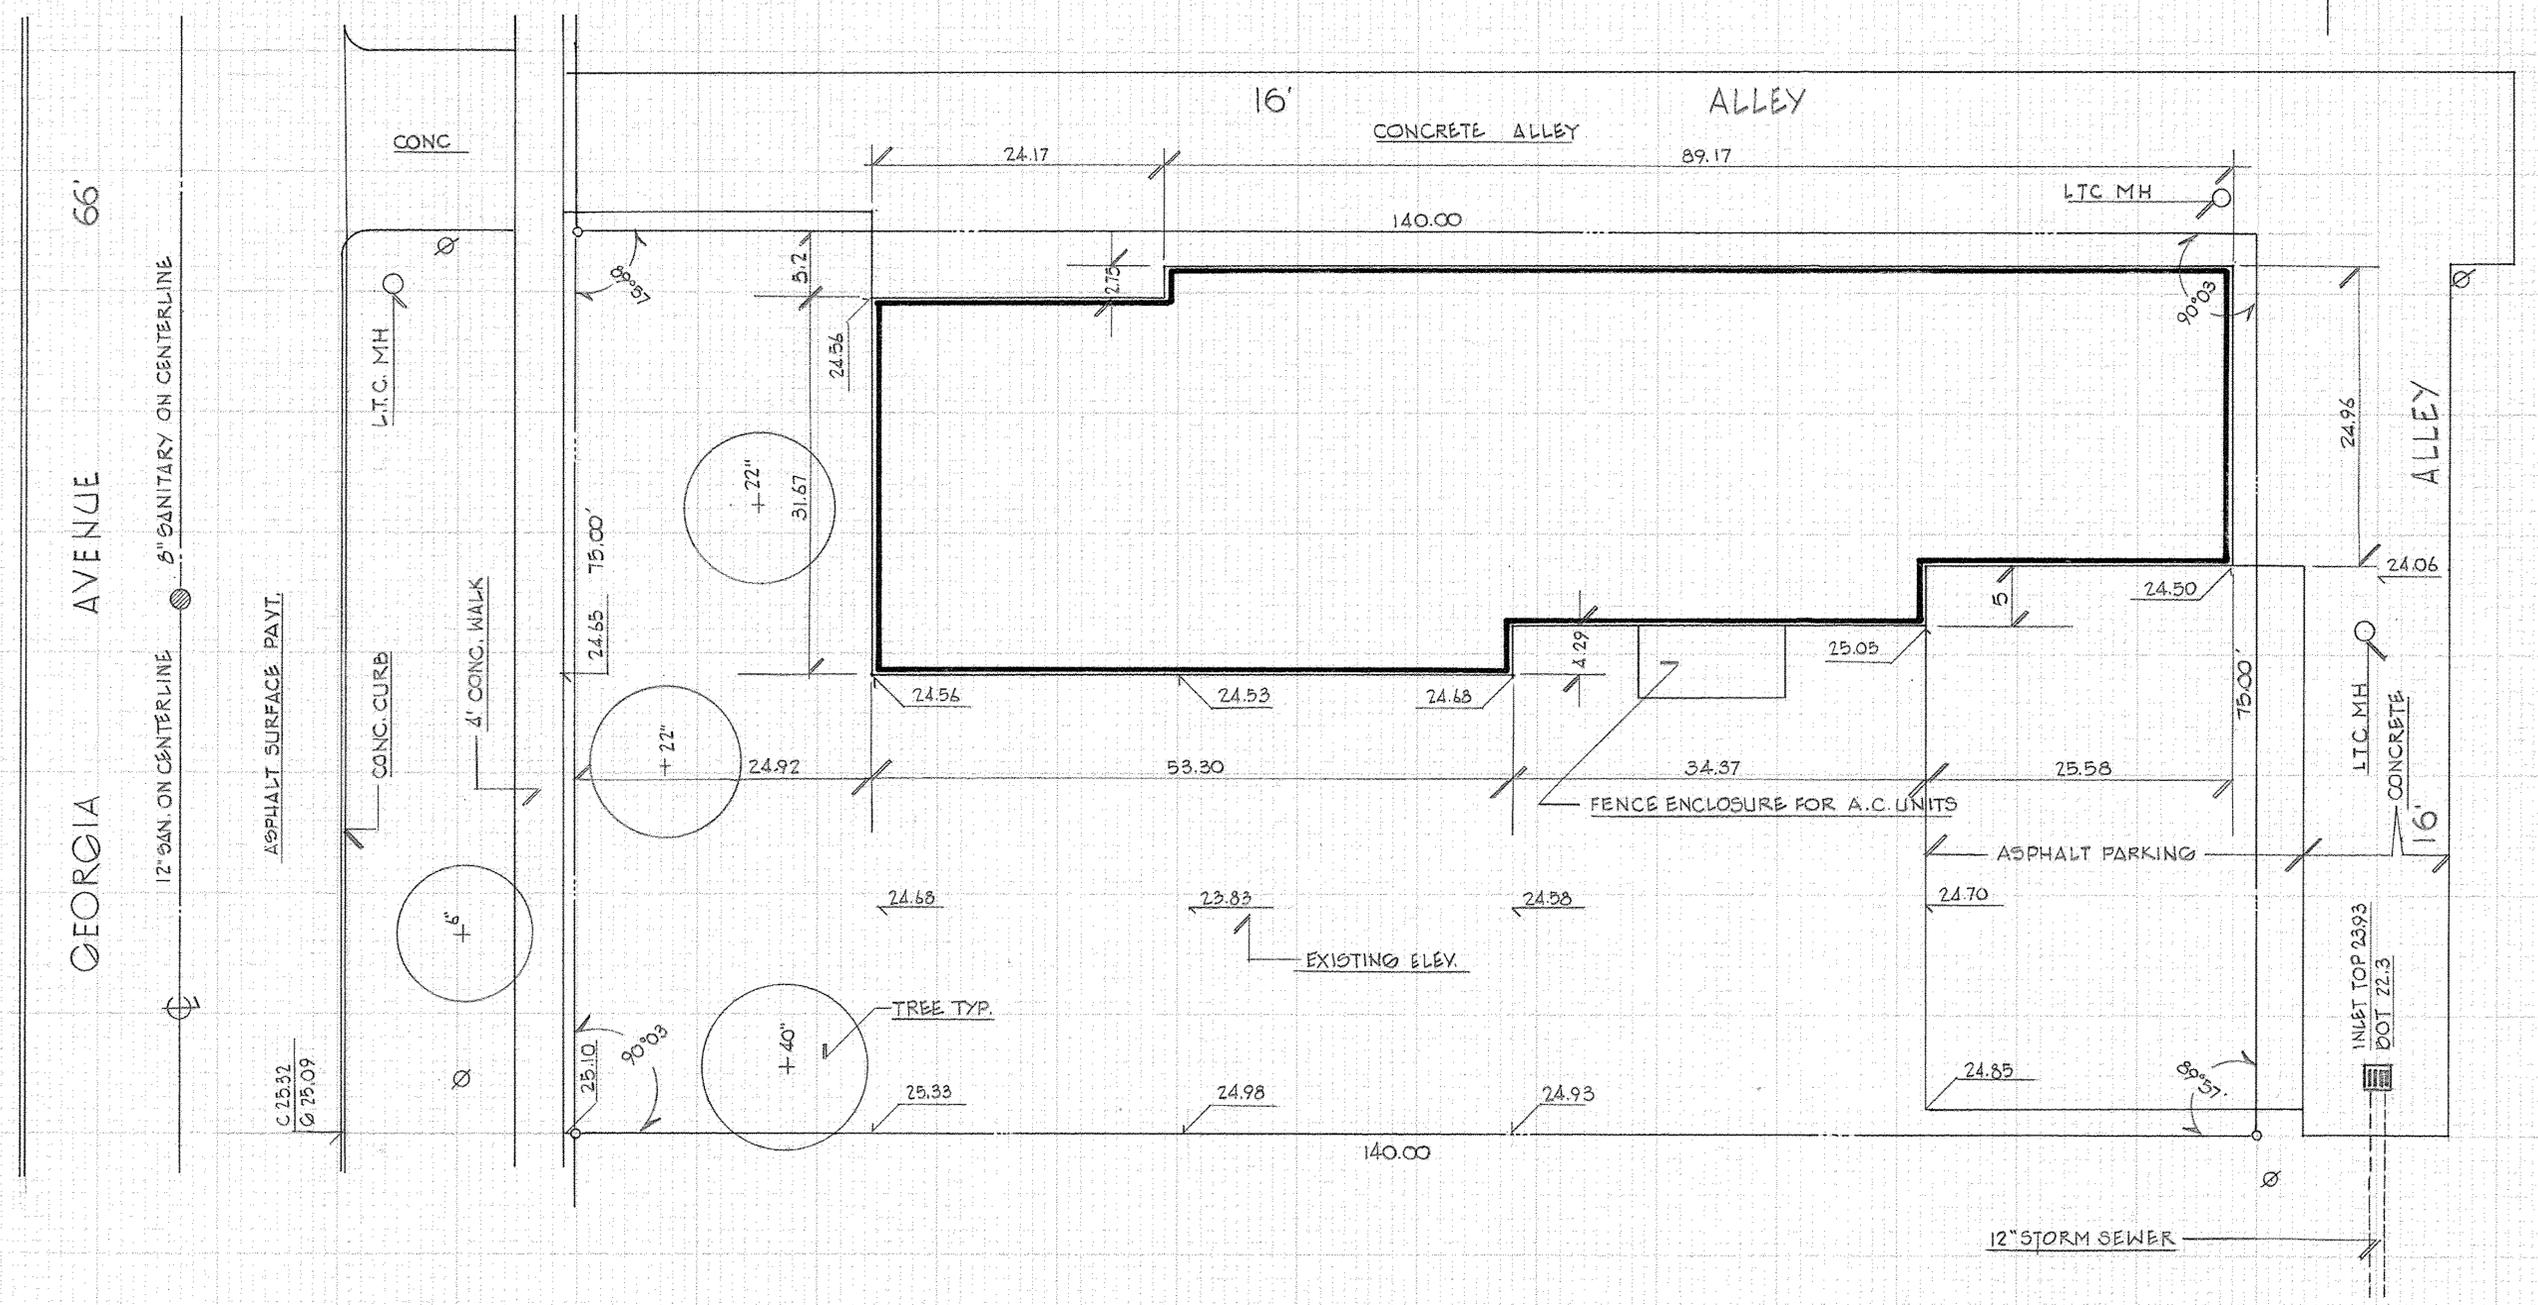


norman hura & assoc
registered surveyor

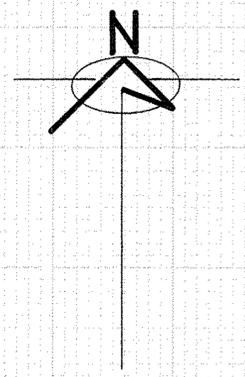

CENTRAL TELEPHONE COMPANY

PPN 2-01-003-107-009 & 010

SUBLOTS 428-429-430 OF FAIRHOME ADDITION
LORAIN OHIO
SCALE 1" = 10'-0"
APRIL 1984