


10-00-025-10A-038
Scan # 47903

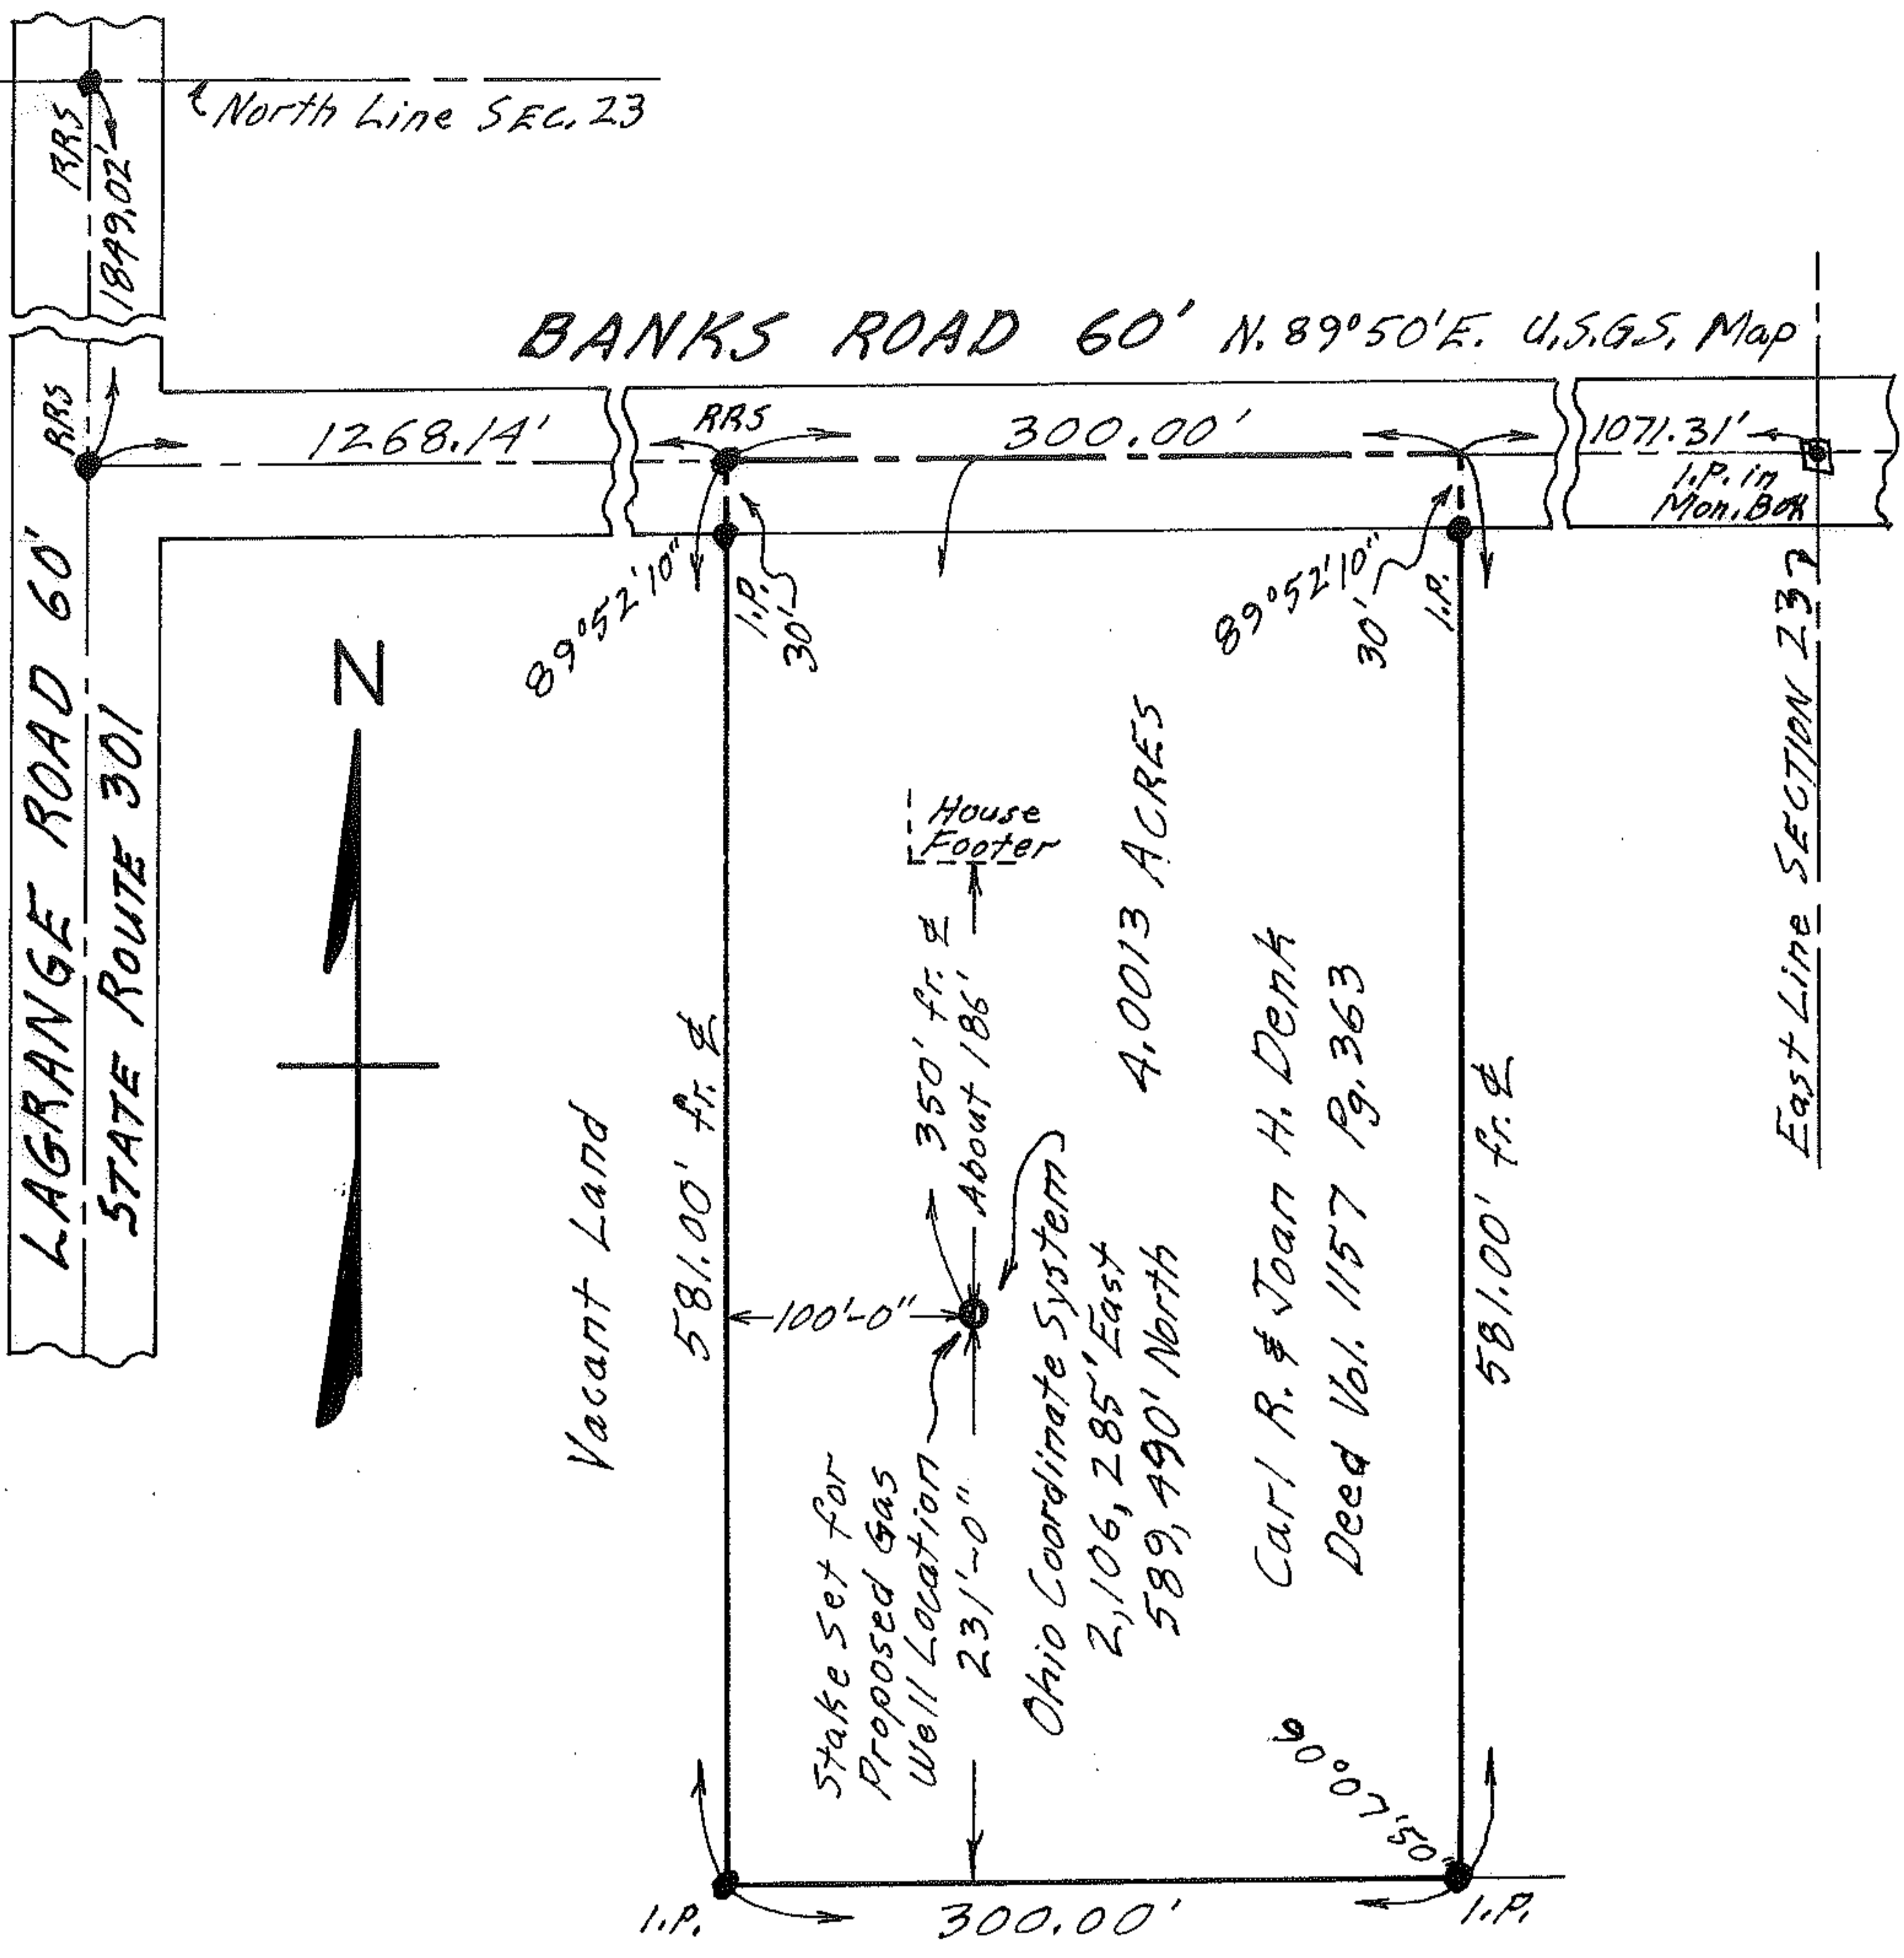

FIELD LOCATION OF PROPOSED GAS WELL SITE
 FOR CARL R. & JOAN H. DENK
 SECTION NO. 23 CARLISLE TOWNSHIP
 LORAIN COUNTY OHIO
 SCALE: 1"=100' SEPTEMBER 30-1976
 Gary E. Penfound Reg. Surveyor No. 4457