

PROPERTY LINE AND LOCATION
SURVEY OF LAND OF CHARLES
E. & SLENA A. DONNEBERG

SECTION NO. 20 - CARLISLE TWP.

LORAIN COUNTY - OHIO

SCALE: 1" = 40'

MAY 13, 1980

S. 50° 38' W. 575.28'
fr. NW Cor. Charles &
Catherine R. Weitzel
D. Vol. 488 Pg. 423


10-00-020-102-125

10-00-020-C
Scan # 47927

U.S. RTE. 20 STATE RTE. 10
OBERLIN - ELYRIA ROAD
262.70'

Formerly R/W of C.S. & C. RAILWAY CO.
240.02'

1.2558 ACRES
after Transfers

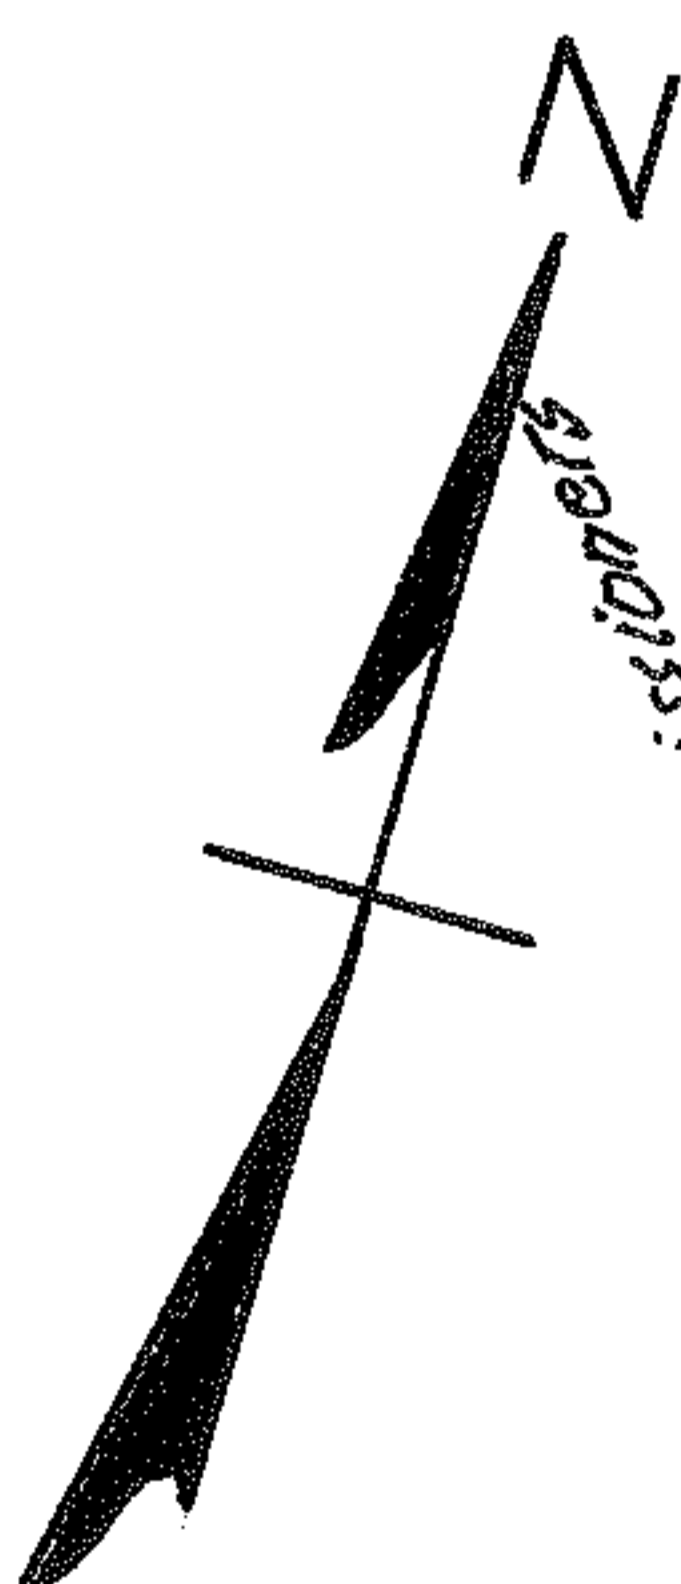

Board of Park Commissioners
of Lorain County Dist. No. 1
of the Lorain Park 169
Metropolitan Pg. 145
D. Vol. 989 Pg. 2690
S. 42° 16' 90"
S. 42° 18' 90"

Slag Drive

BARN
42'-2"
42'-3"

BARN
20'-2"
5'-10"

NOTES:

- indicates iron pin set.
- indicates iron pin found.
- No buildings occupy any part of land to be conveyed or acquired.

Gary E. Penfound
Reg. Surveyor No. 4457

N. 68° 43' 10" E.
L.C.M.P.D.
D. Vol. 999 Pg. 216

